



MIDSHIP SECTION

of
SHIP N^o 43
Scale $\frac{1}{2}$ in = 1 foot


Length between Perpendiculars 181' 0"
Breadth Extreme 32' 0"
Depth in Hold 19' 6"
Tonnage under M.D. 723
do in Register 71

24th Nov 1868

Tonbridge

Rev 26/11/68 & 25/10/69

HA

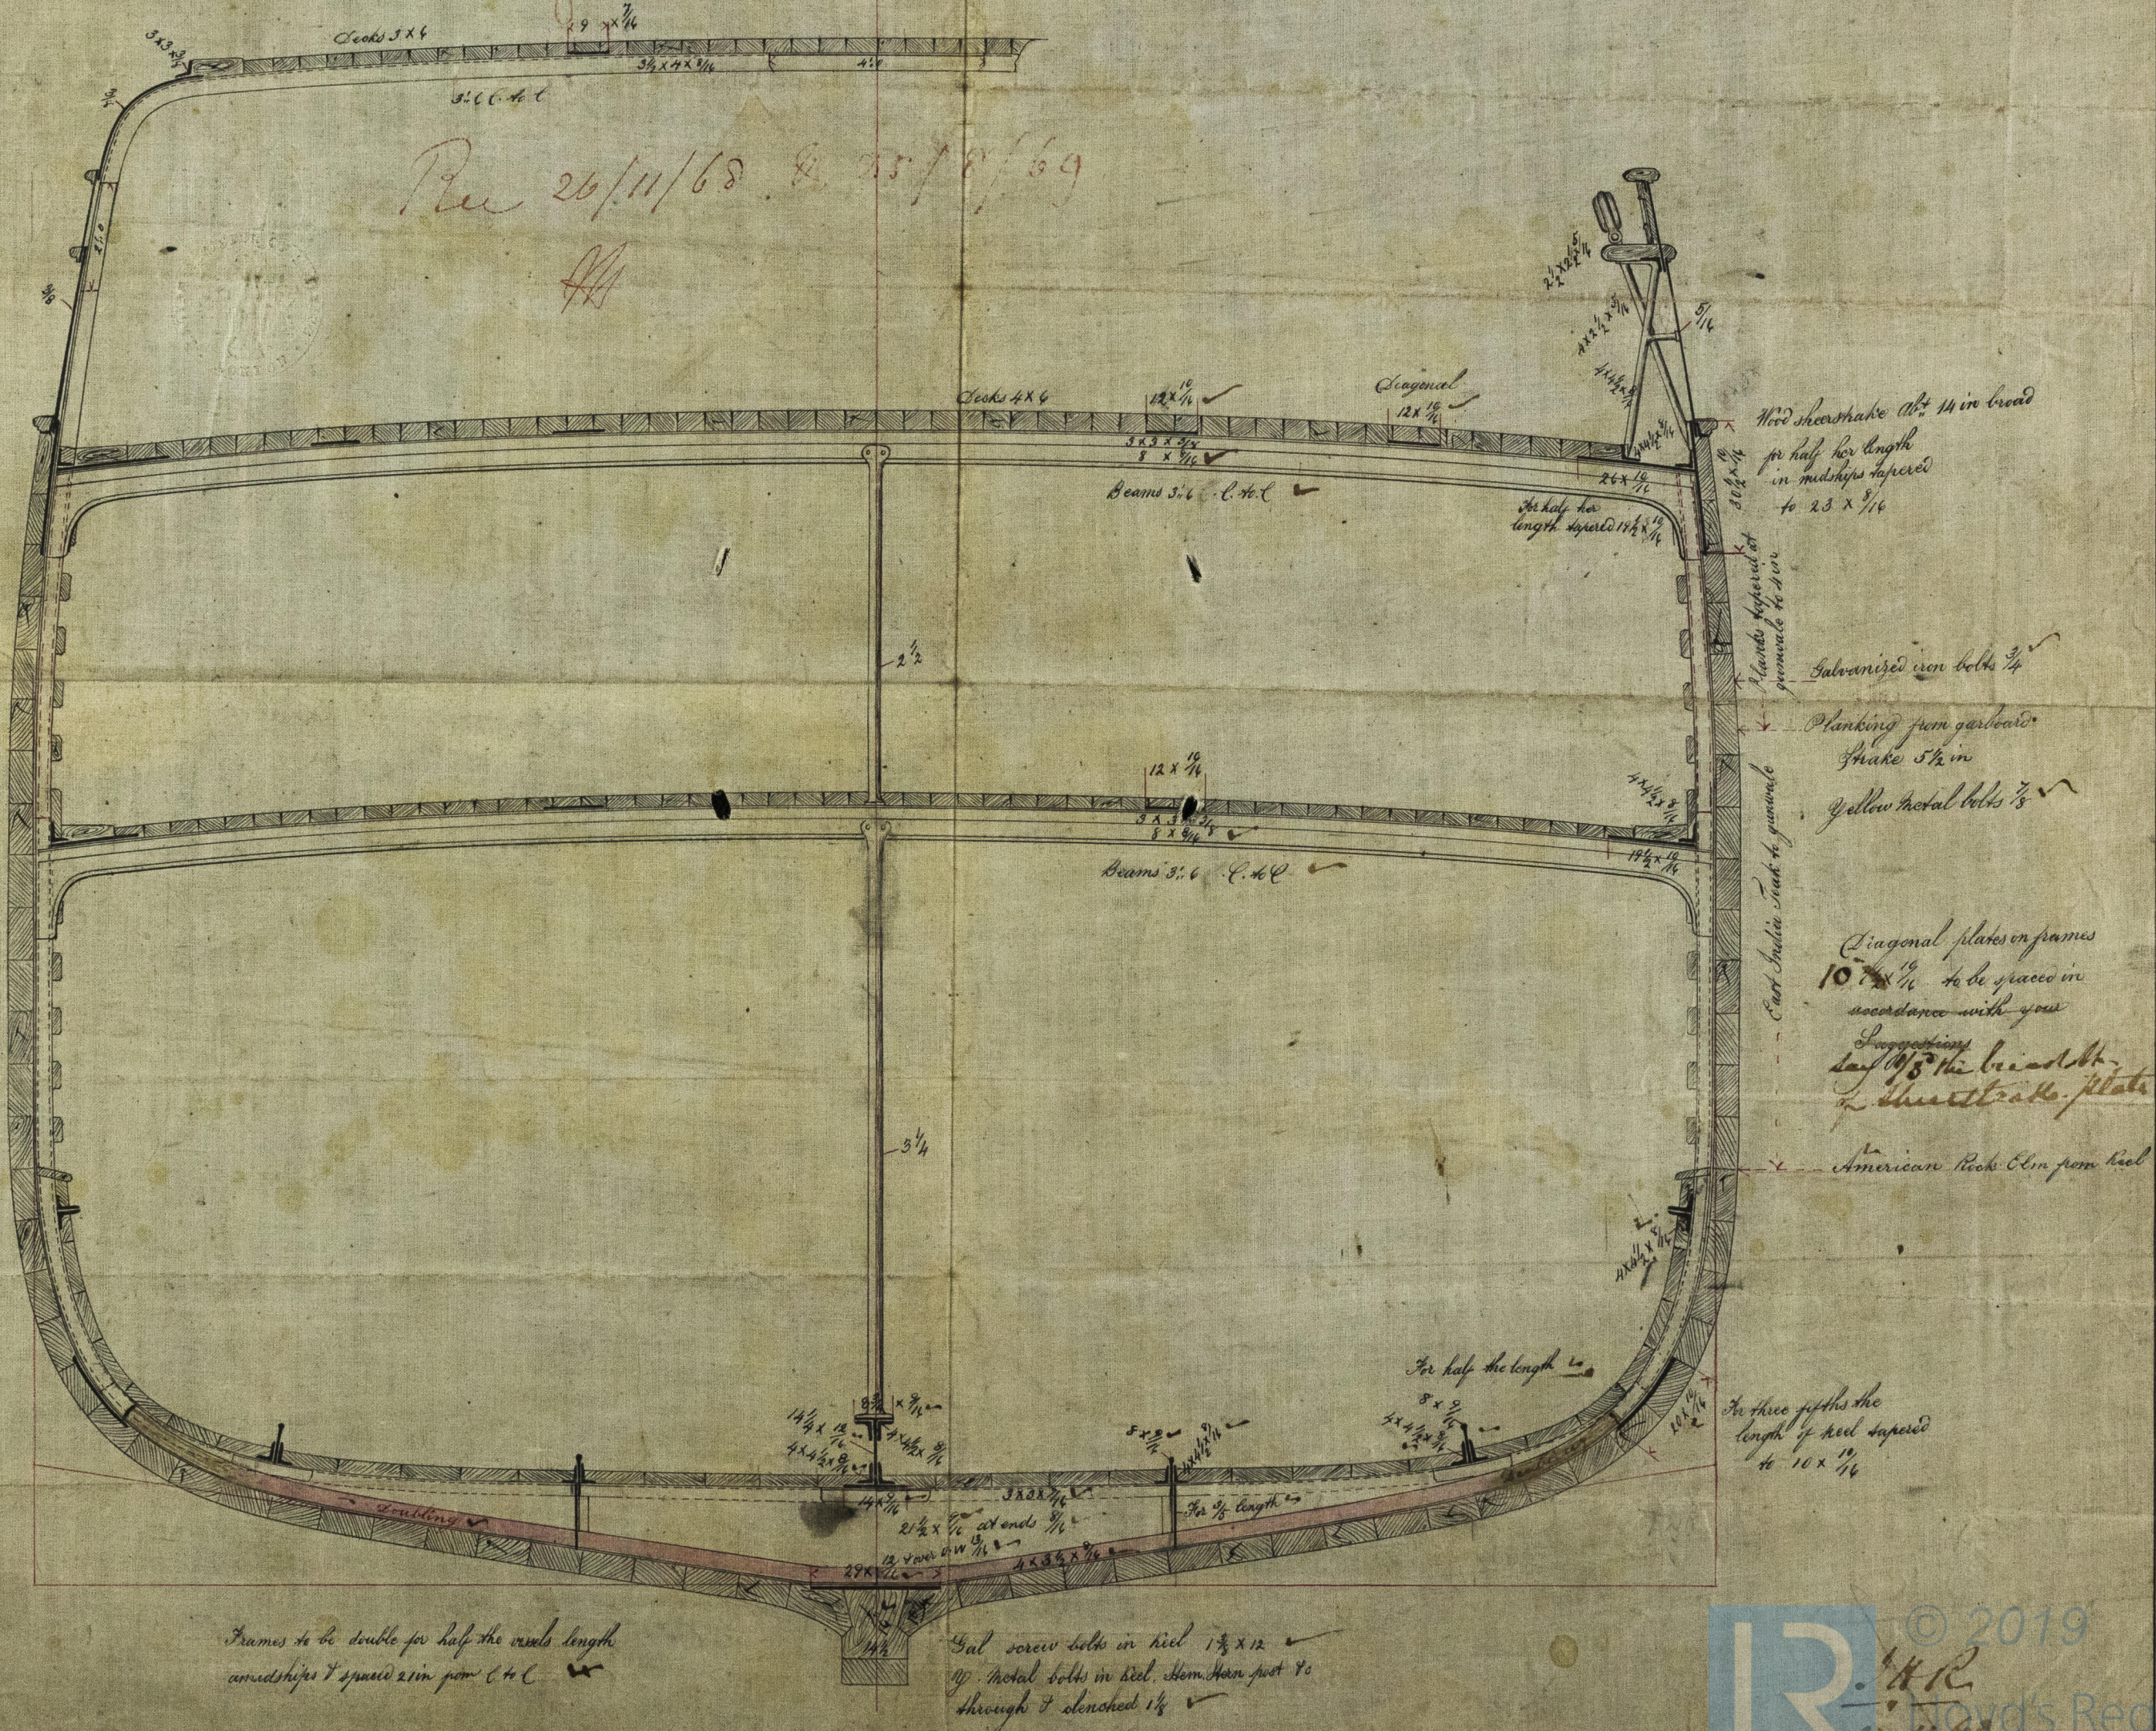

Frames to be double for half the vessel length
arranged & spaced 21 in from C.L.

Gal screw bolts in keel $1\frac{1}{2}$ x 12
10 metal bolts in keel, from stern post & through & clenched $1\frac{1}{2}$