

Proteus


S.S. N° 56

Length between perpendiculars	191.0
Breadth moulded	27.8
do Extreme	28.62
Depth moulded	19.6
do in Hold	18.6


Tonnage under main deck	616.37
do in fore-castle	33.09
do break	34.64
do gross	684.10

Scale $\frac{1}{2}$ in. = 1 foot

13/5/73

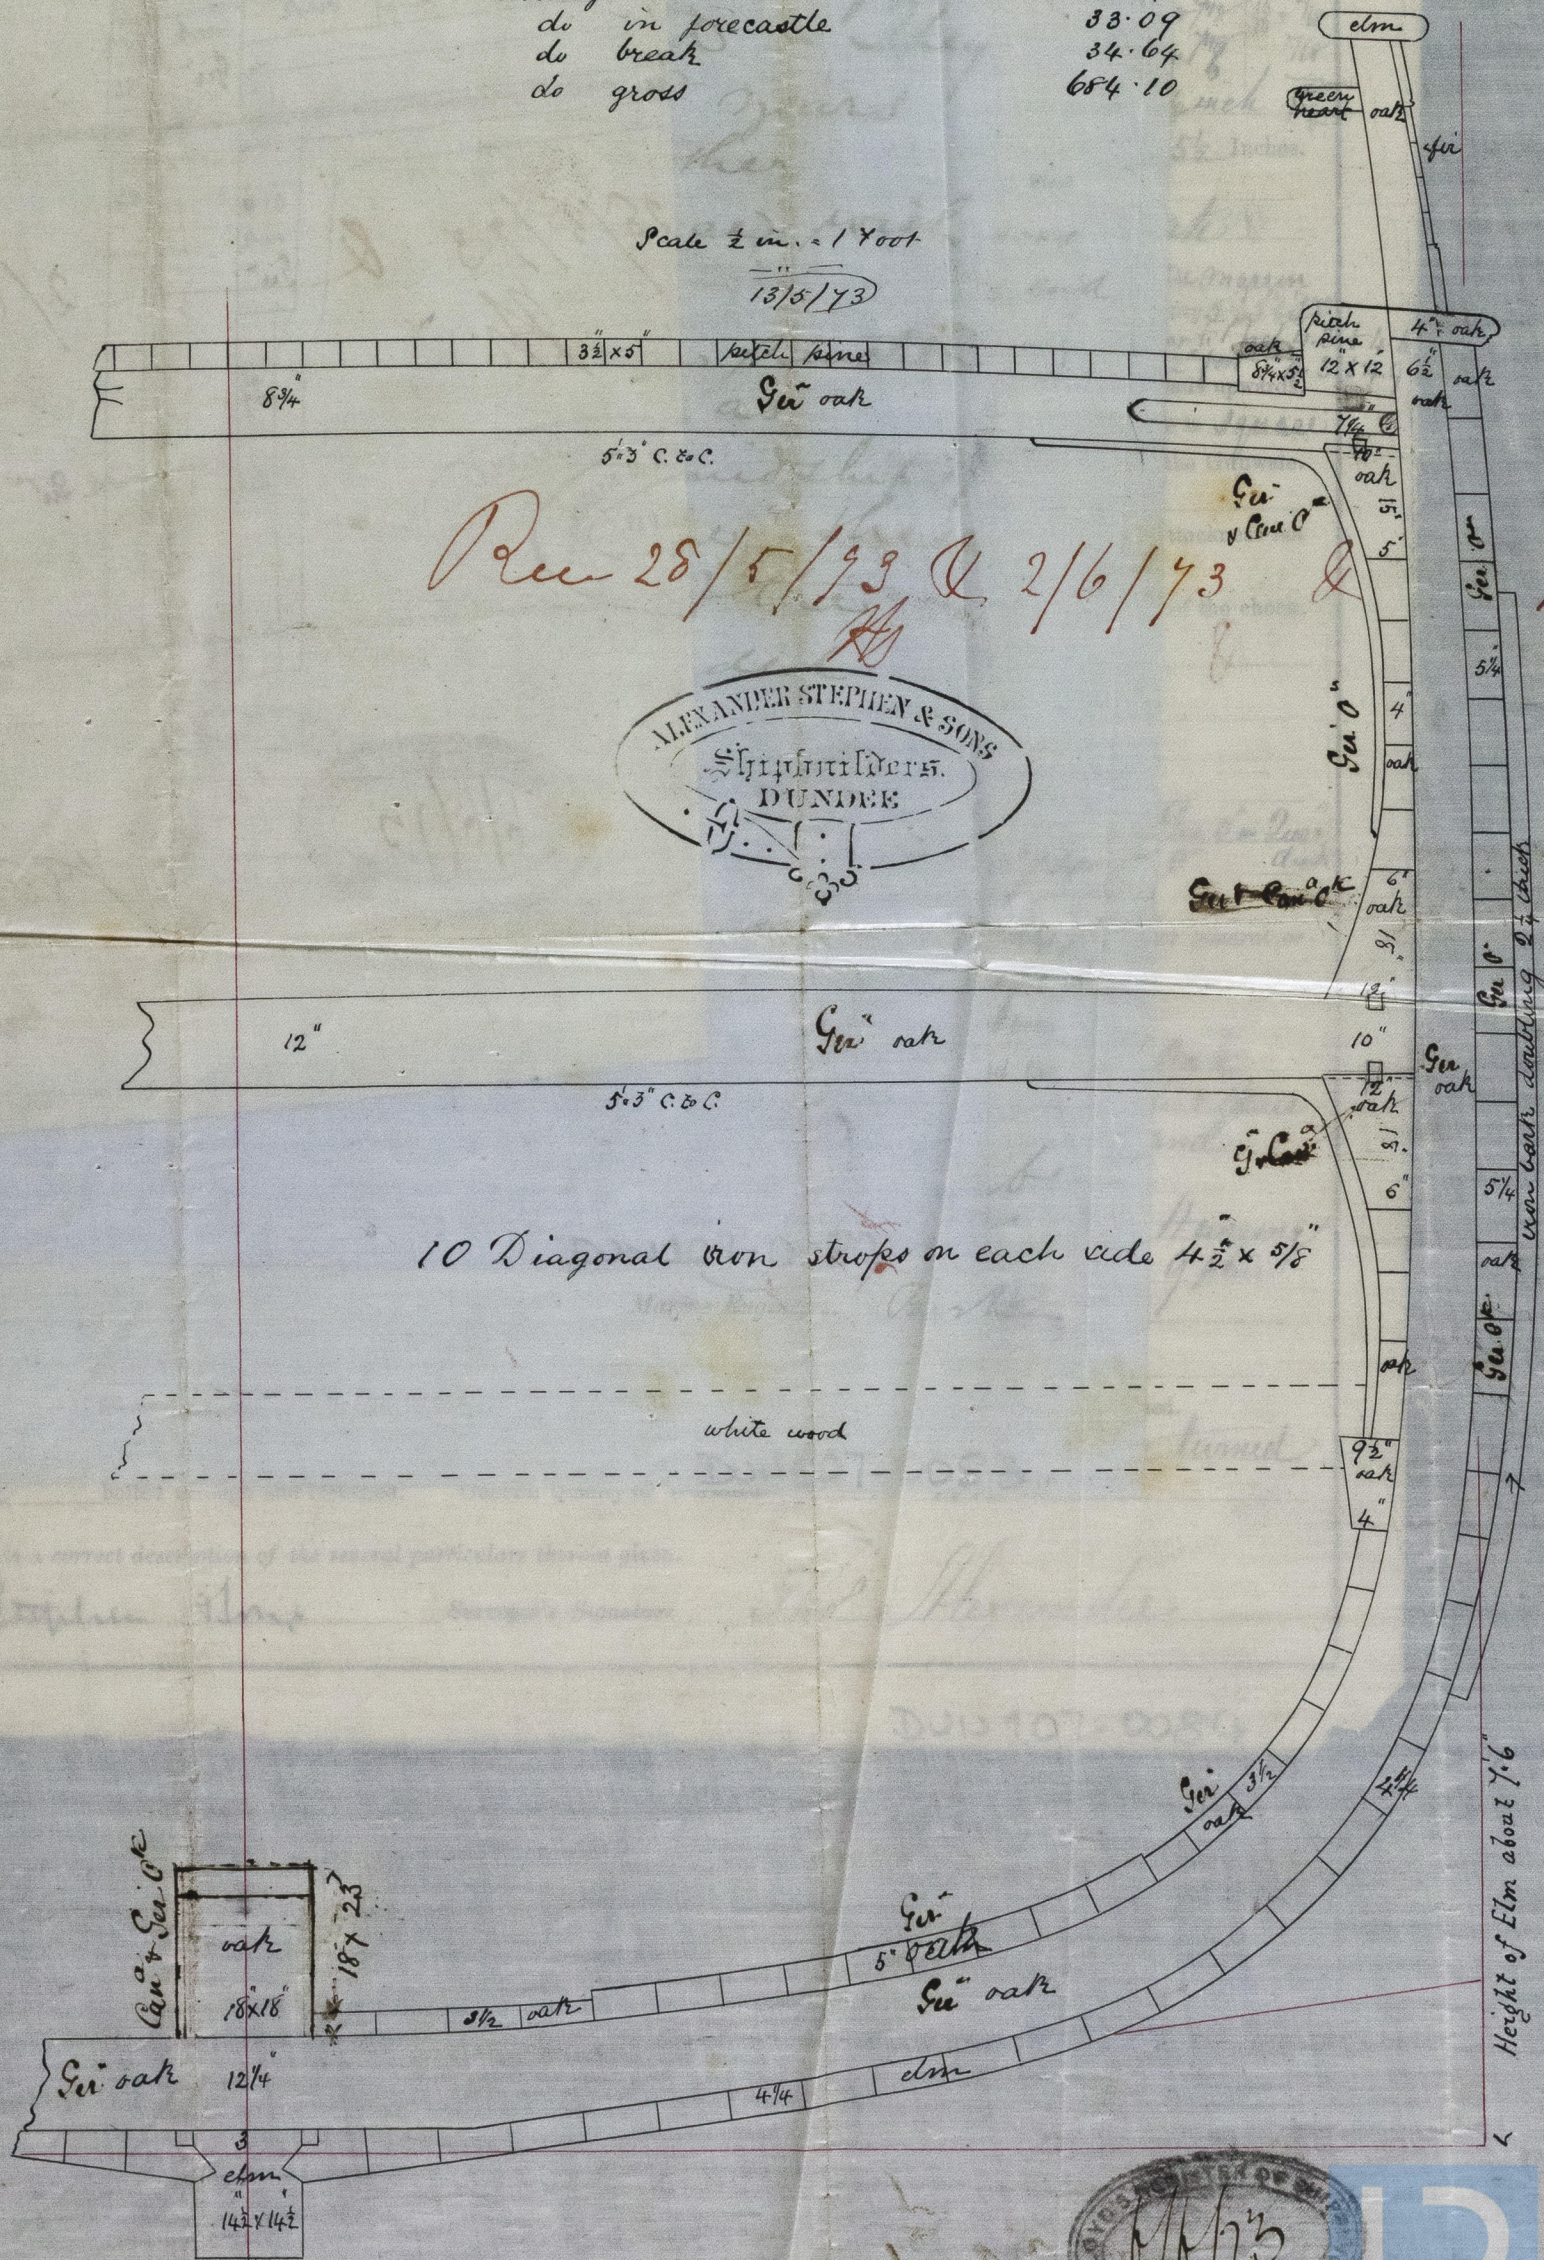

Recd 28/5/93 & 2/6/73

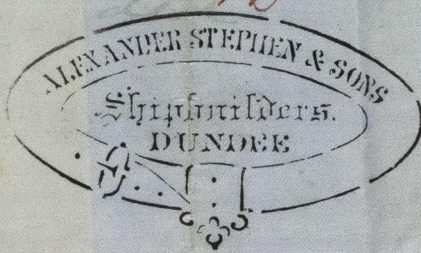


16/8/73

10 Diagonal iron struts on each side $4\frac{1}{2} \times 5\frac{1}{8}$

white wood

Height of Elm about 7.6

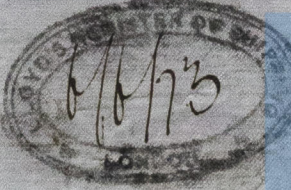



DUN107-0080