
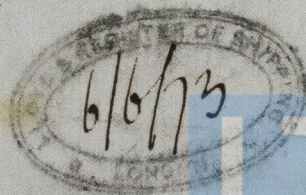
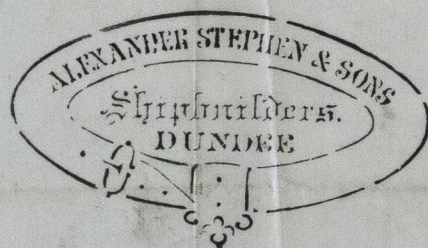


# Proteus

Section of Quarter Deck

S.S. N° 56

Scale 1 in. = 1 foot

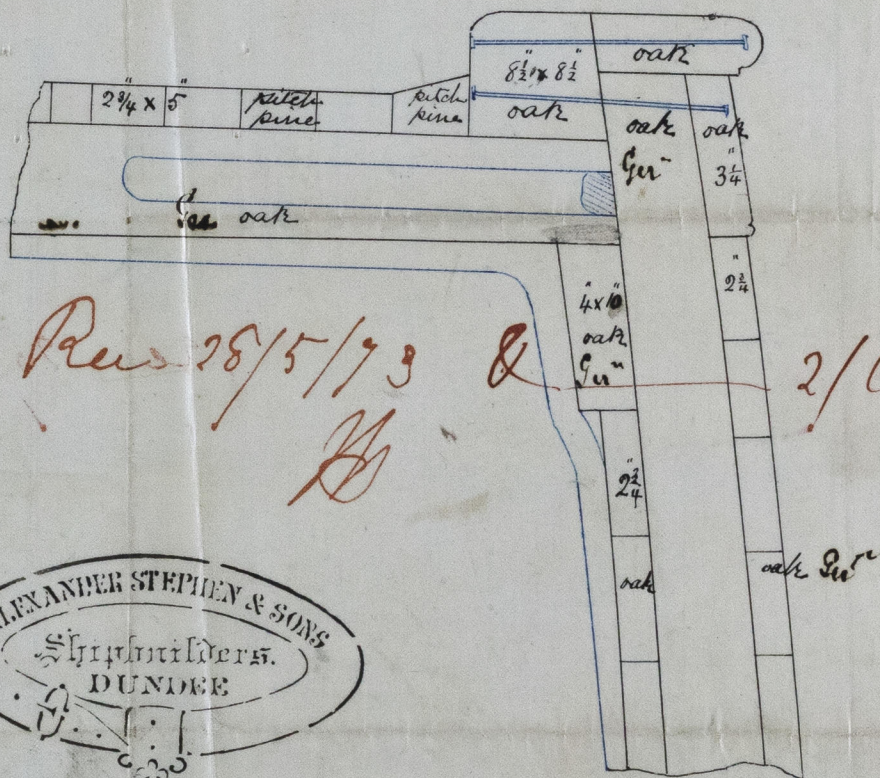

© 1873

Lloyd's Register  
Foundation

DUN107-0081