


SECTIONAL VIEW OF IRON KEELSON PROPOSED TO BE PUT INTO  
WOODEN SHIP NOW DOCKED AT TAYPORT

BY James Mitchell.

Tonnage 600  
Length 178 x 29.2 x 17.11

Rec 5/3/75  
H.

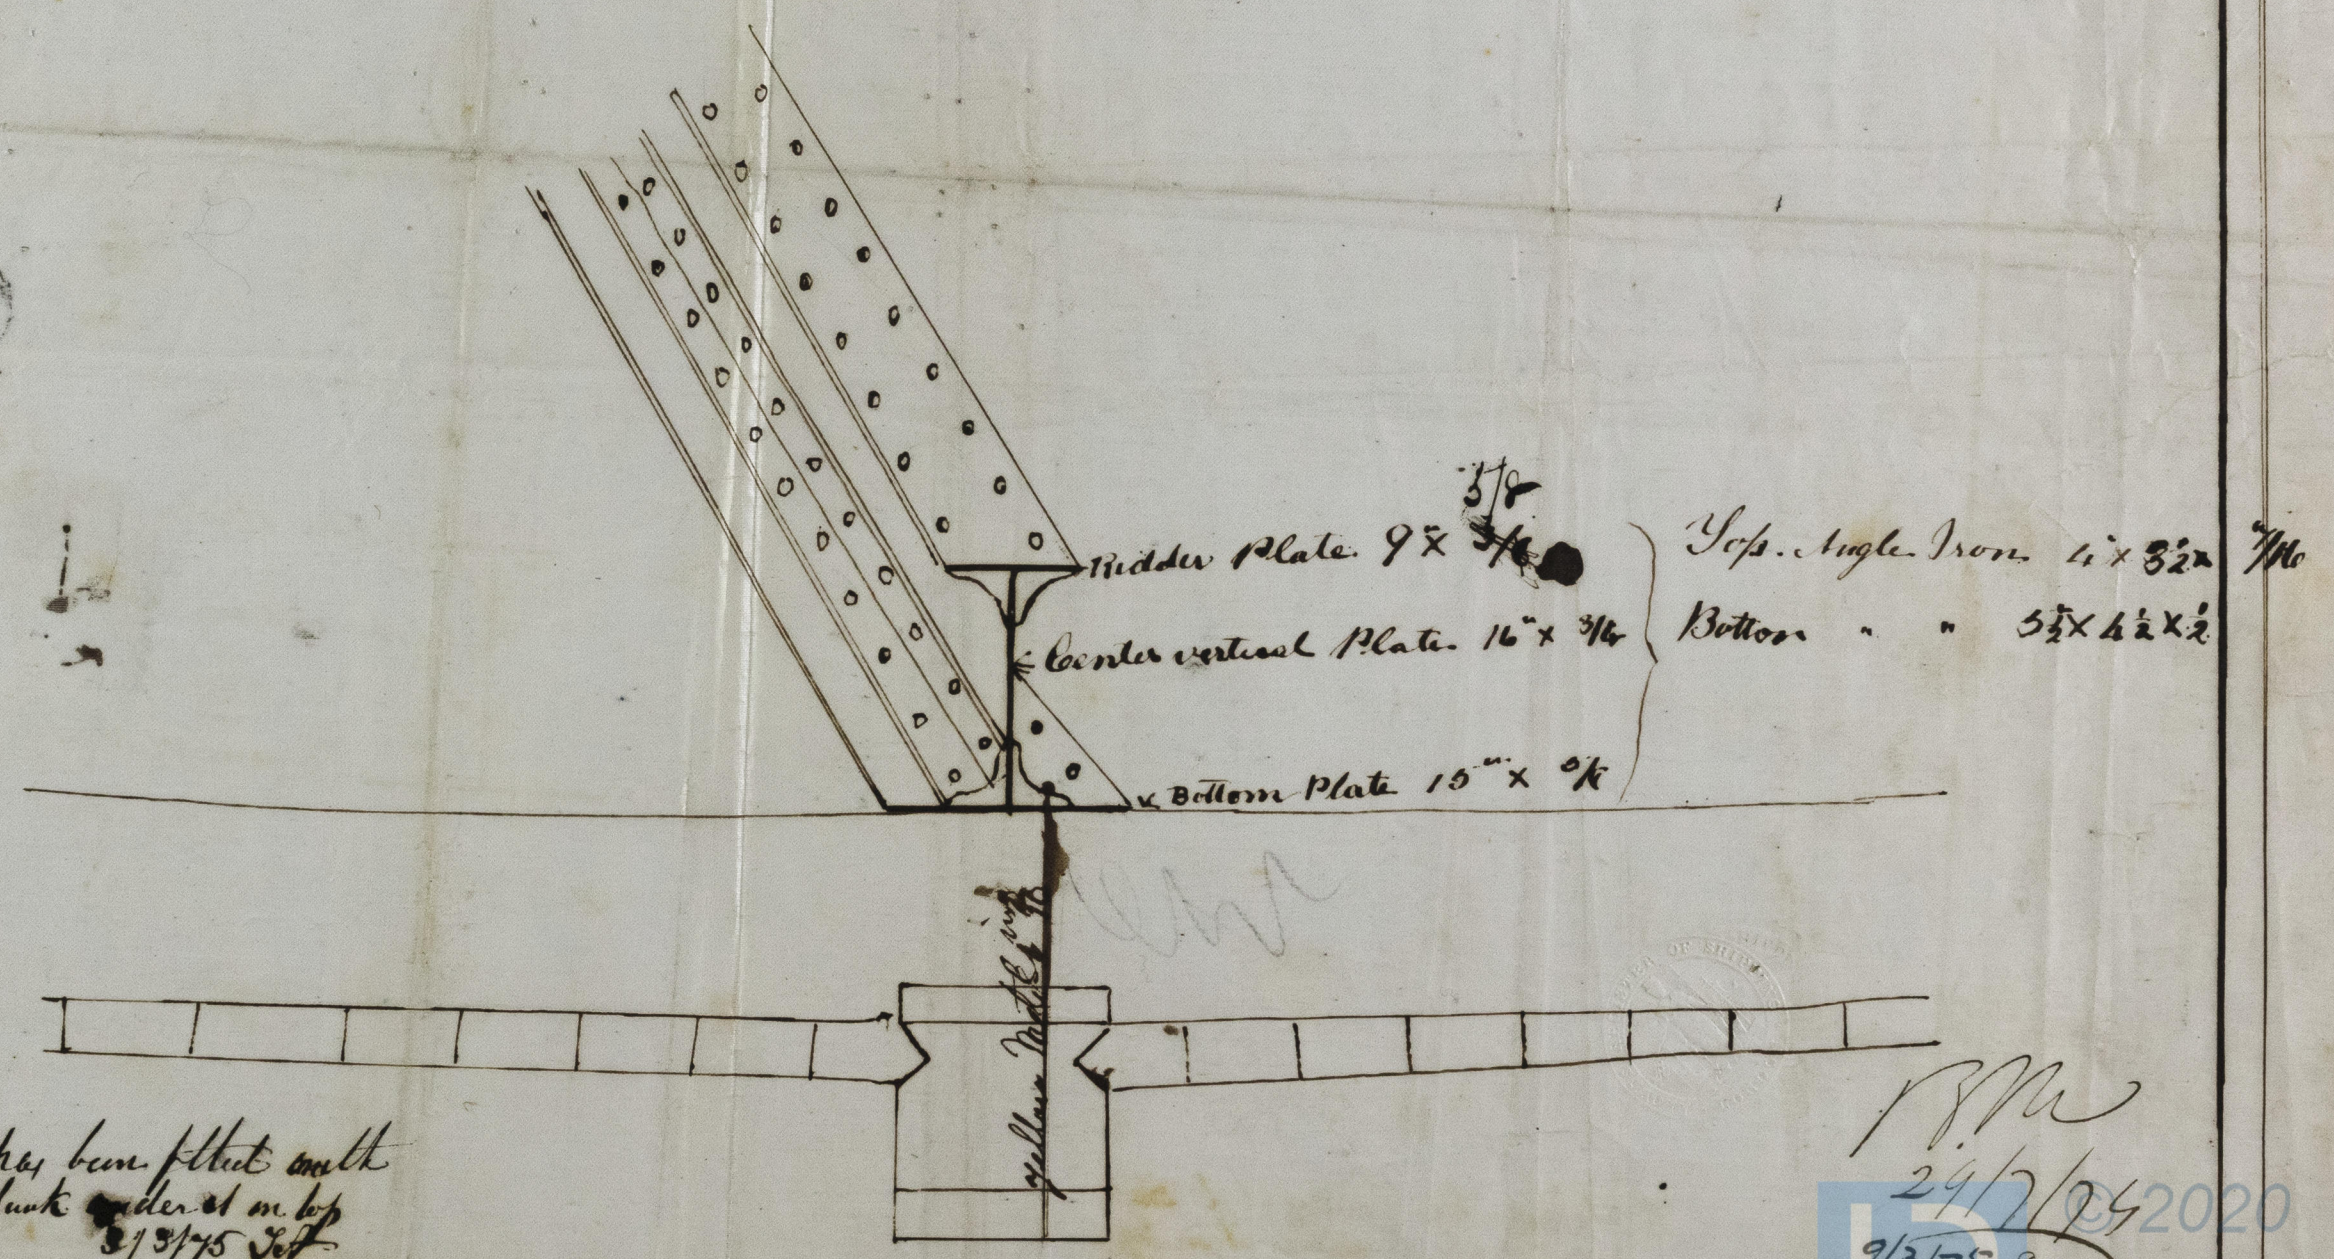

Keelson has been fitted with  
a 3 1/2 plank under it on top  
of floor 3/3/75 J.M.

J.M.  
24/7/2020  
9/3/75