

Midship Section of Ship Building at Fayport
By J. Mitchell

Dec 19/6/74

Scale. $\frac{3}{4}$ of 1 inch to 1 foot

Dec 19/6/74
Jch

Rec 5/3/75

Length from front of stern to after part of stern post

178 feet


About 600 tons register

Extreme Breadth 29 feet 3 in.

To Class 11-A,

cc 8 for 11 with You Salt & Roof

Depth from top of lumber strake 17 feet 11 in

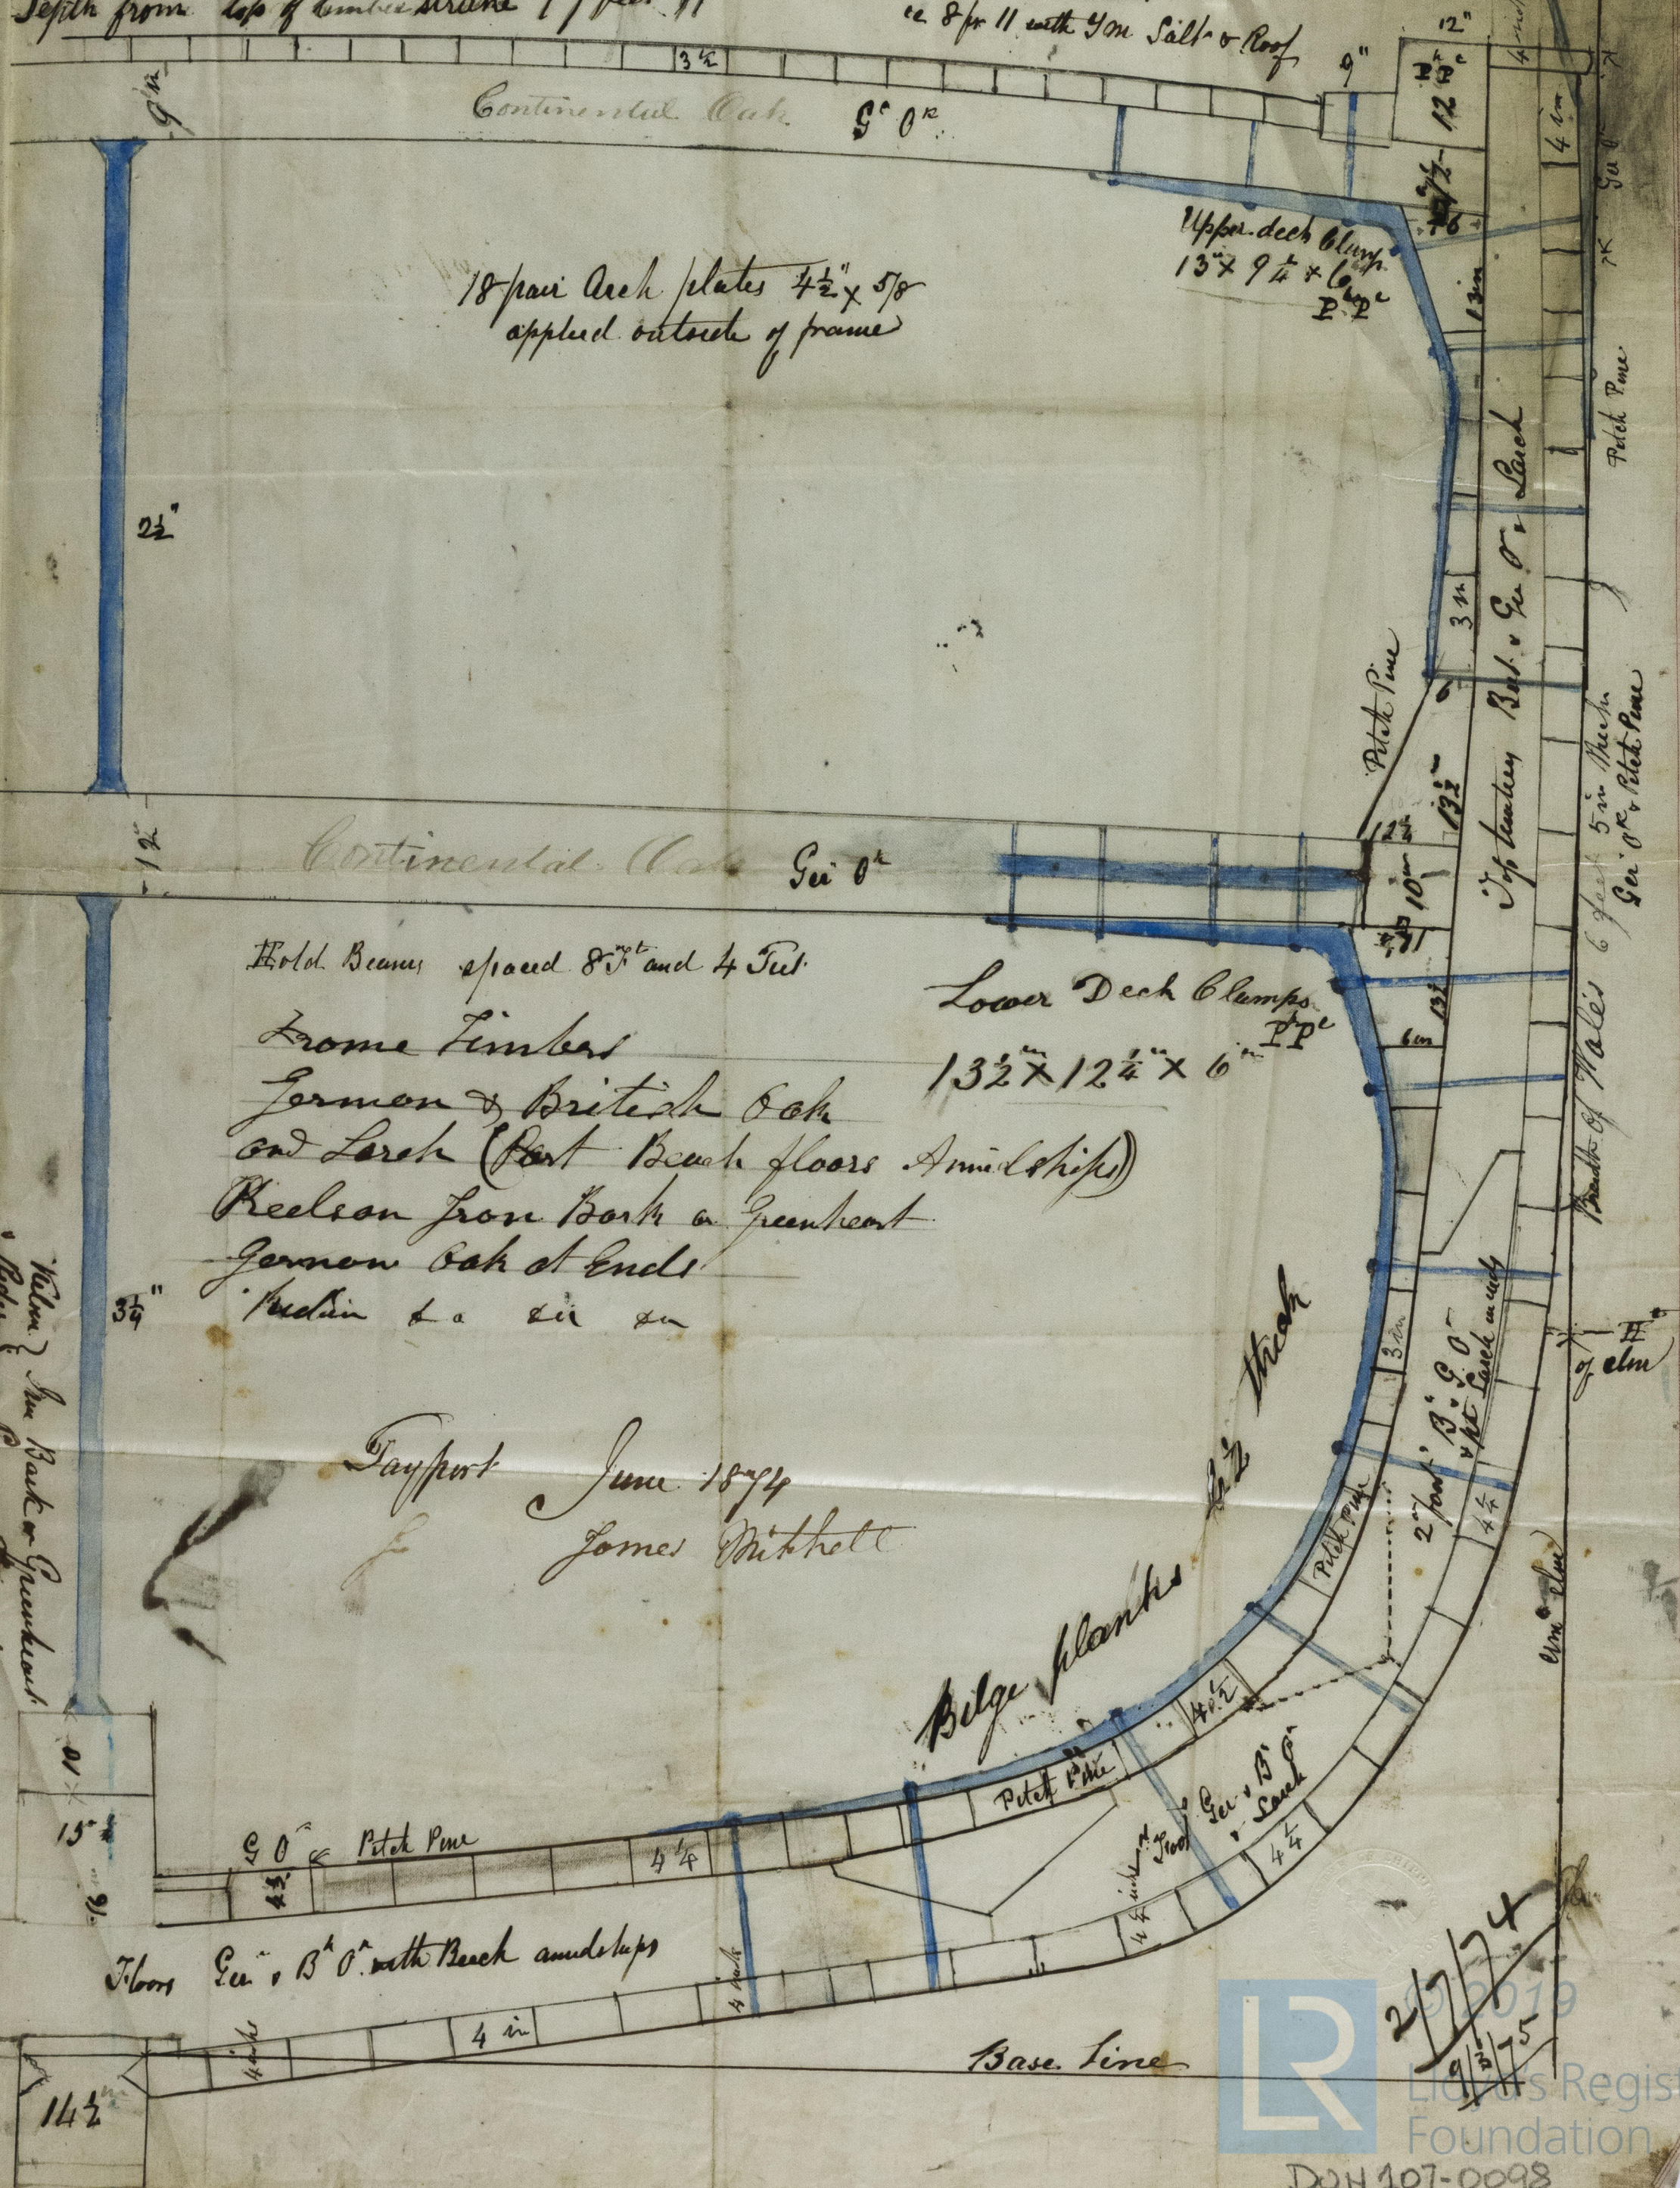

Holb Beans sowed 8th and 4 Feb.

From Limber

German & British Oak

and Larch (Part Beach floors. Amidships)

Keelson from Bark on Greenheart

German Oak at End 1

Section La Lii Lu

Lower Deck Clumps.

$$13\frac{1}{2} \times 12\frac{1}{4} \times 6$$

Dayport

June 1894

James Mitchell

Bidge plankton

Flora Gu^o, B^h O^h with Beech and oaks

Base Line

DON 107-0098