

Midship Section for Wood Lightship "Abertary"

of about 120 Tons for River Tay. month

To class 15 Years A1. as a Light Ship.

Dundee Regt No.  
4093.




10/2/77

12 years Timber Material.  
2 - " Fastenings.  
1 - " Salt.  
15 Years A1.

Per 9/2/77

Scantlings and Fastenings as required for  
the 200 Tons Scale. Except Wale which are  
to be  $\frac{1}{2}$  inch thicker.

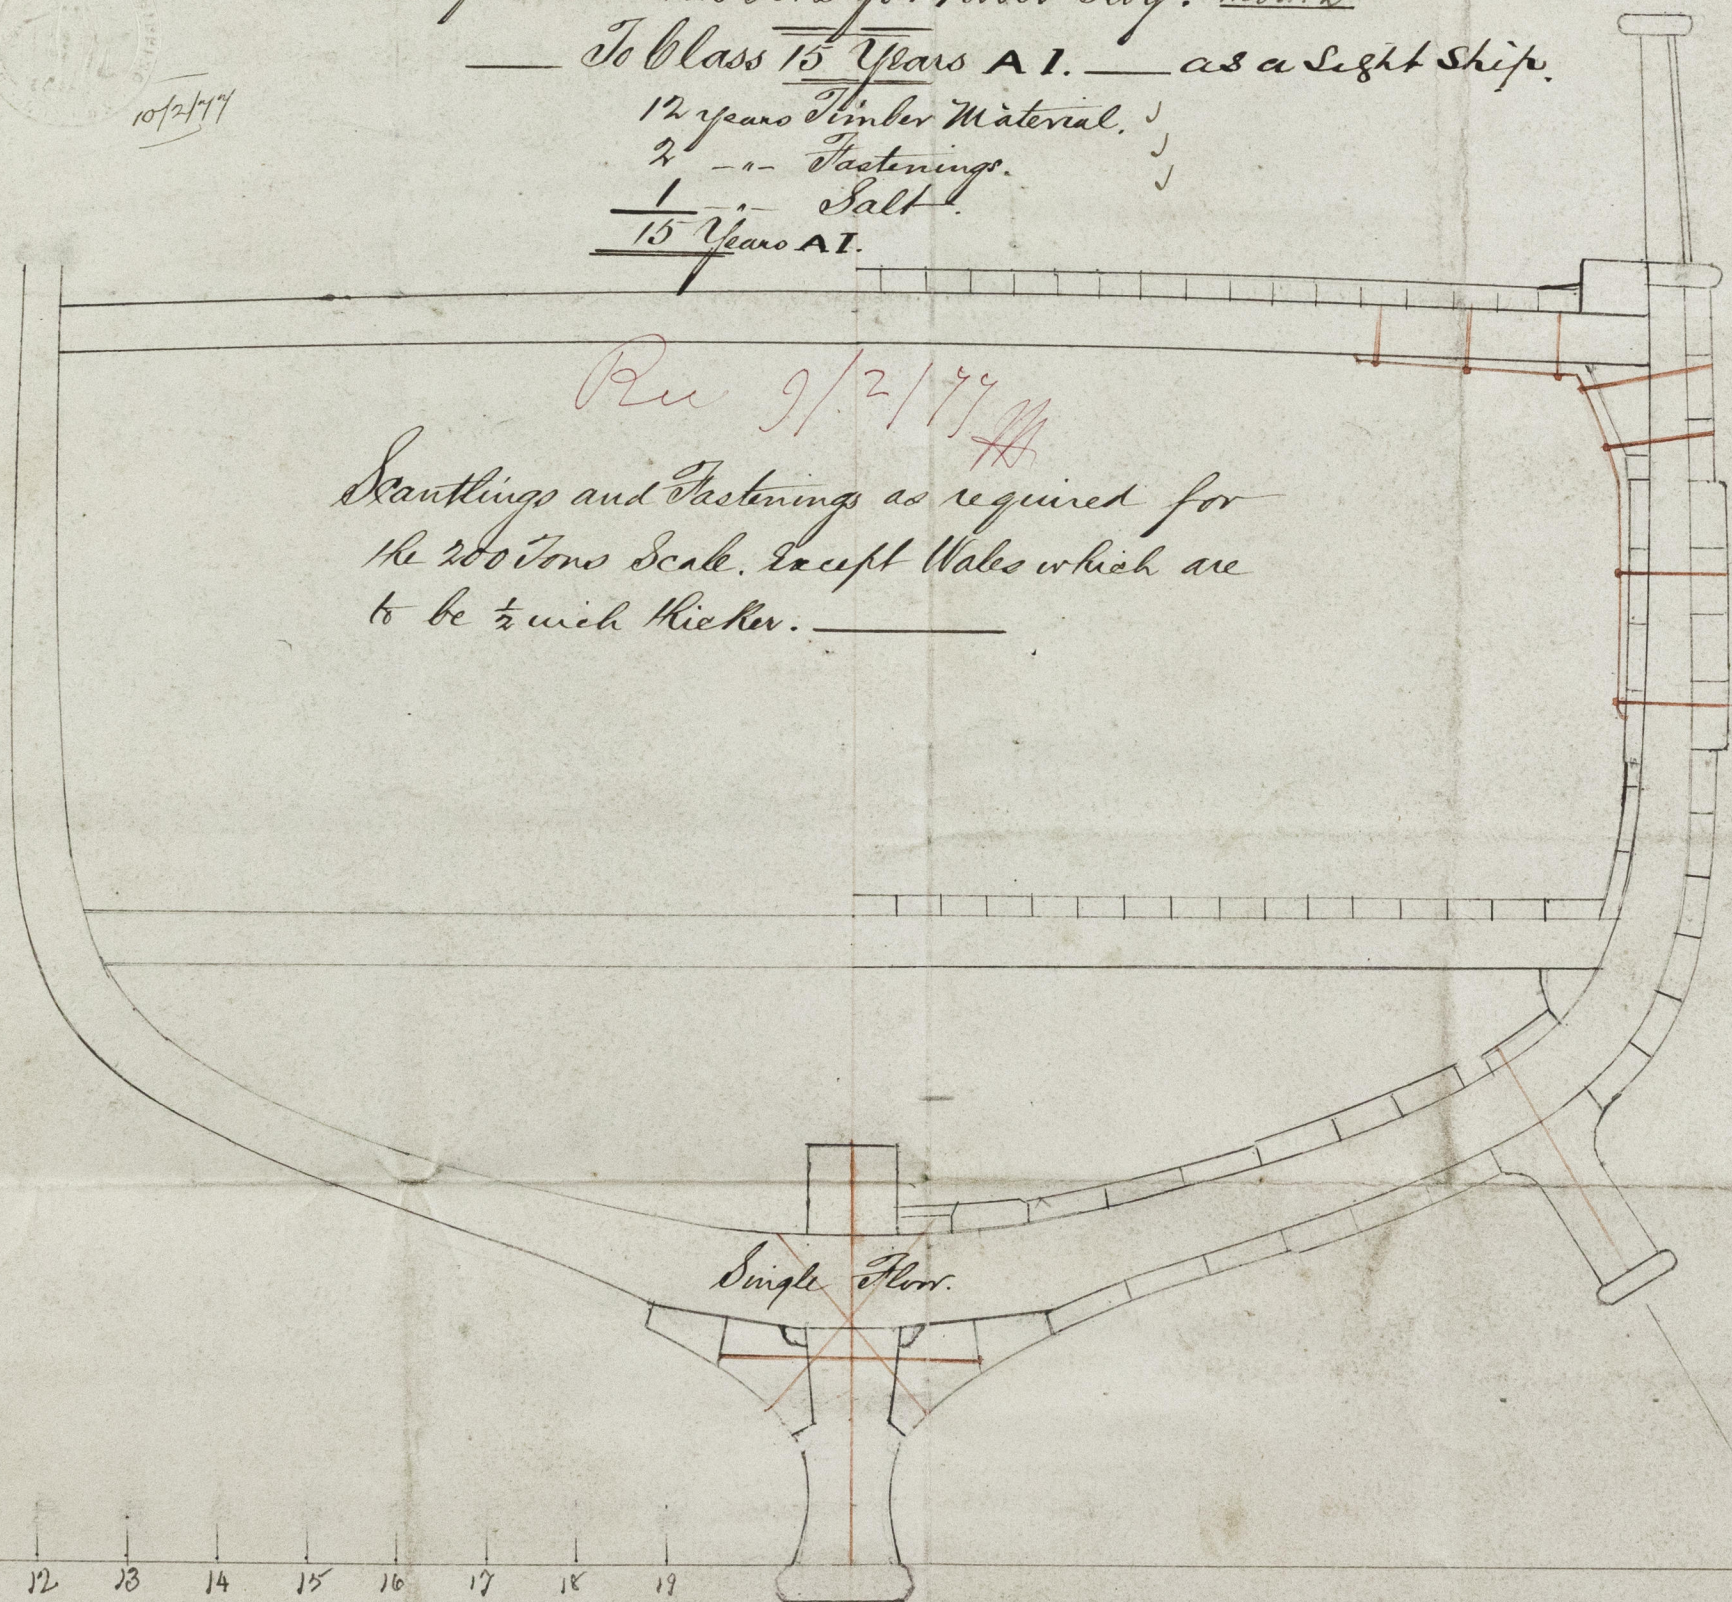

Single Floor.

Scale =  $\frac{1}{2}$  inch to the foot.

18. M. © 2019

10/2/77

Lloyd's Register  
Foundation

DUN107-0125