
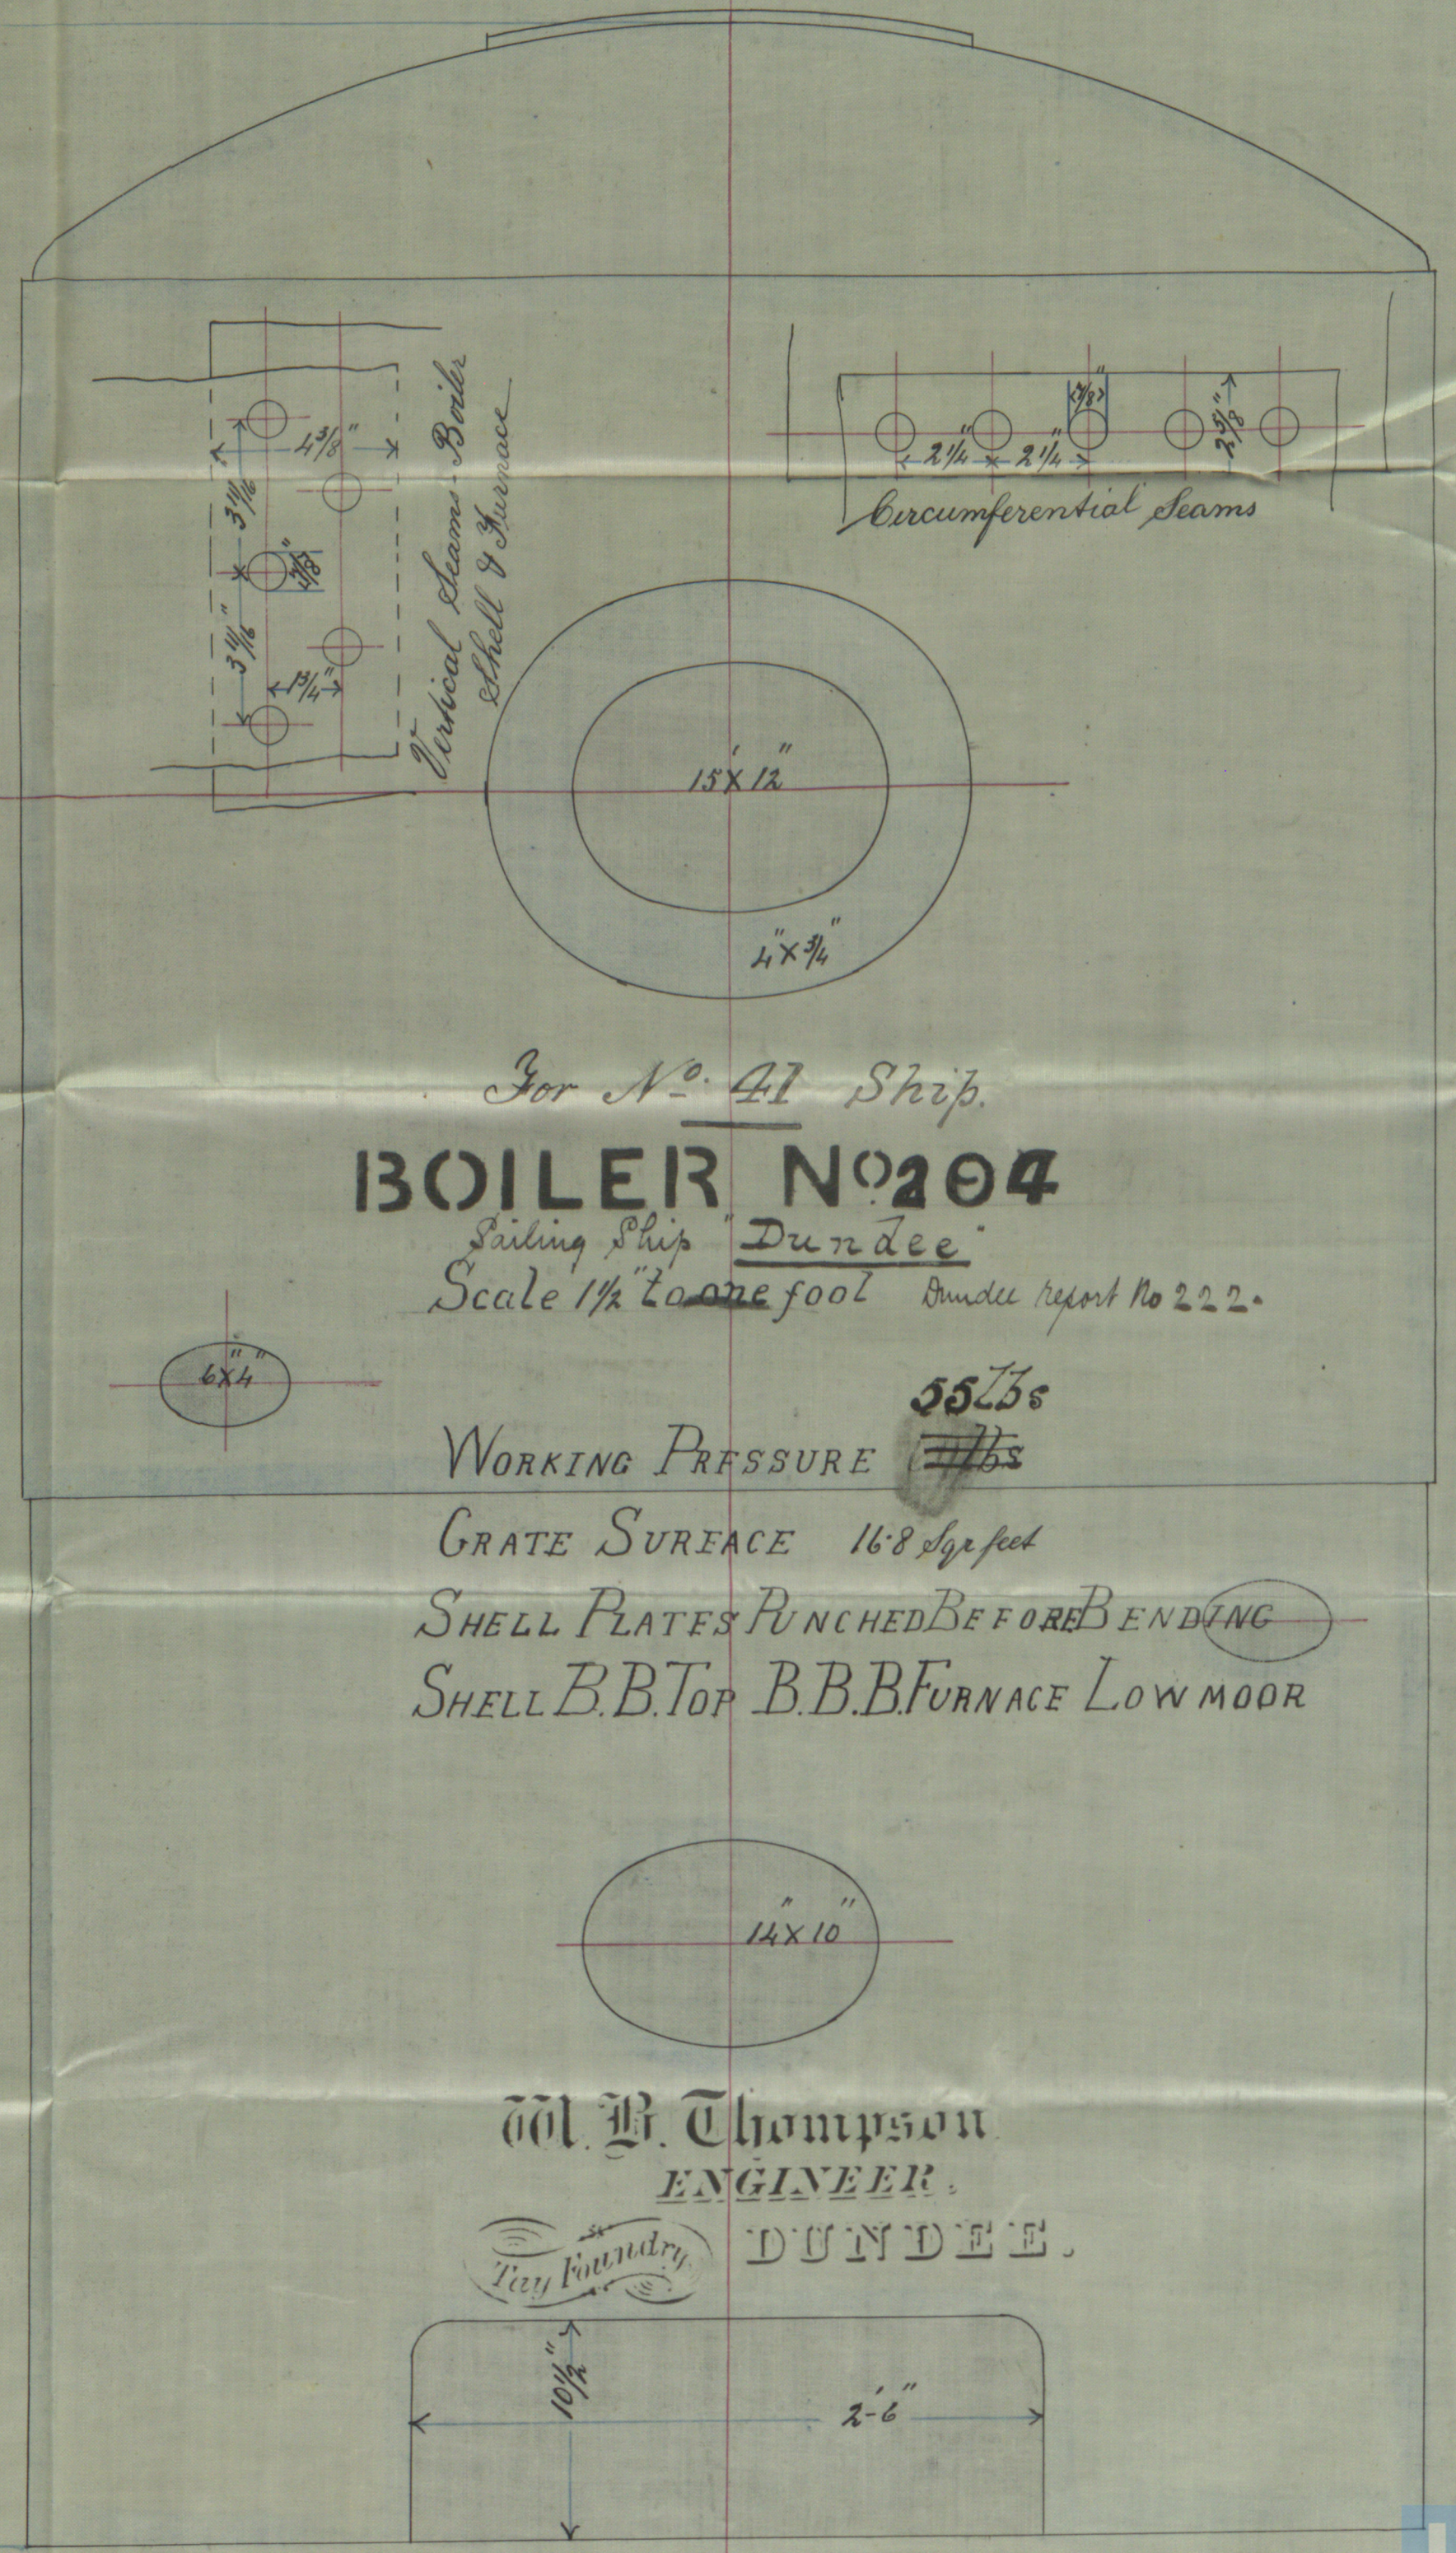
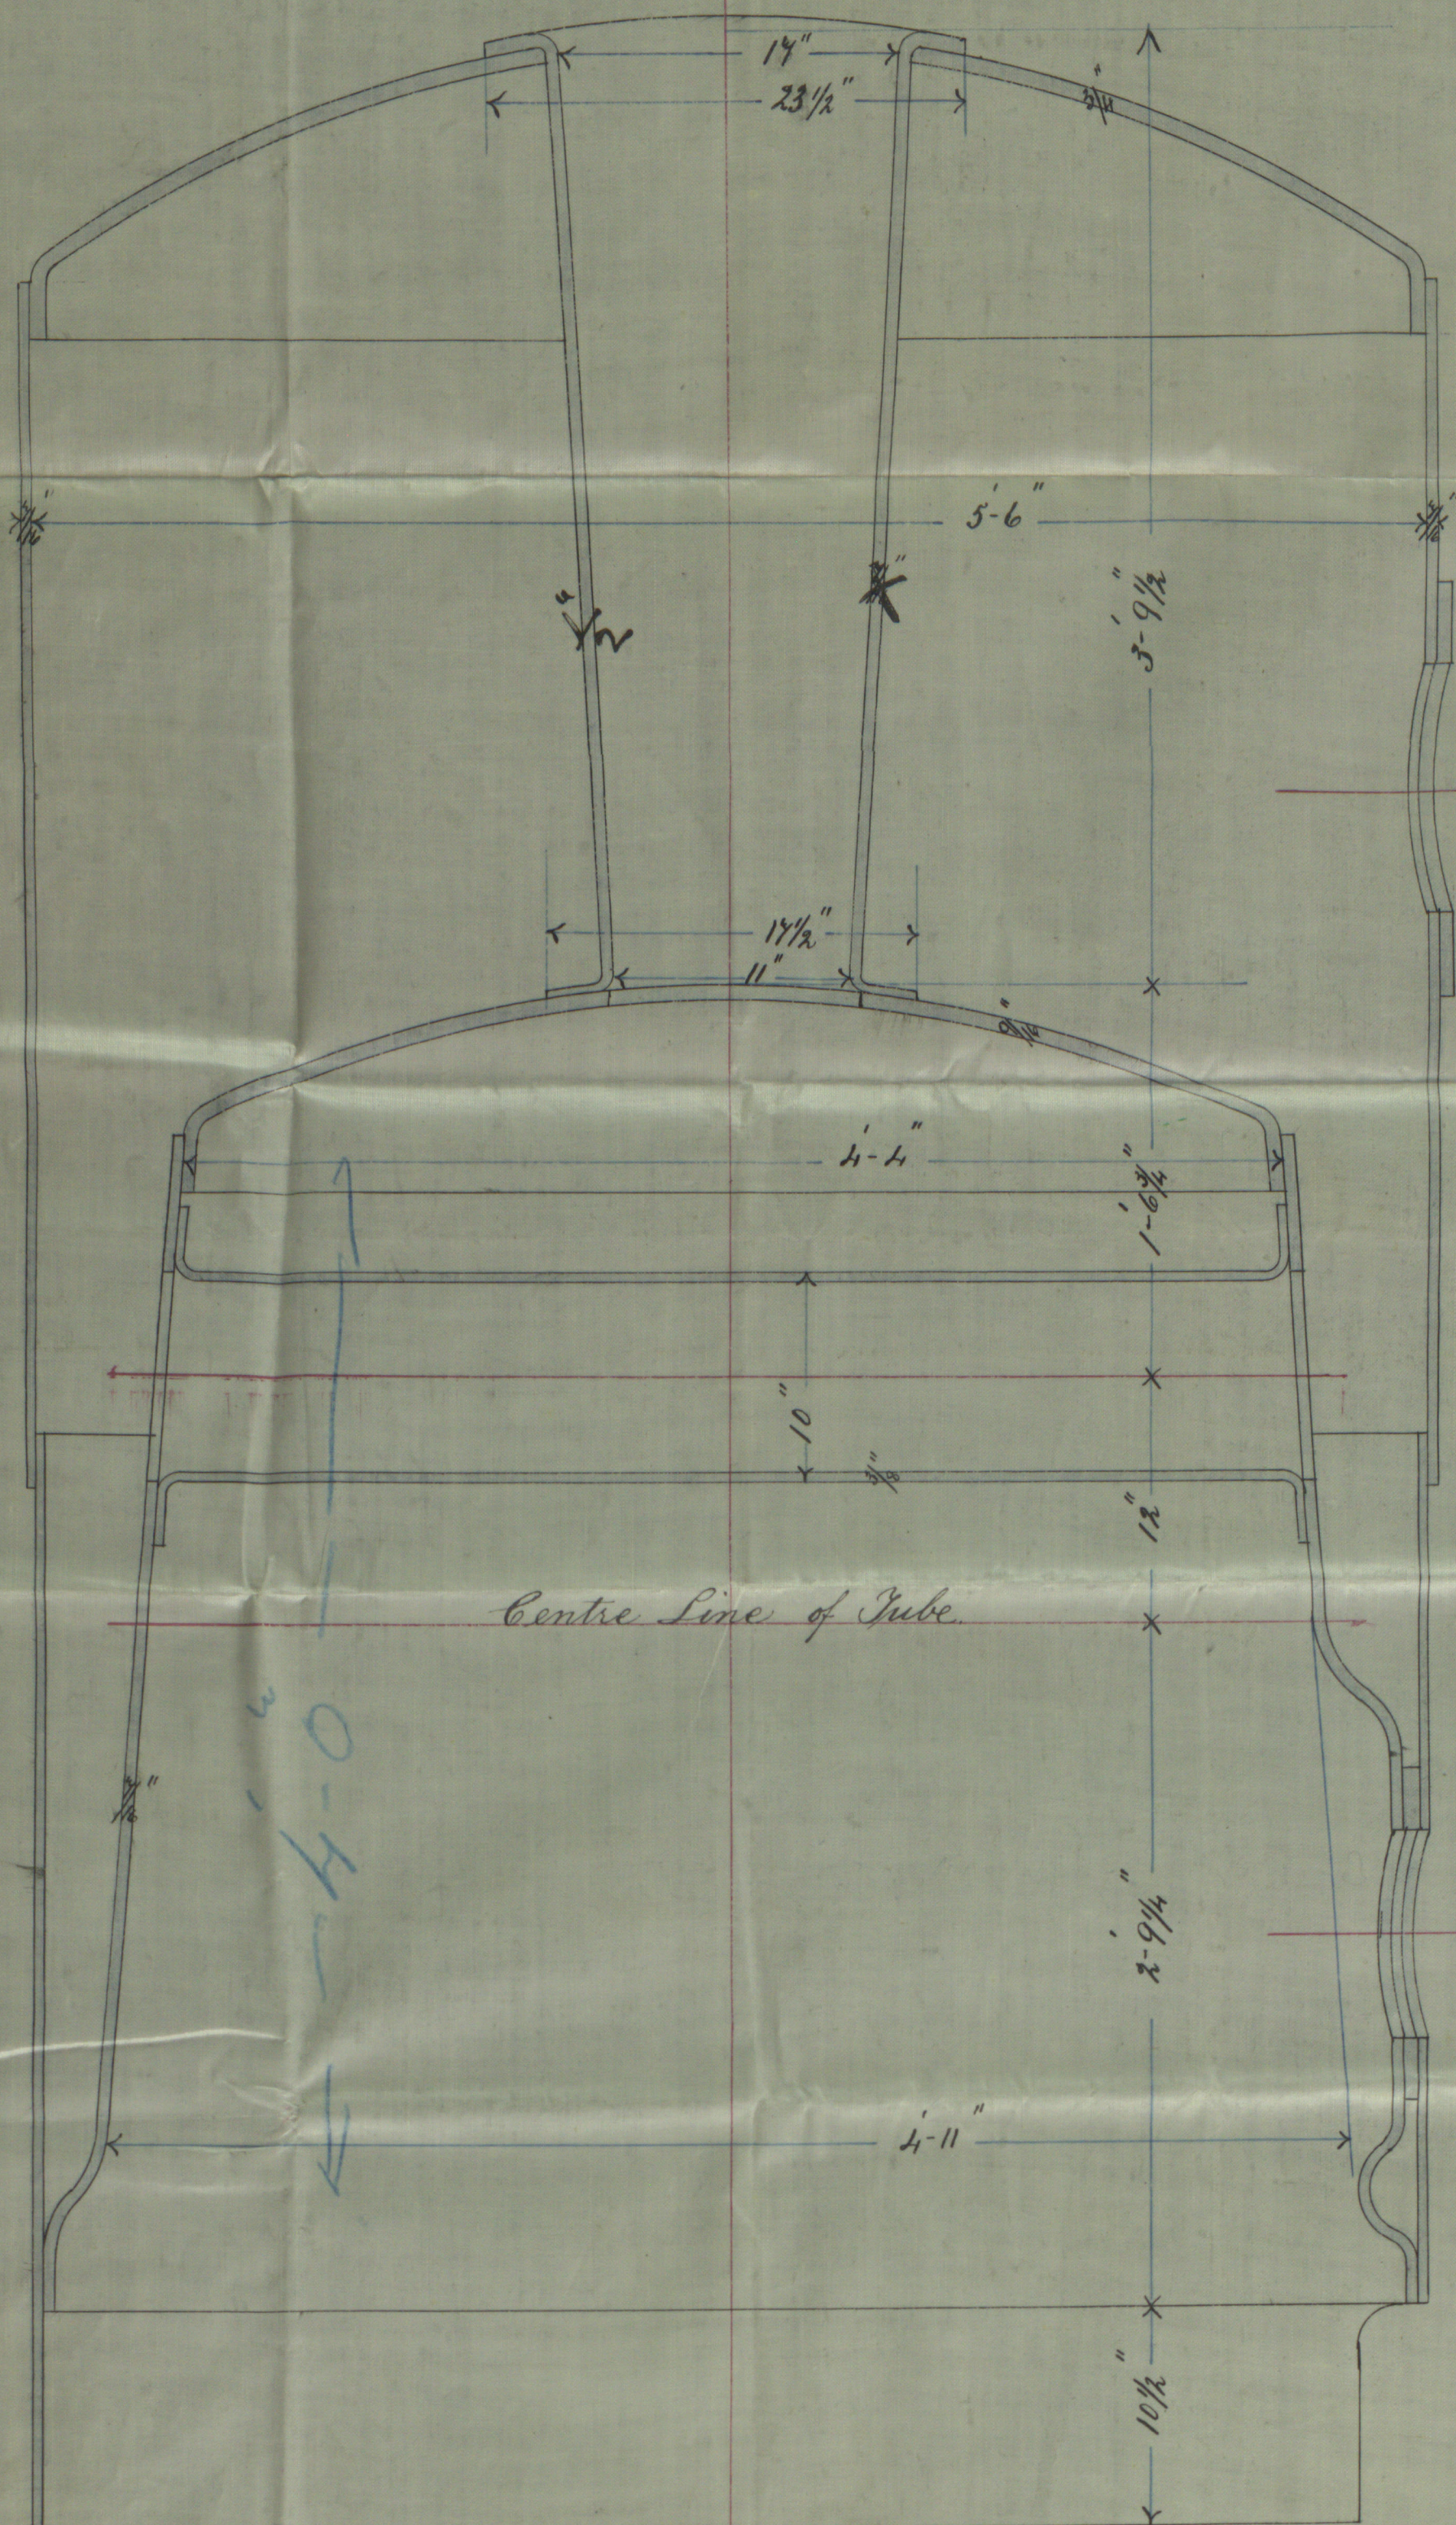


Mr. Dundee
5/9/82

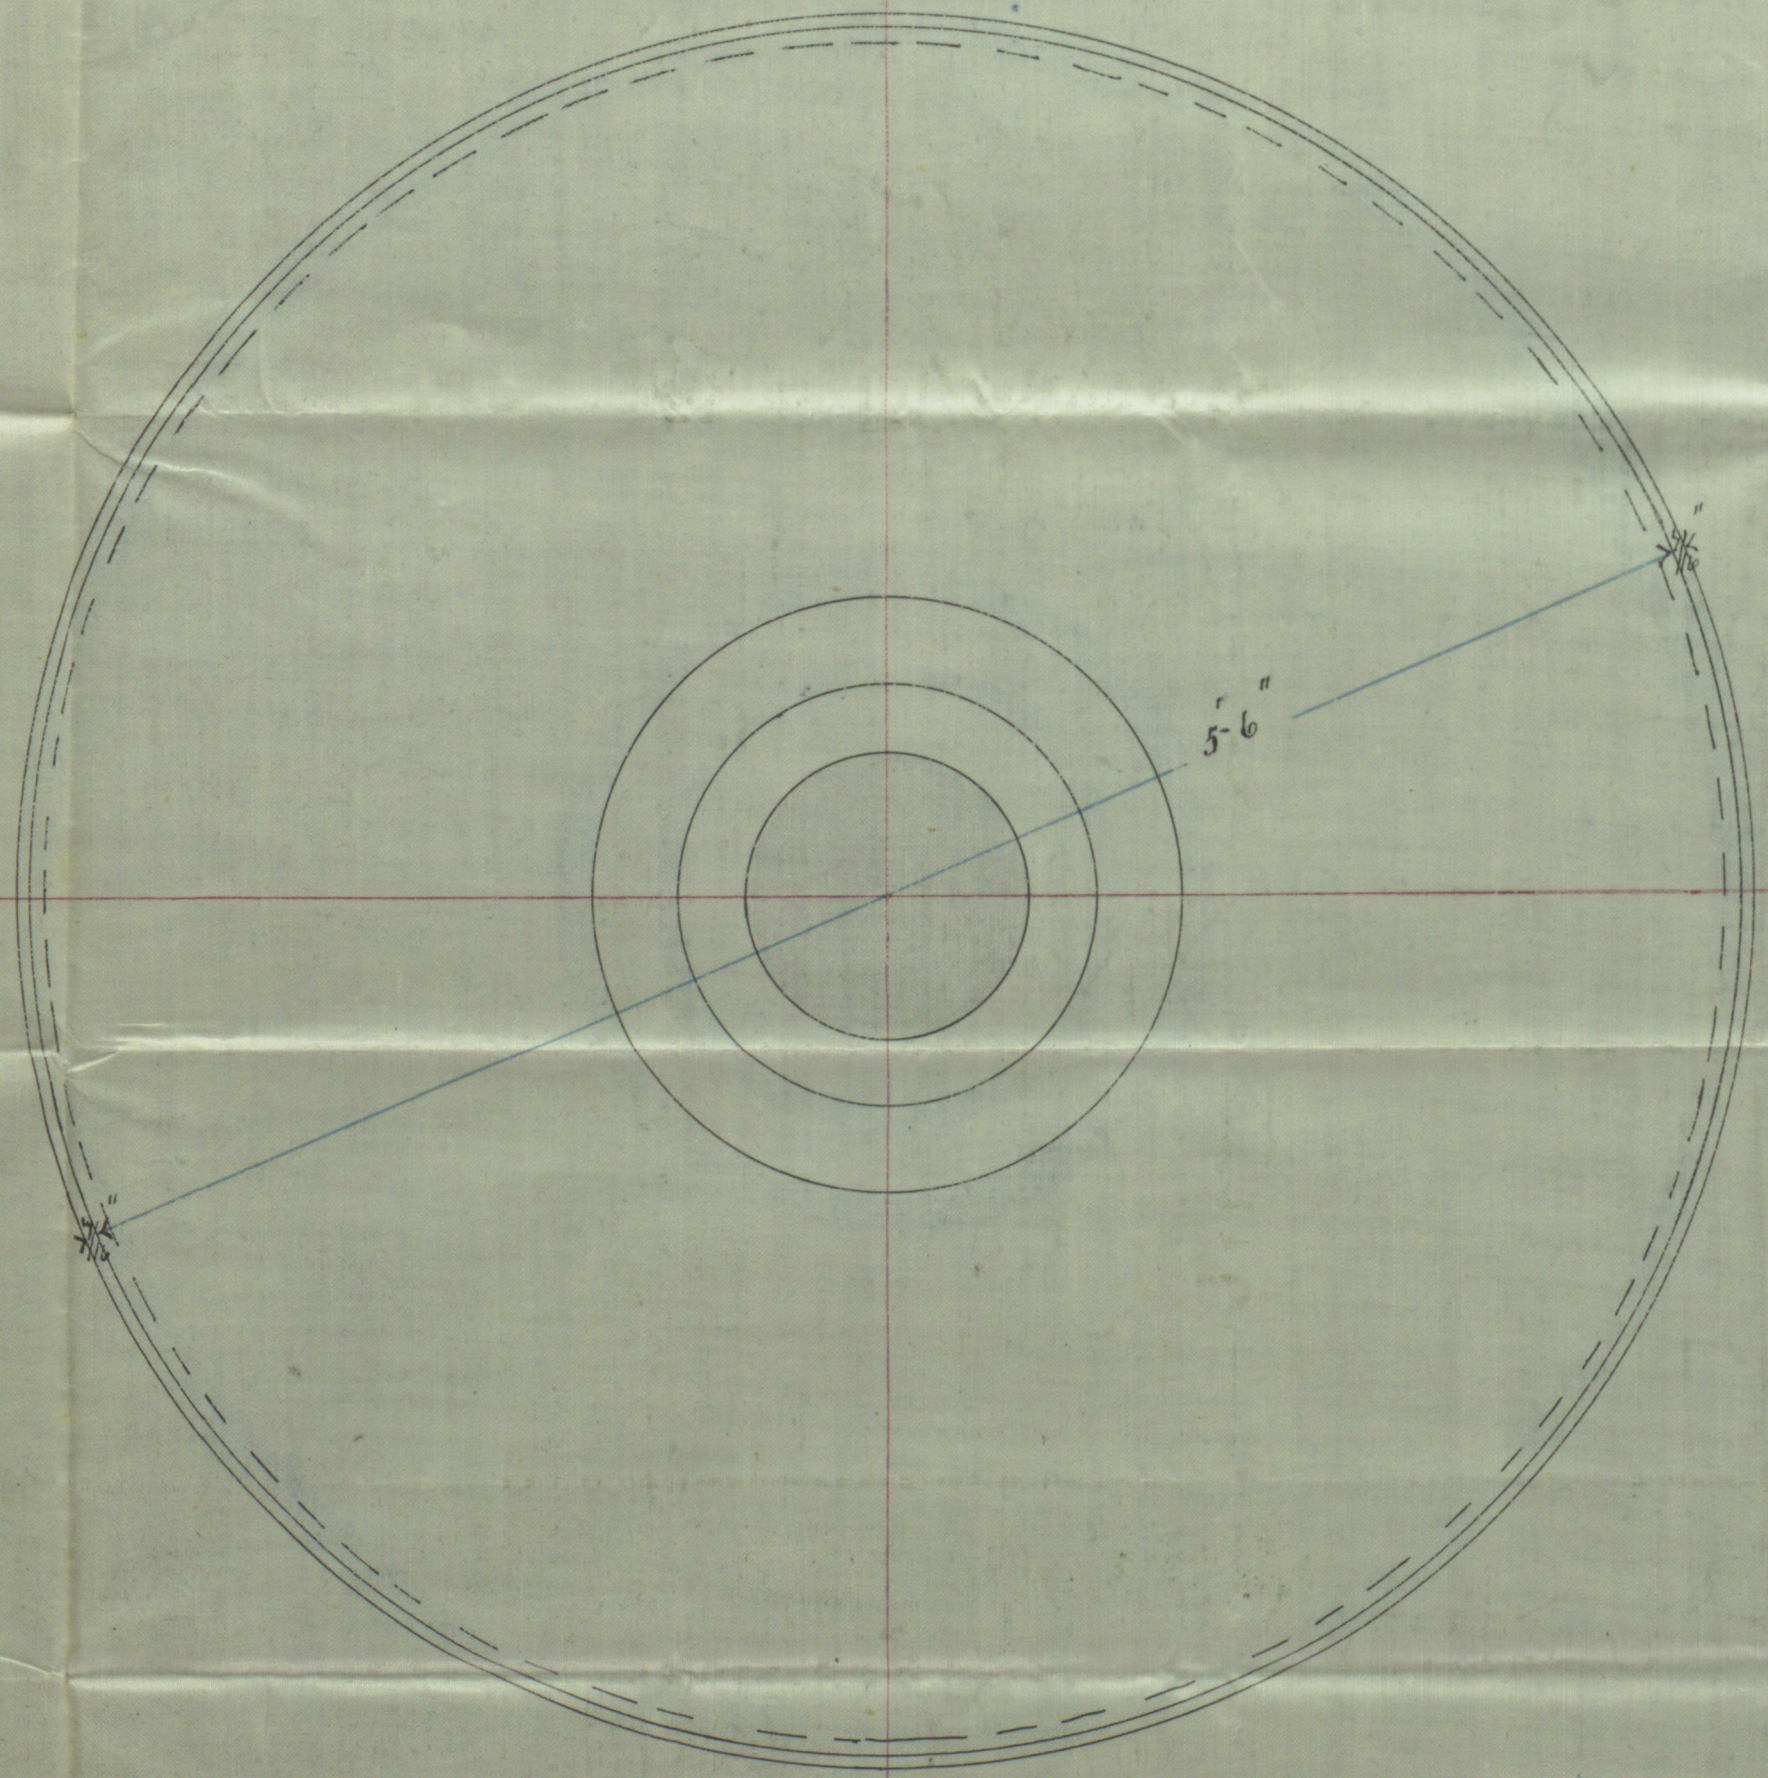

For No. 41 Ship
BOILER No 204


Sailing Ship "Dundee"
Scale 1 1/2" to one foot Dundee Report No 222.

WORKING PRESSURE ~~175~~ 55 lbs


GRATE SURFACE 16.8 sq feet

SHELL PLATES PUNCHED BEFORE BENDING

SHELL B.B. TOP B.B.B. FURNACE LOW MOOR

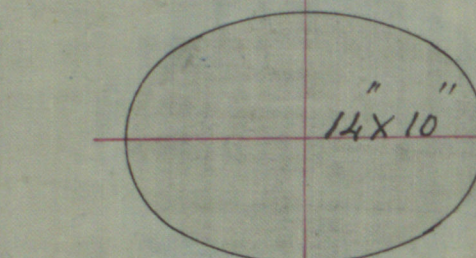

Col. R. Thompson
ENGINEER.
Tay Foundry
DUNDEE.

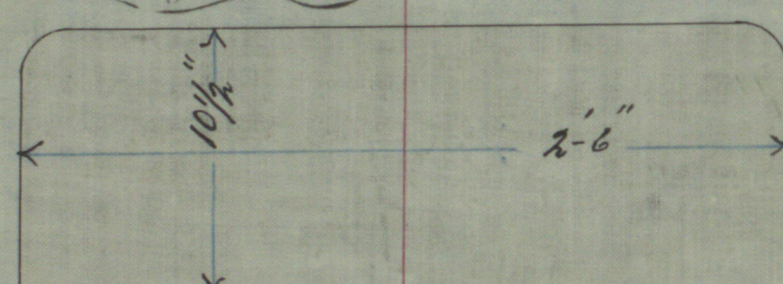

Steam 75 0/10
Rivets 80
Shells 75 lb
Furnace 77 lb

15

4/9/82

© 2049