




26/10/82

S.S. "Jasper" & S.S. "Ruby"  
 Dundee report No 4653.  
**MIDSHIP SECTION**  
**STEEL S. S. N<sup>os</sup> 53-4**  
 Scale  $\frac{1}{2}$  inch equals 1 foot.

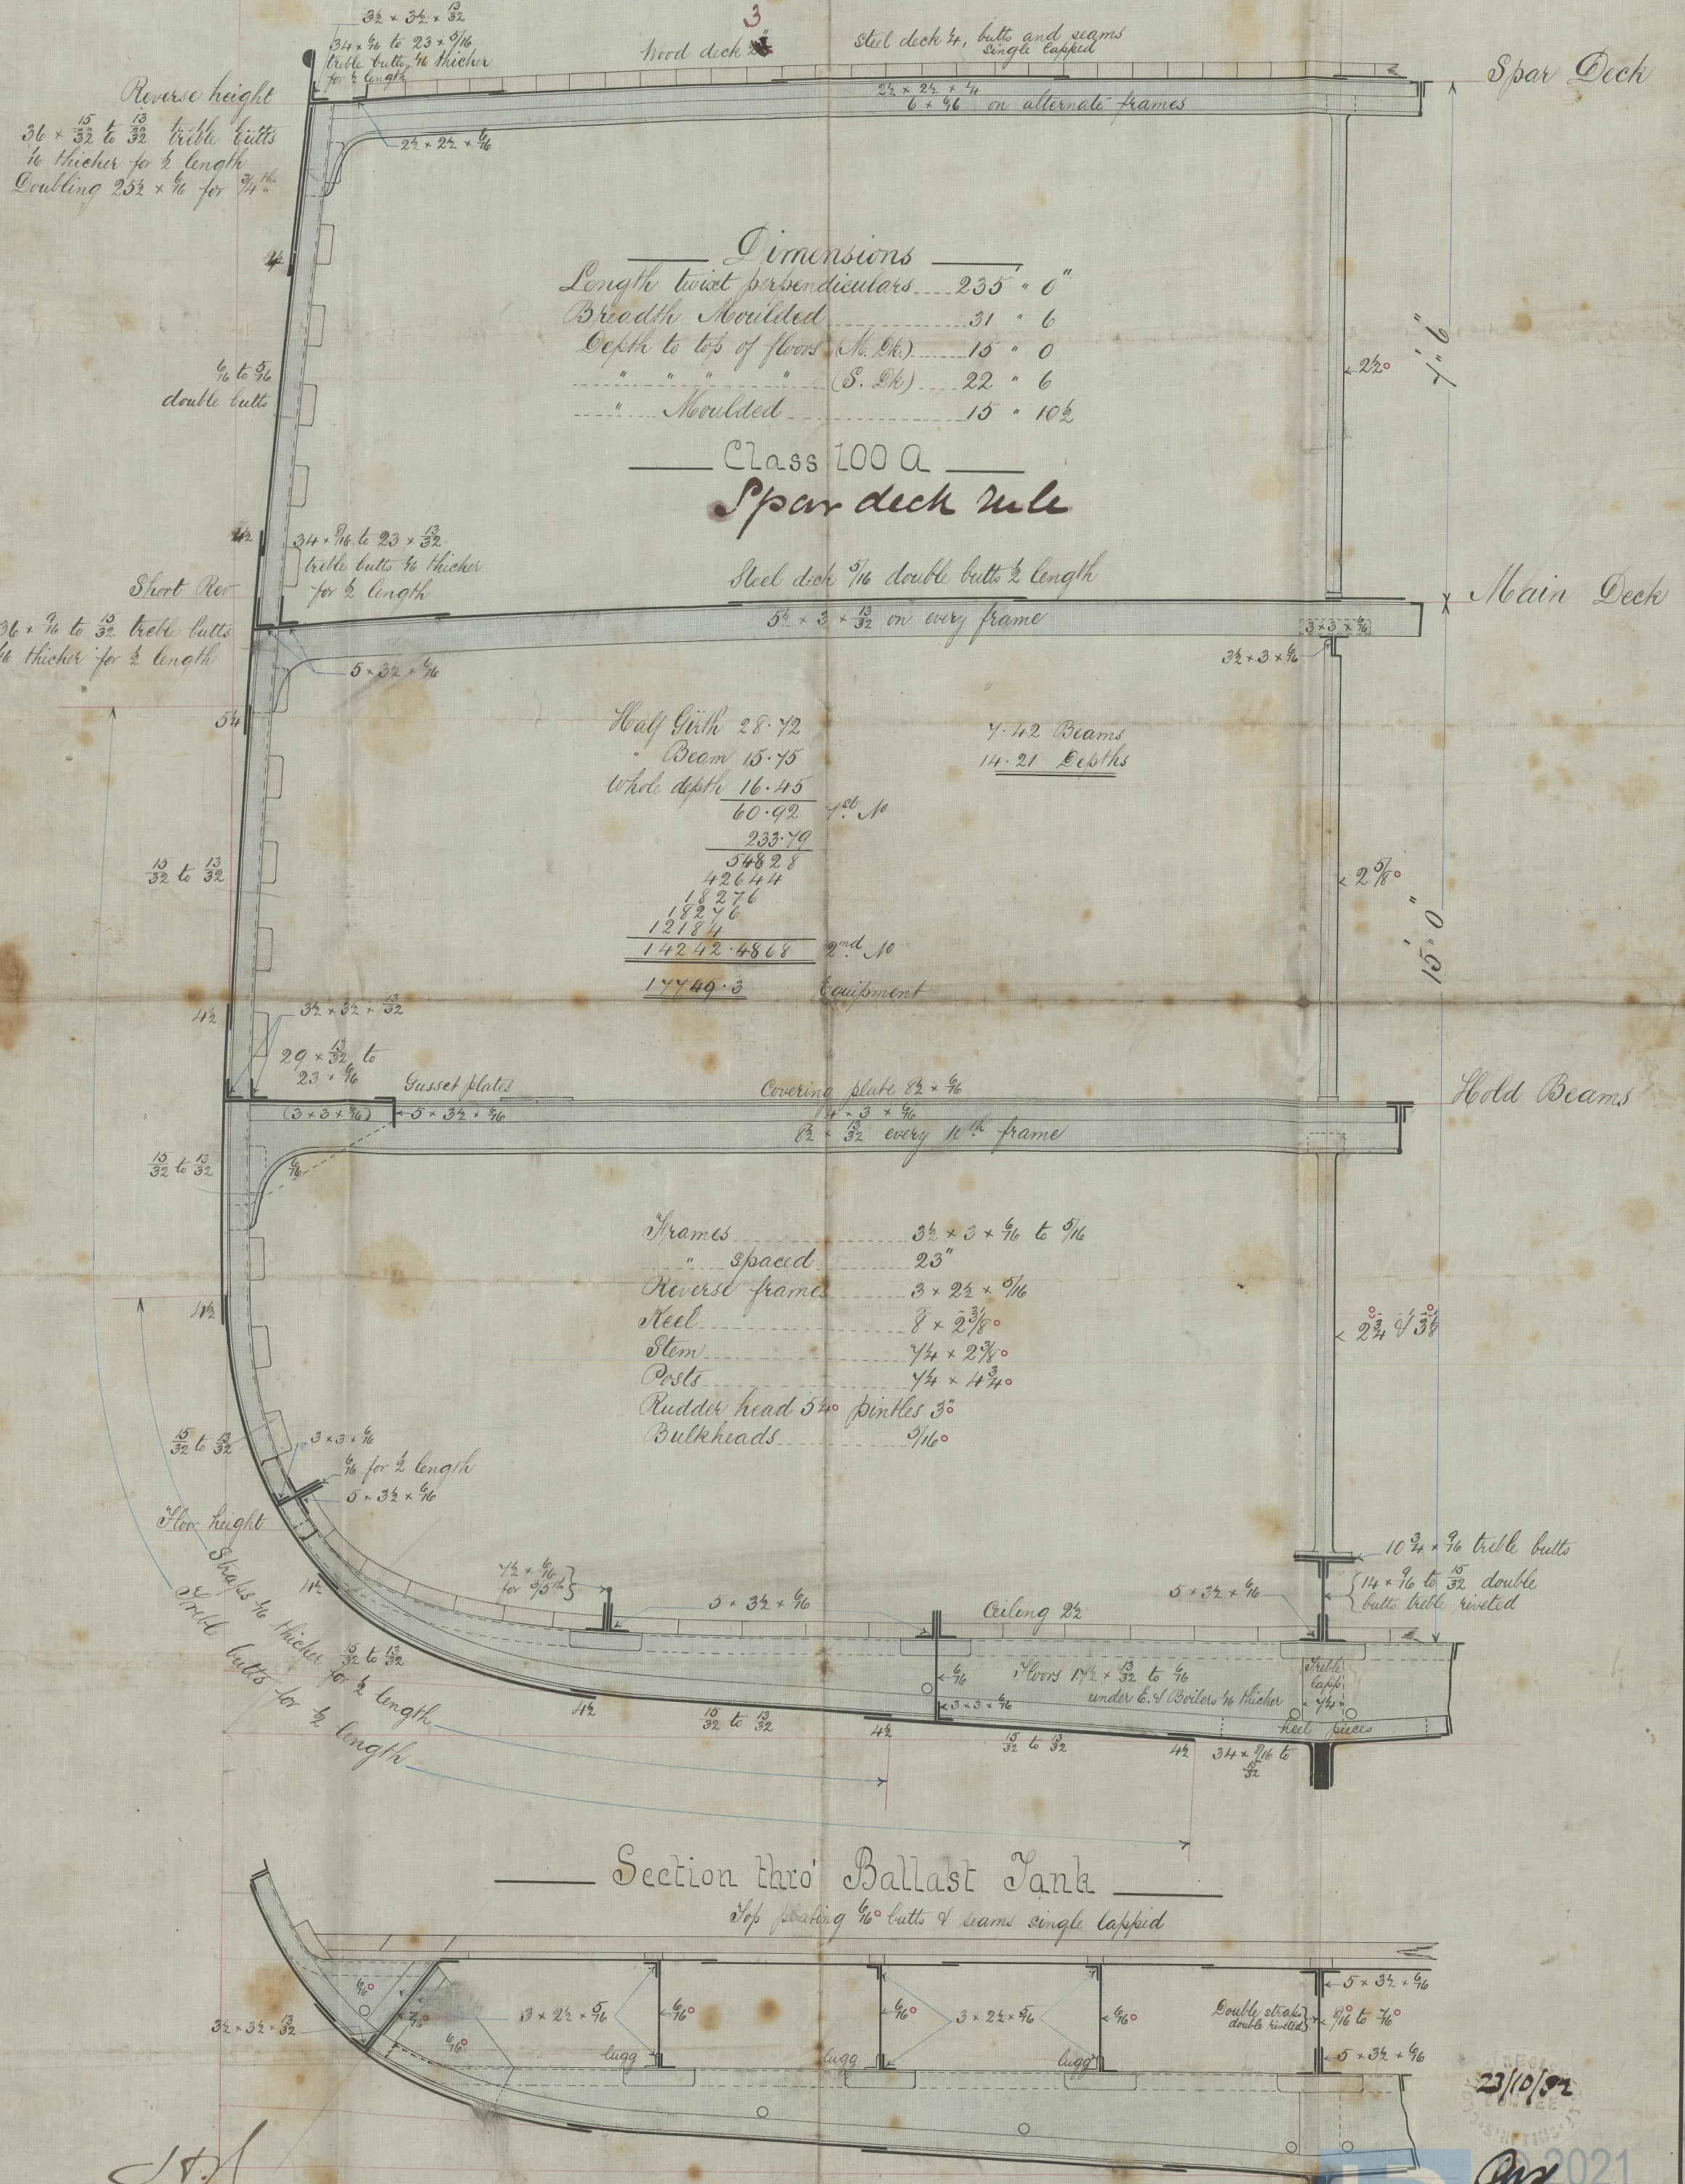

Dimensions  
 Length transverse perpendiculars.....235' 0"  
 Breadth moulded.....31' 6"  
 Depth to top of floor (No. 16).....15' 0"  
 " " " (S. Dk).....22' 6"  
 " " " moulded.....15' 10 1/2"

Class 100 A  
**Spar deck rule**

Half Girth 28.72  
 Beam 15.75  
 Whole depth 16.45  
 60.92 1st Jo  
 233.79  
 548.28  
 426.44  
 182.76  
 121.84  
 142.42 4868 2nd Jo  
 17749.3 Equipment

Frames.....3 1/2 x 3 x 1/4 to 5/16  
 " spaced.....23"  
 Reverse frames.....3 x 2 1/2 x 5/16  
 Keel.....8 x 2 3/8"  
 Stem.....1/4 x 2 3/8"  
 Posts.....1/4 x 4 3/4"  
 Rudder head 5 1/4" pintles 3"  
 Bulkheads.....5/16"

Section thro' Ballast Tank

18/10/82  
 25/10/82

Note signs marked thus . to be iron