

27 to 28 mm
27/1/25

268. BOILERS N^o 256. SHIP N^o III.

Working Pressure 75 lbs.
Scale 1" = 1 ft.

Note: All plates to be Steel.
Stays & Tubes to be Iron.





SS "Virgo"
Dundee report to 294

Seam	74 1/2	Leads	88 1/2
Miner	76	Seam	70
Shell	78 1/2	Shell	154 1/2
Furnace	72	Leads	86
Combs & plates	56 7/8	Boilers	306 1/2
End plate	79		
Tube plate	57 1/8		
Boiler plate	57 1/8		
	57 1/8		

Thickness of Plates

SHELL	Steel	3/8"
ENDS	"	3/8"
Tube Plates	"	3/4"
Furnaces	"	3/8"
Fireboxes	"	3/8"
Steam Receiver		
Shell	Steel	1/2"
Ends	"	1/2"
Connections	"	1/2"

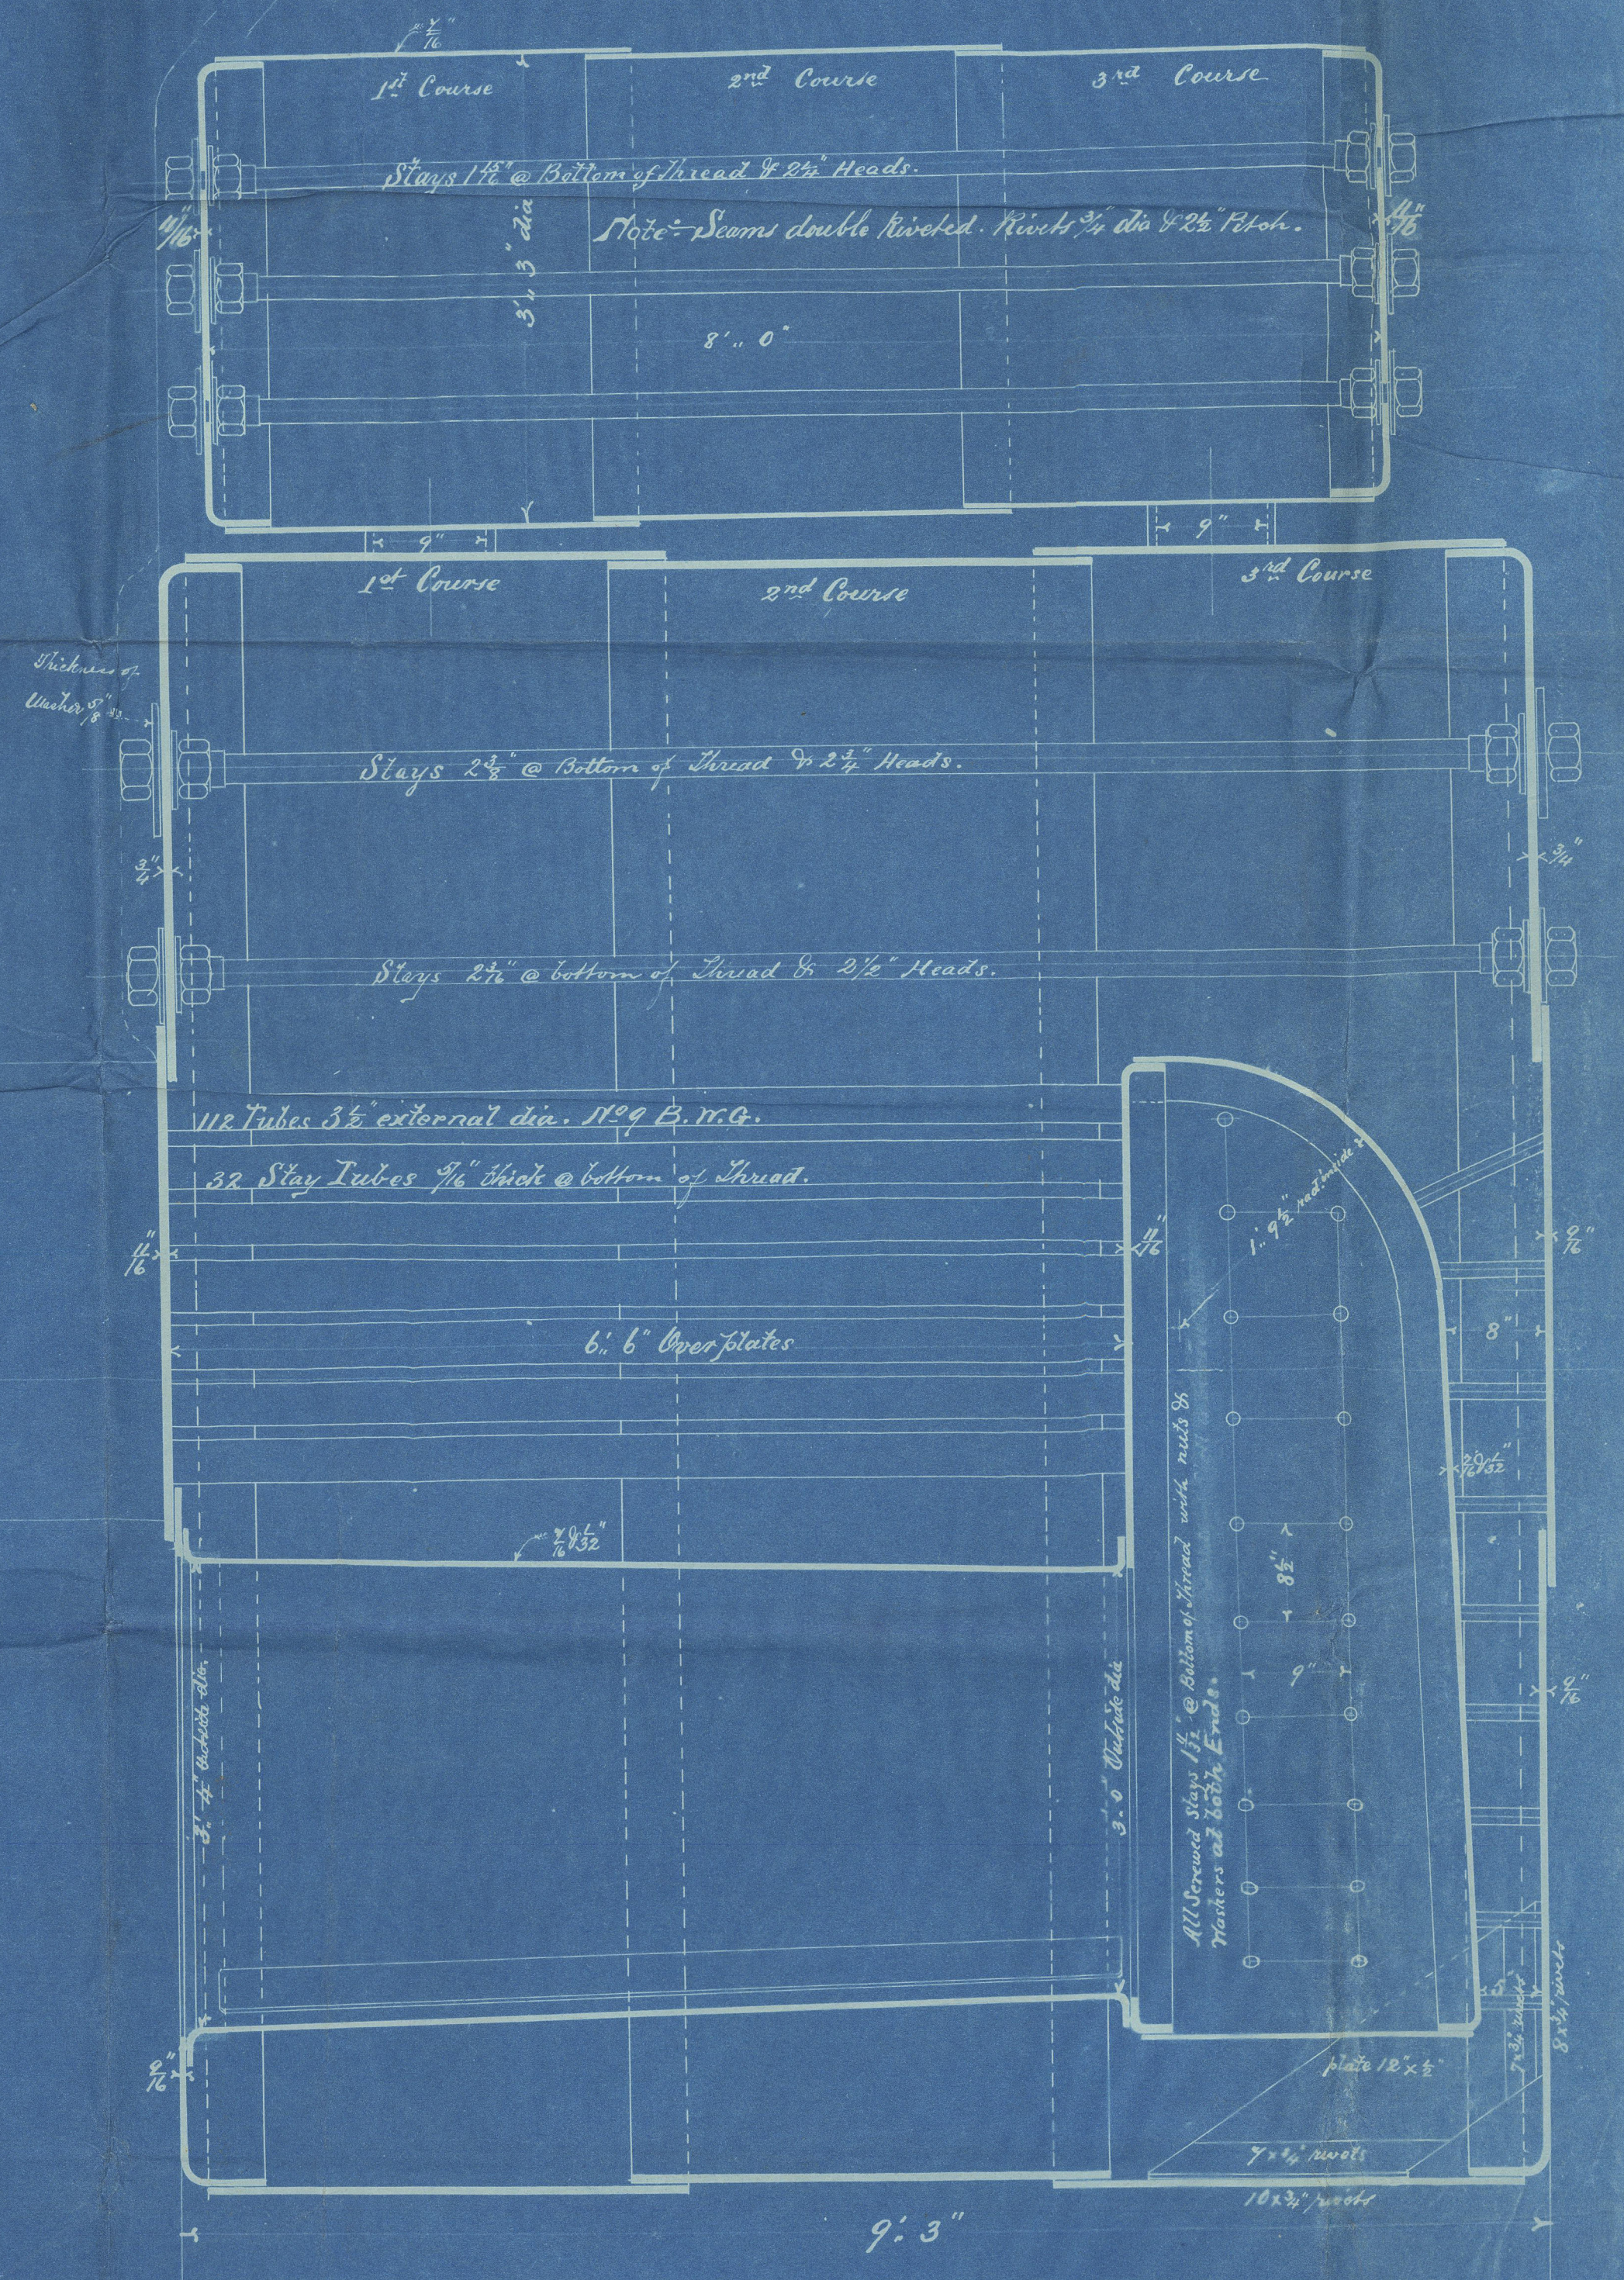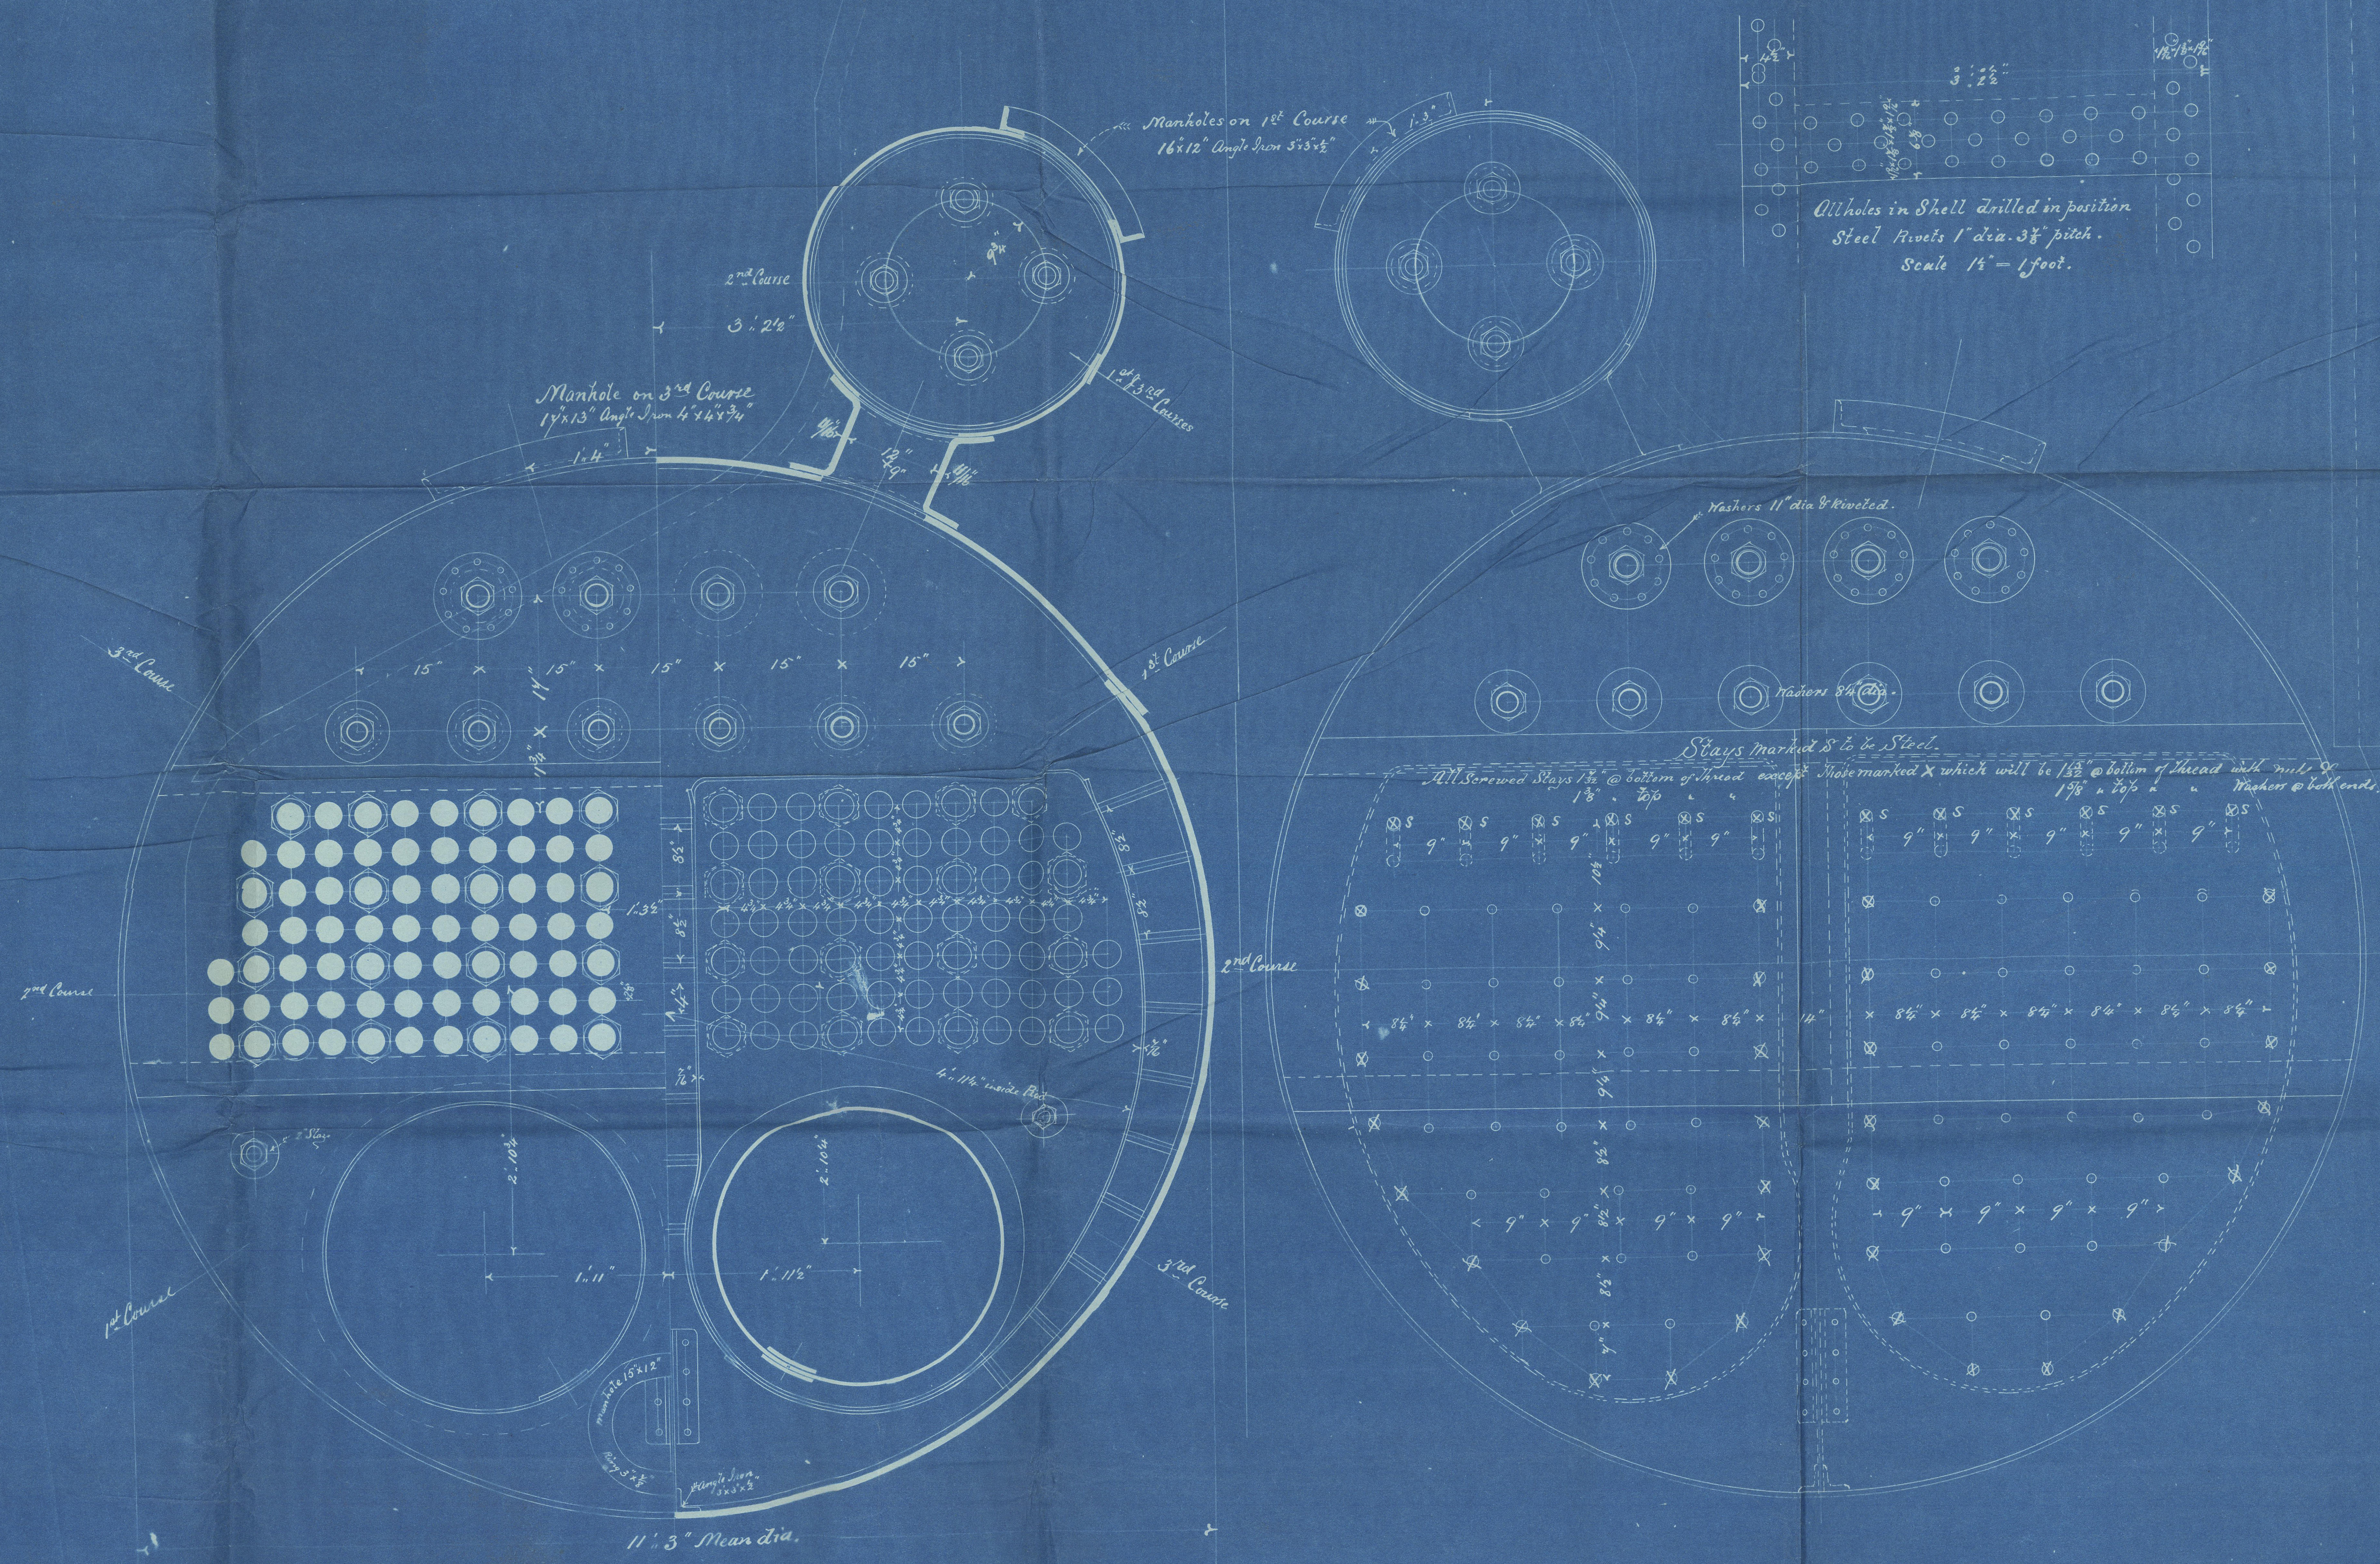

27/1/83
24/1/83



I I wings for B.O.G. —

DUN109-0111



© 2021

Lloyd's Register
Foundation