

Received 4/5/82
RECEIVED DEC. 82

11.0.82.
6/12/82




MIDSHIP SECTION
of
STEEL SAILING VESSEL

N^o 82

Scale 1/2 inch = one foot
TO CLASS 100A IN LLOYDS REGISTER

S. "Earl of Dalhousie"
Dundee report No 4737.

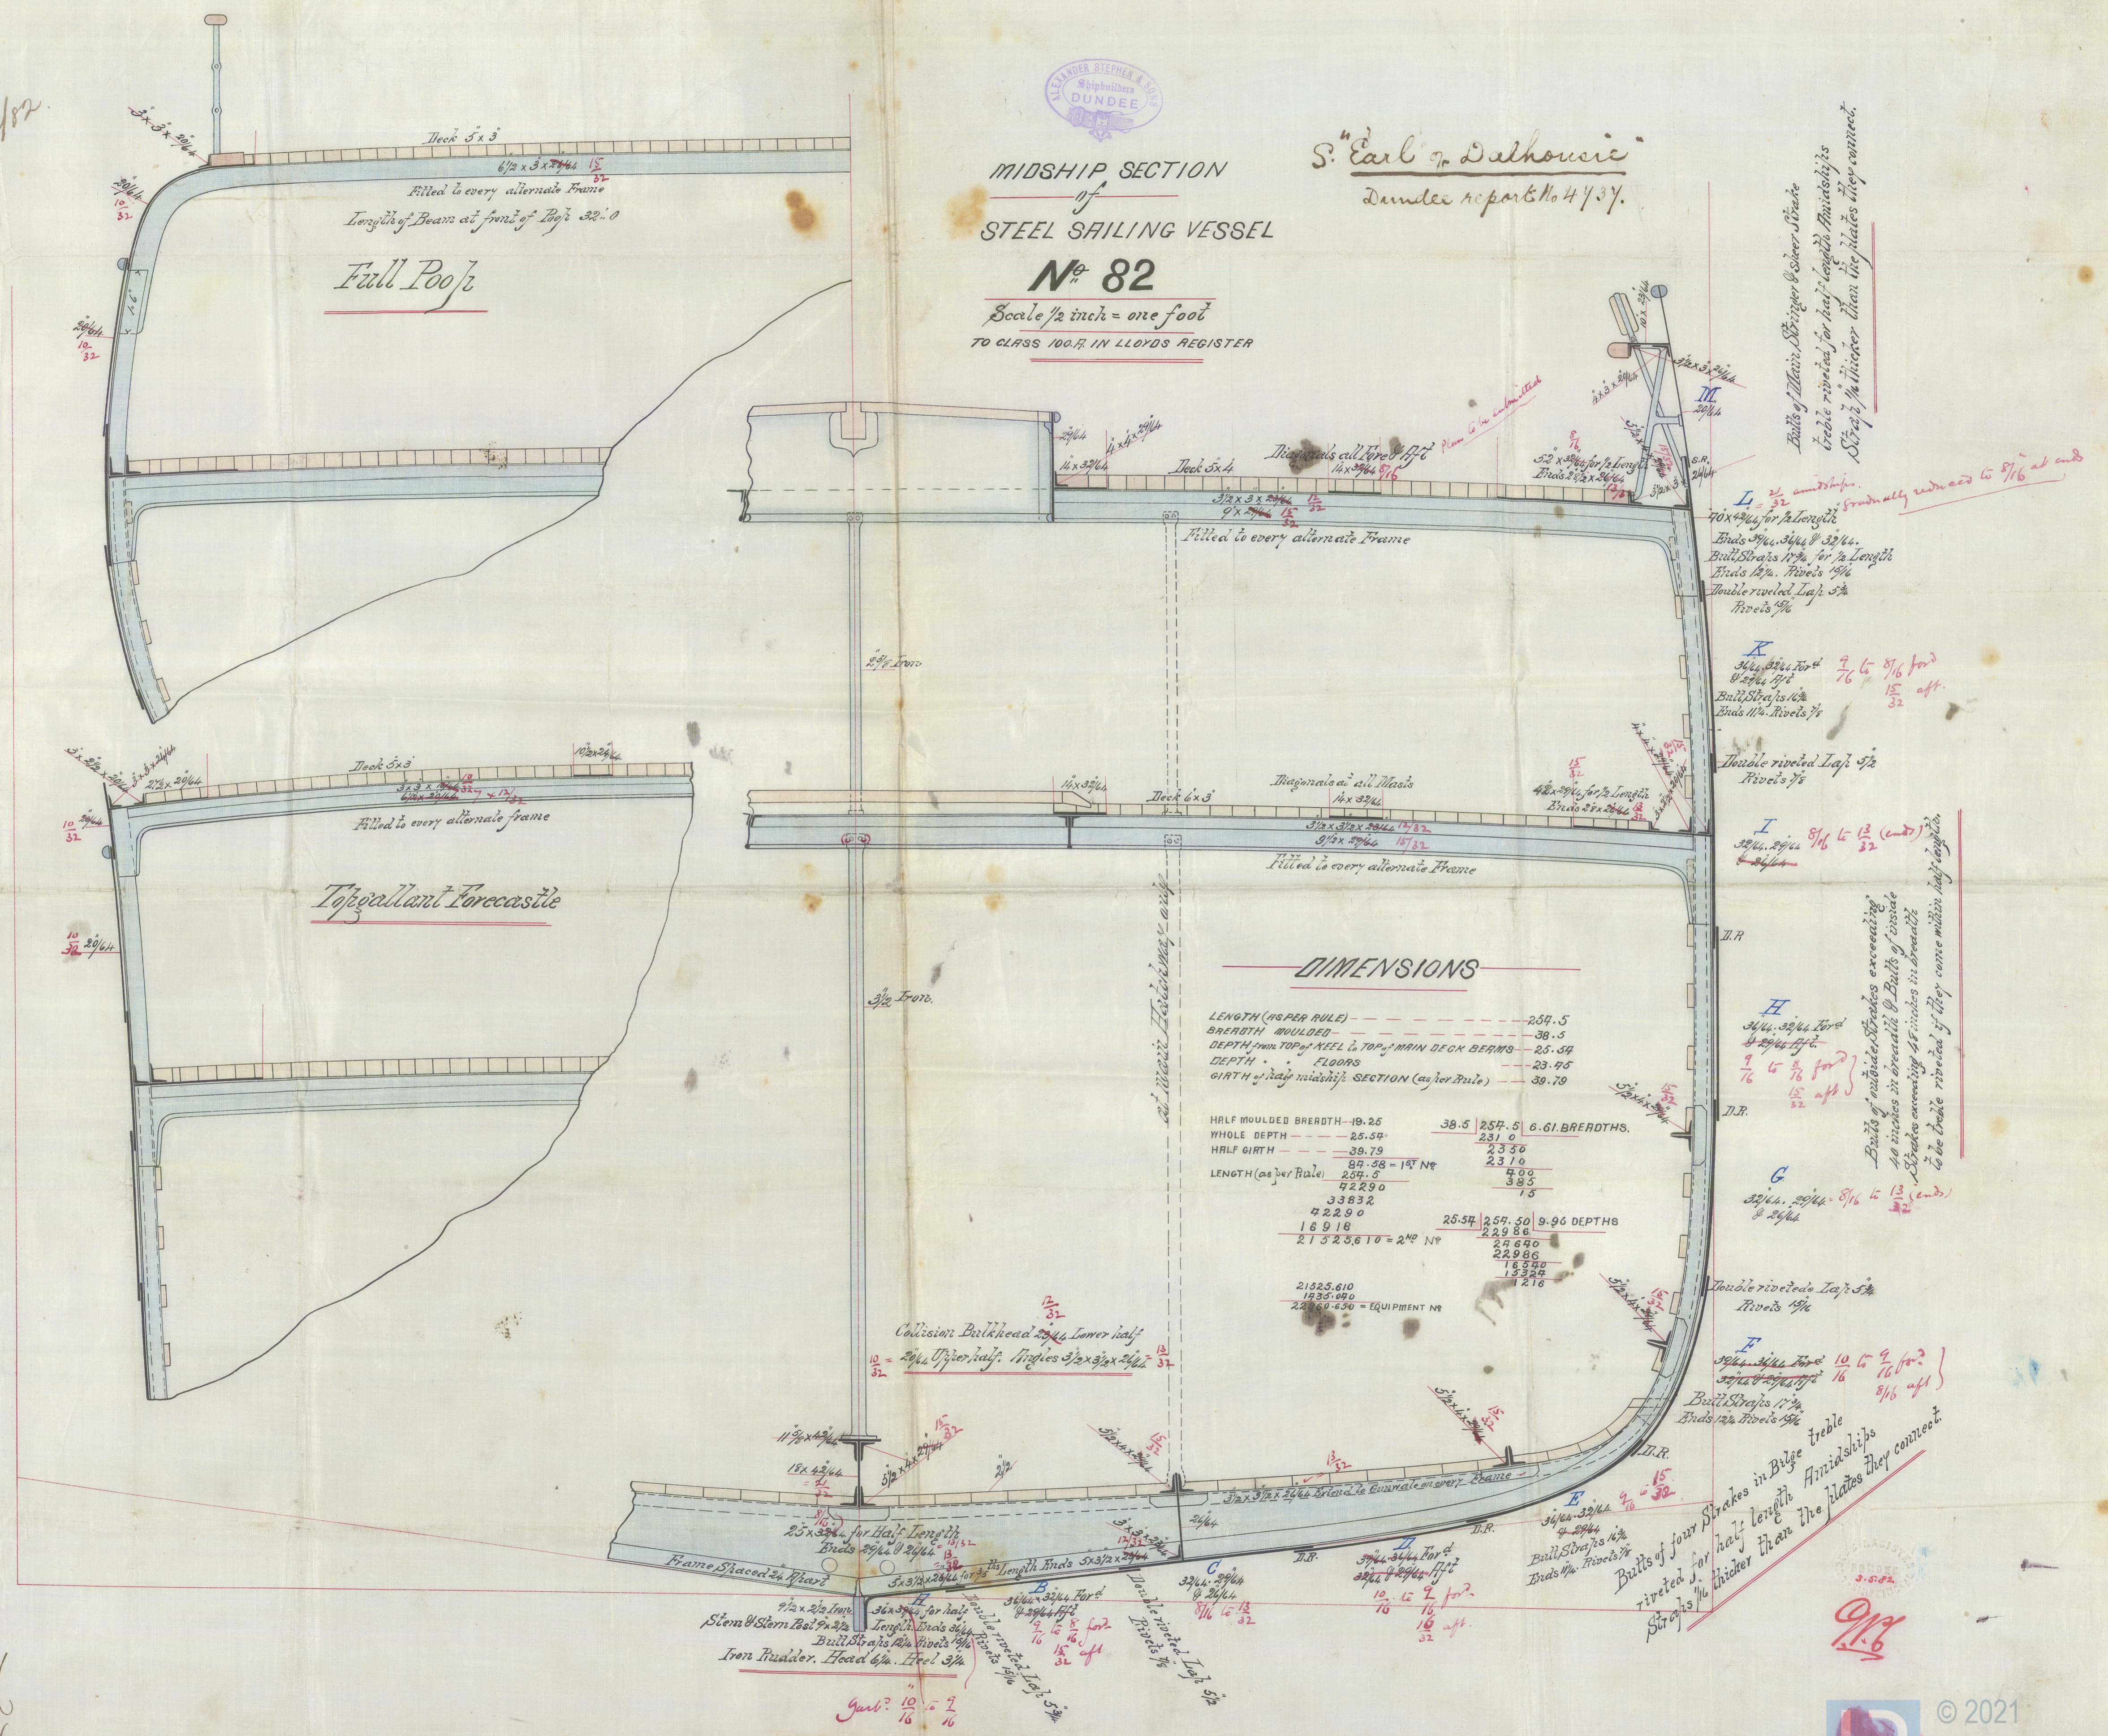

DIMENSIONS

| | |
|--|-------|
| LENGTH (AS PER RULE) --- | 257.5 |
| BREADTH MOULDED --- | 38.5 |
| DEPTH from TOP of KEEL to TOP of MAIN DECK BEAMS --- | 25.34 |
| DEPTH --- FLOORS --- | 23.45 |
| GIRTH of half midship SECTION (as per Rule) --- | 39.79 |
| HALF MOULDED BREADTH --- | 19.25 |
| WHOLE DEPTH --- | 25.54 |
| HALF GIRTH --- | 39.79 |
| LENGTH (as per Rule) --- | 254.5 |

Built of Main, Stringer & Silver Strake
treble riveted for half length Amidships
Strake 1/2 thicker than the plates they connect.

L = 32
40 x 4 1/2 for full length
Brds 3 1/2 x 3 1/2 @ 32 1/2
Built Strakes 1 1/2 for 1/2 length
Brds 1 1/2 x 3 1/2
Double riveted Lap 5
Rivets 1 1/2












J.H.
10/5/82