


Dr. to Dun.  
 18/6/83  
 10/7/83.




S. Earl of Balhousie  
 Dundee report N° 41/37.

SPAR PLAN  
 of  
 SHIP N° 82  
 Scale 1 Inch = one foot

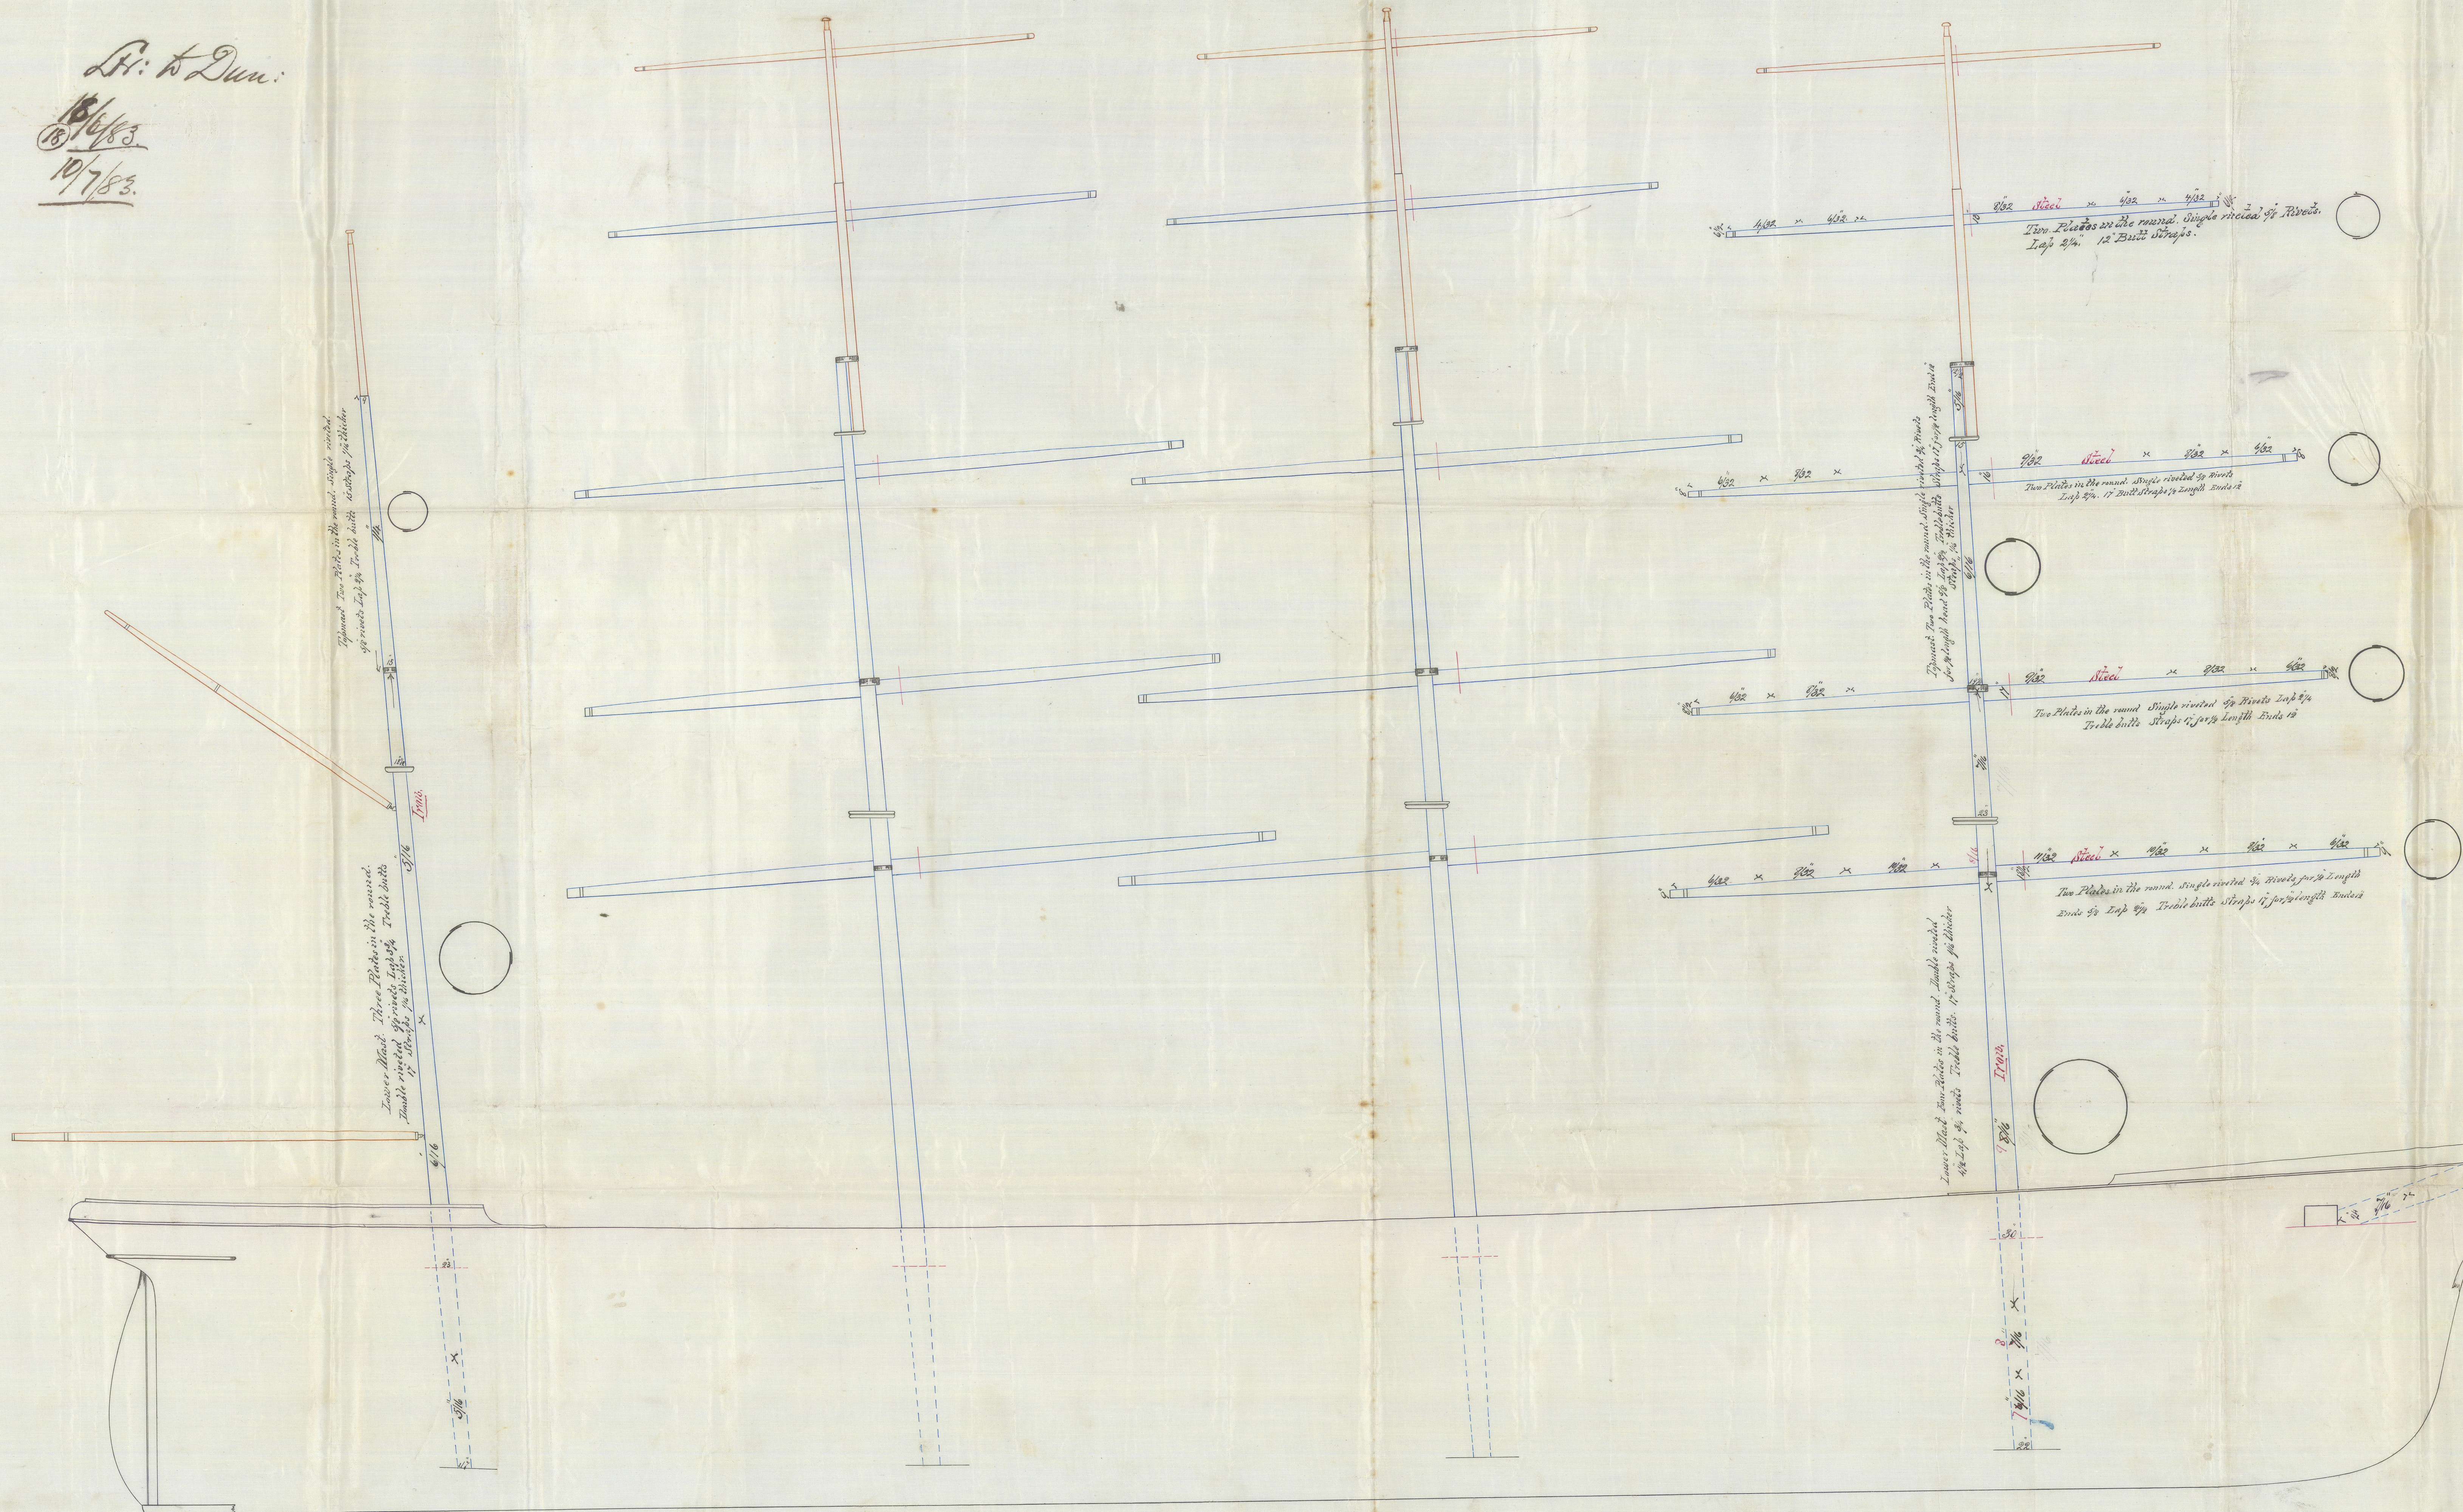

Note, All Masts & Bowsprit (in Blue) to be Iron, Yards Steel,  
 Main & Foremast are inside sides  
 Main & Foremast same as Fore Mast  
 Masts doubled at weighing, Bowsprit at base, Yards at centres.

See letter to Dundee  
 18/6/83  
 Dr.

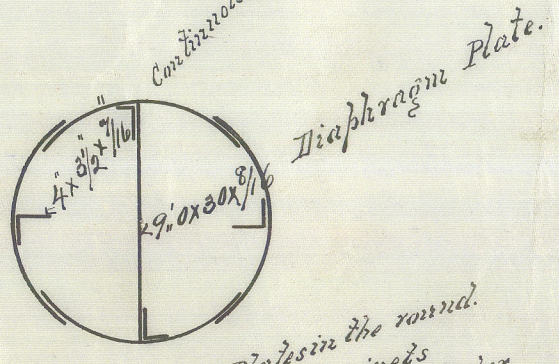

Continuous Angle bars  
 Bowsprit, Fore Mast in the round  
 Yards, main & foremast  
 Double butts 15' length for divider  
 15' length for divider

18m  
 10/7/83  
 Dr.