

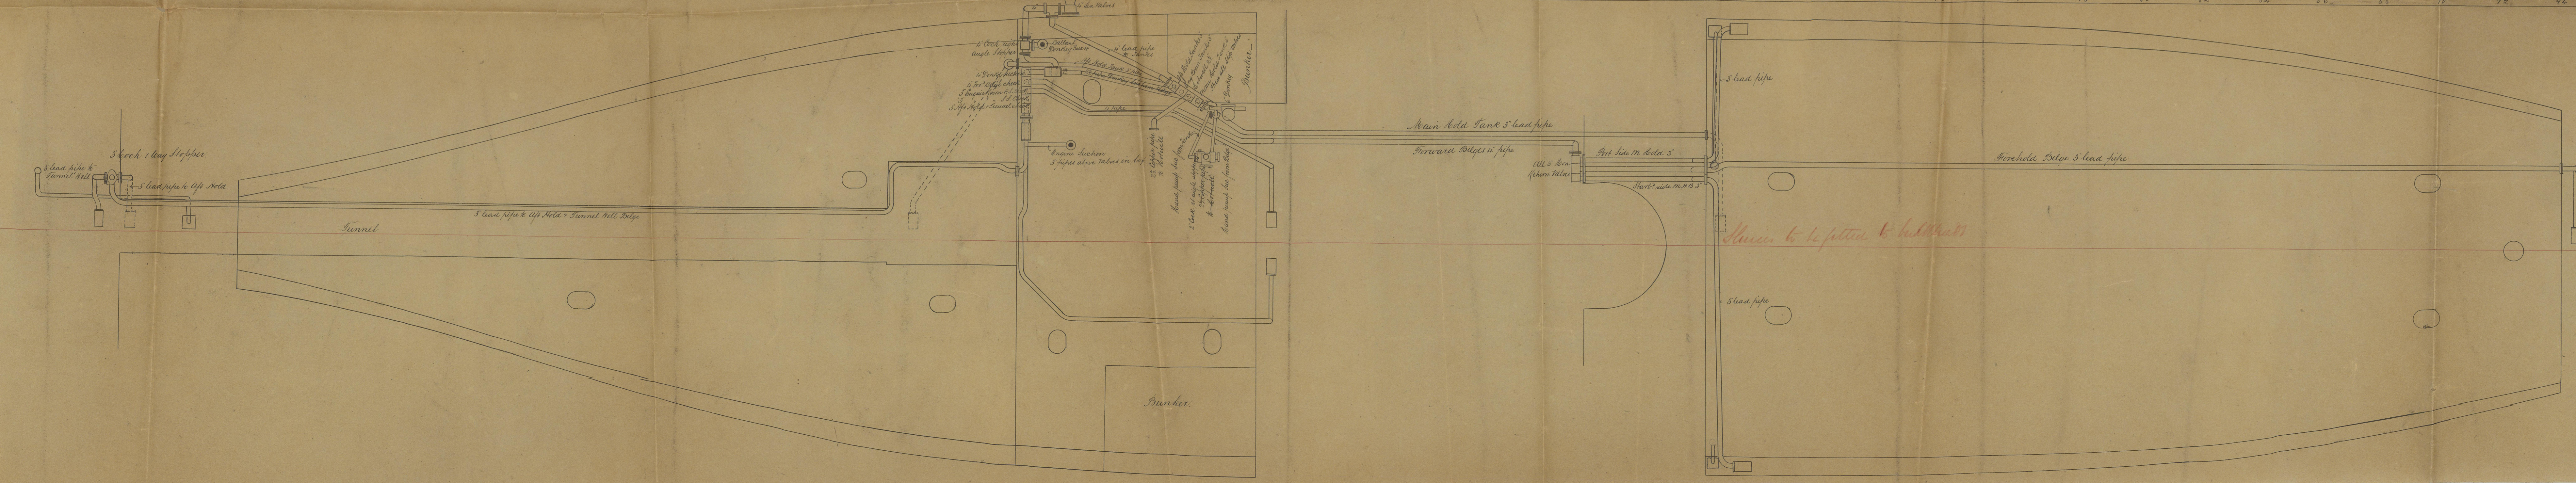


100 ft. dia
 9/5/04

 

Piping Arrangement
 S S. No 59

St. "Frederick"
 Sundee reports No 4740
 343.

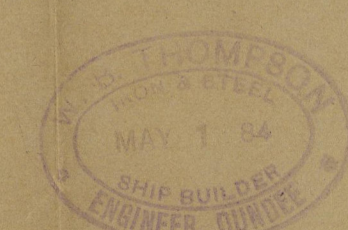

6/5/04

100 ft. dia
 9/5/04