

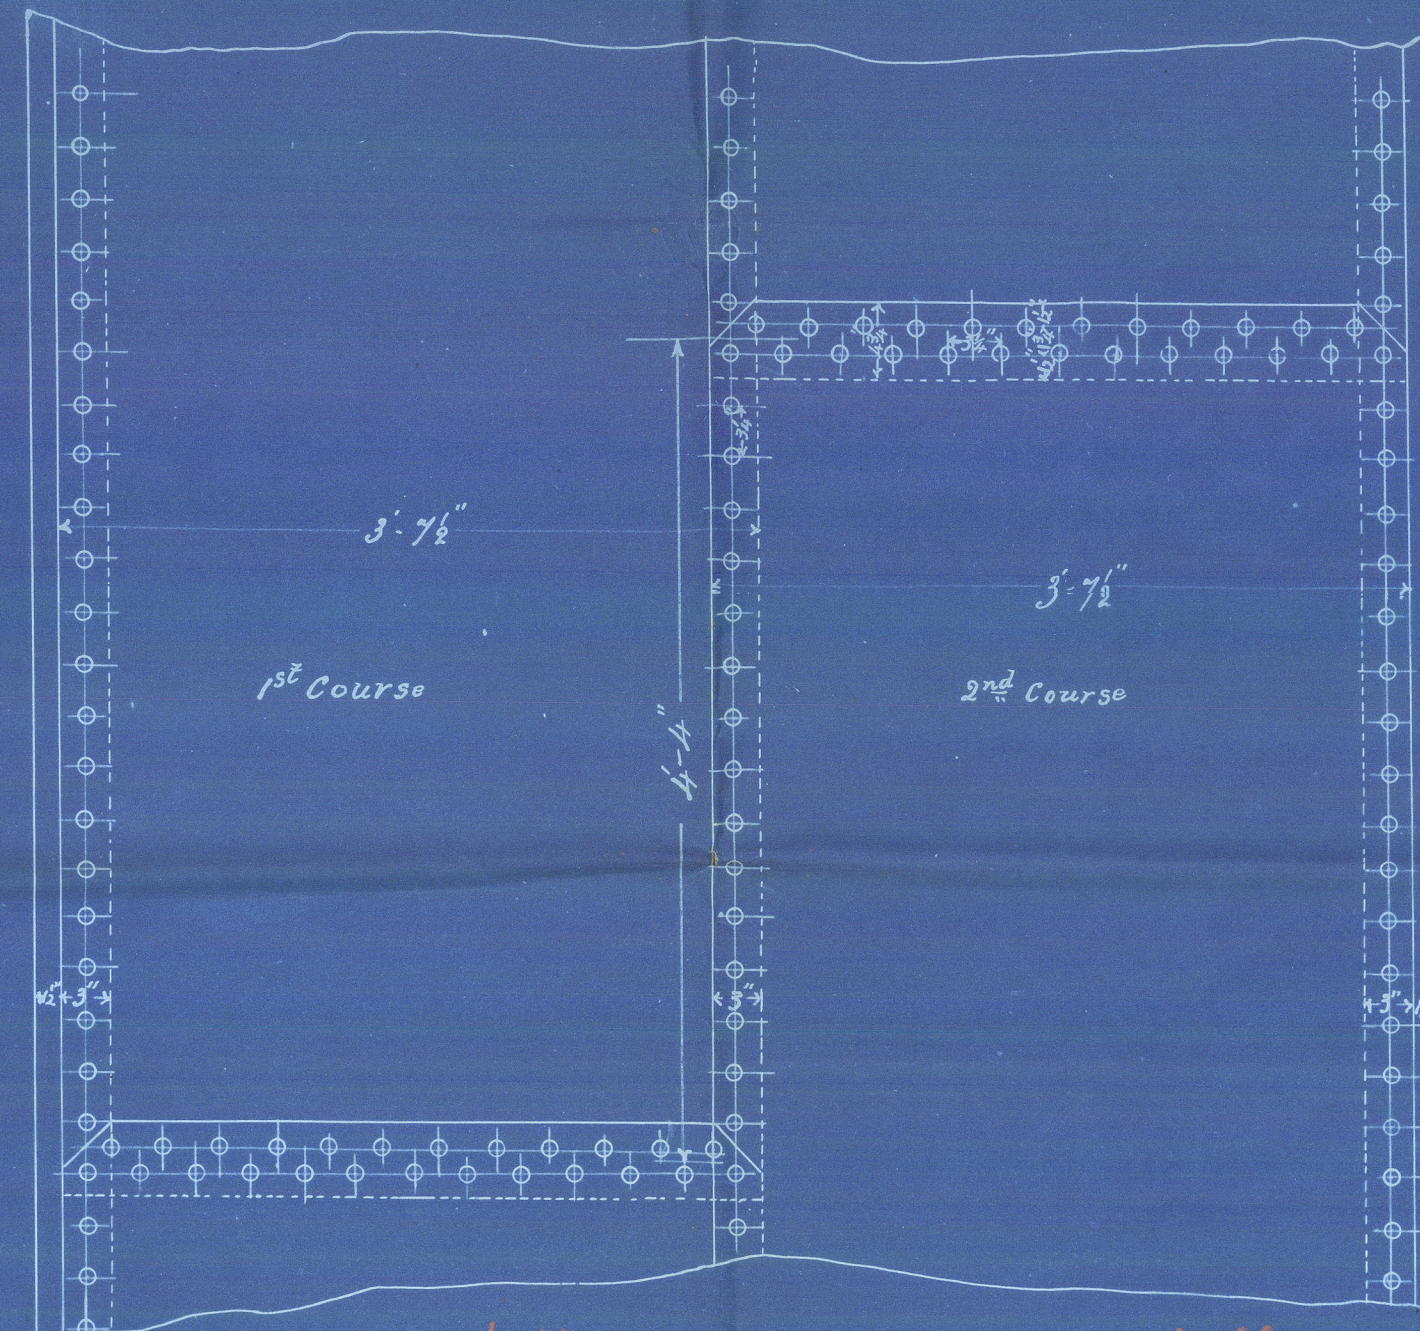



226.6
11/4/84

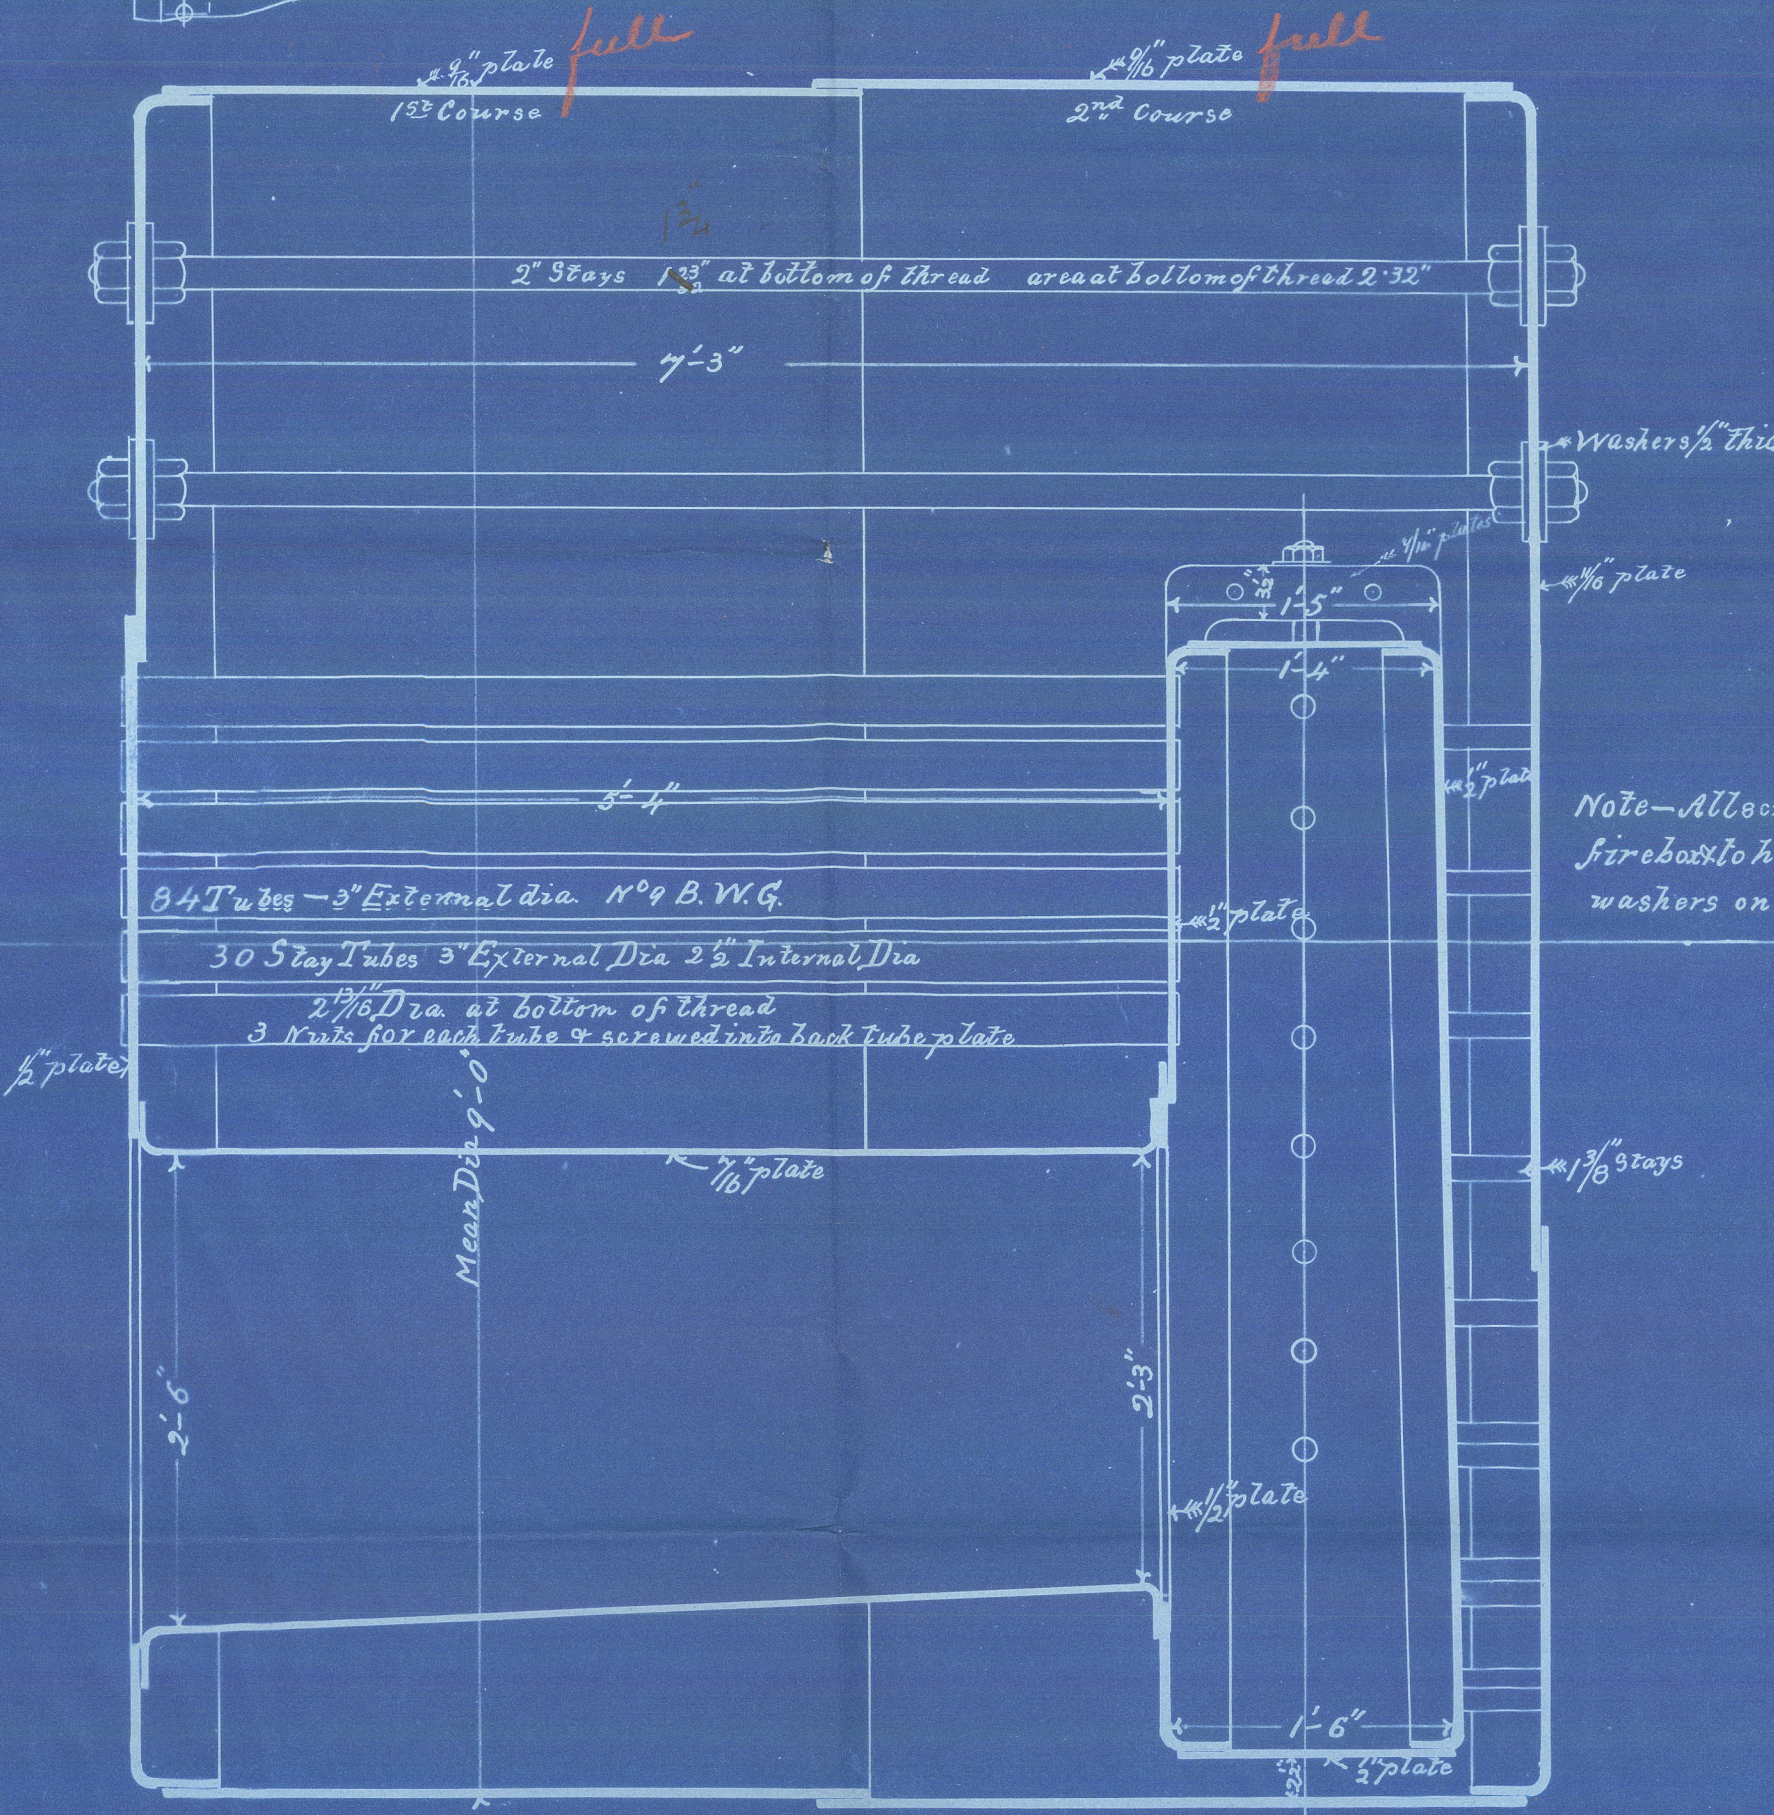

Note - Shell plates $\frac{5}{16}$ " thick Steel Rivets 1" dia 3 1/2" pitch
Strength of plate at joint compared to solid plate 69.2%
" " rivets " " " " " 70.8%

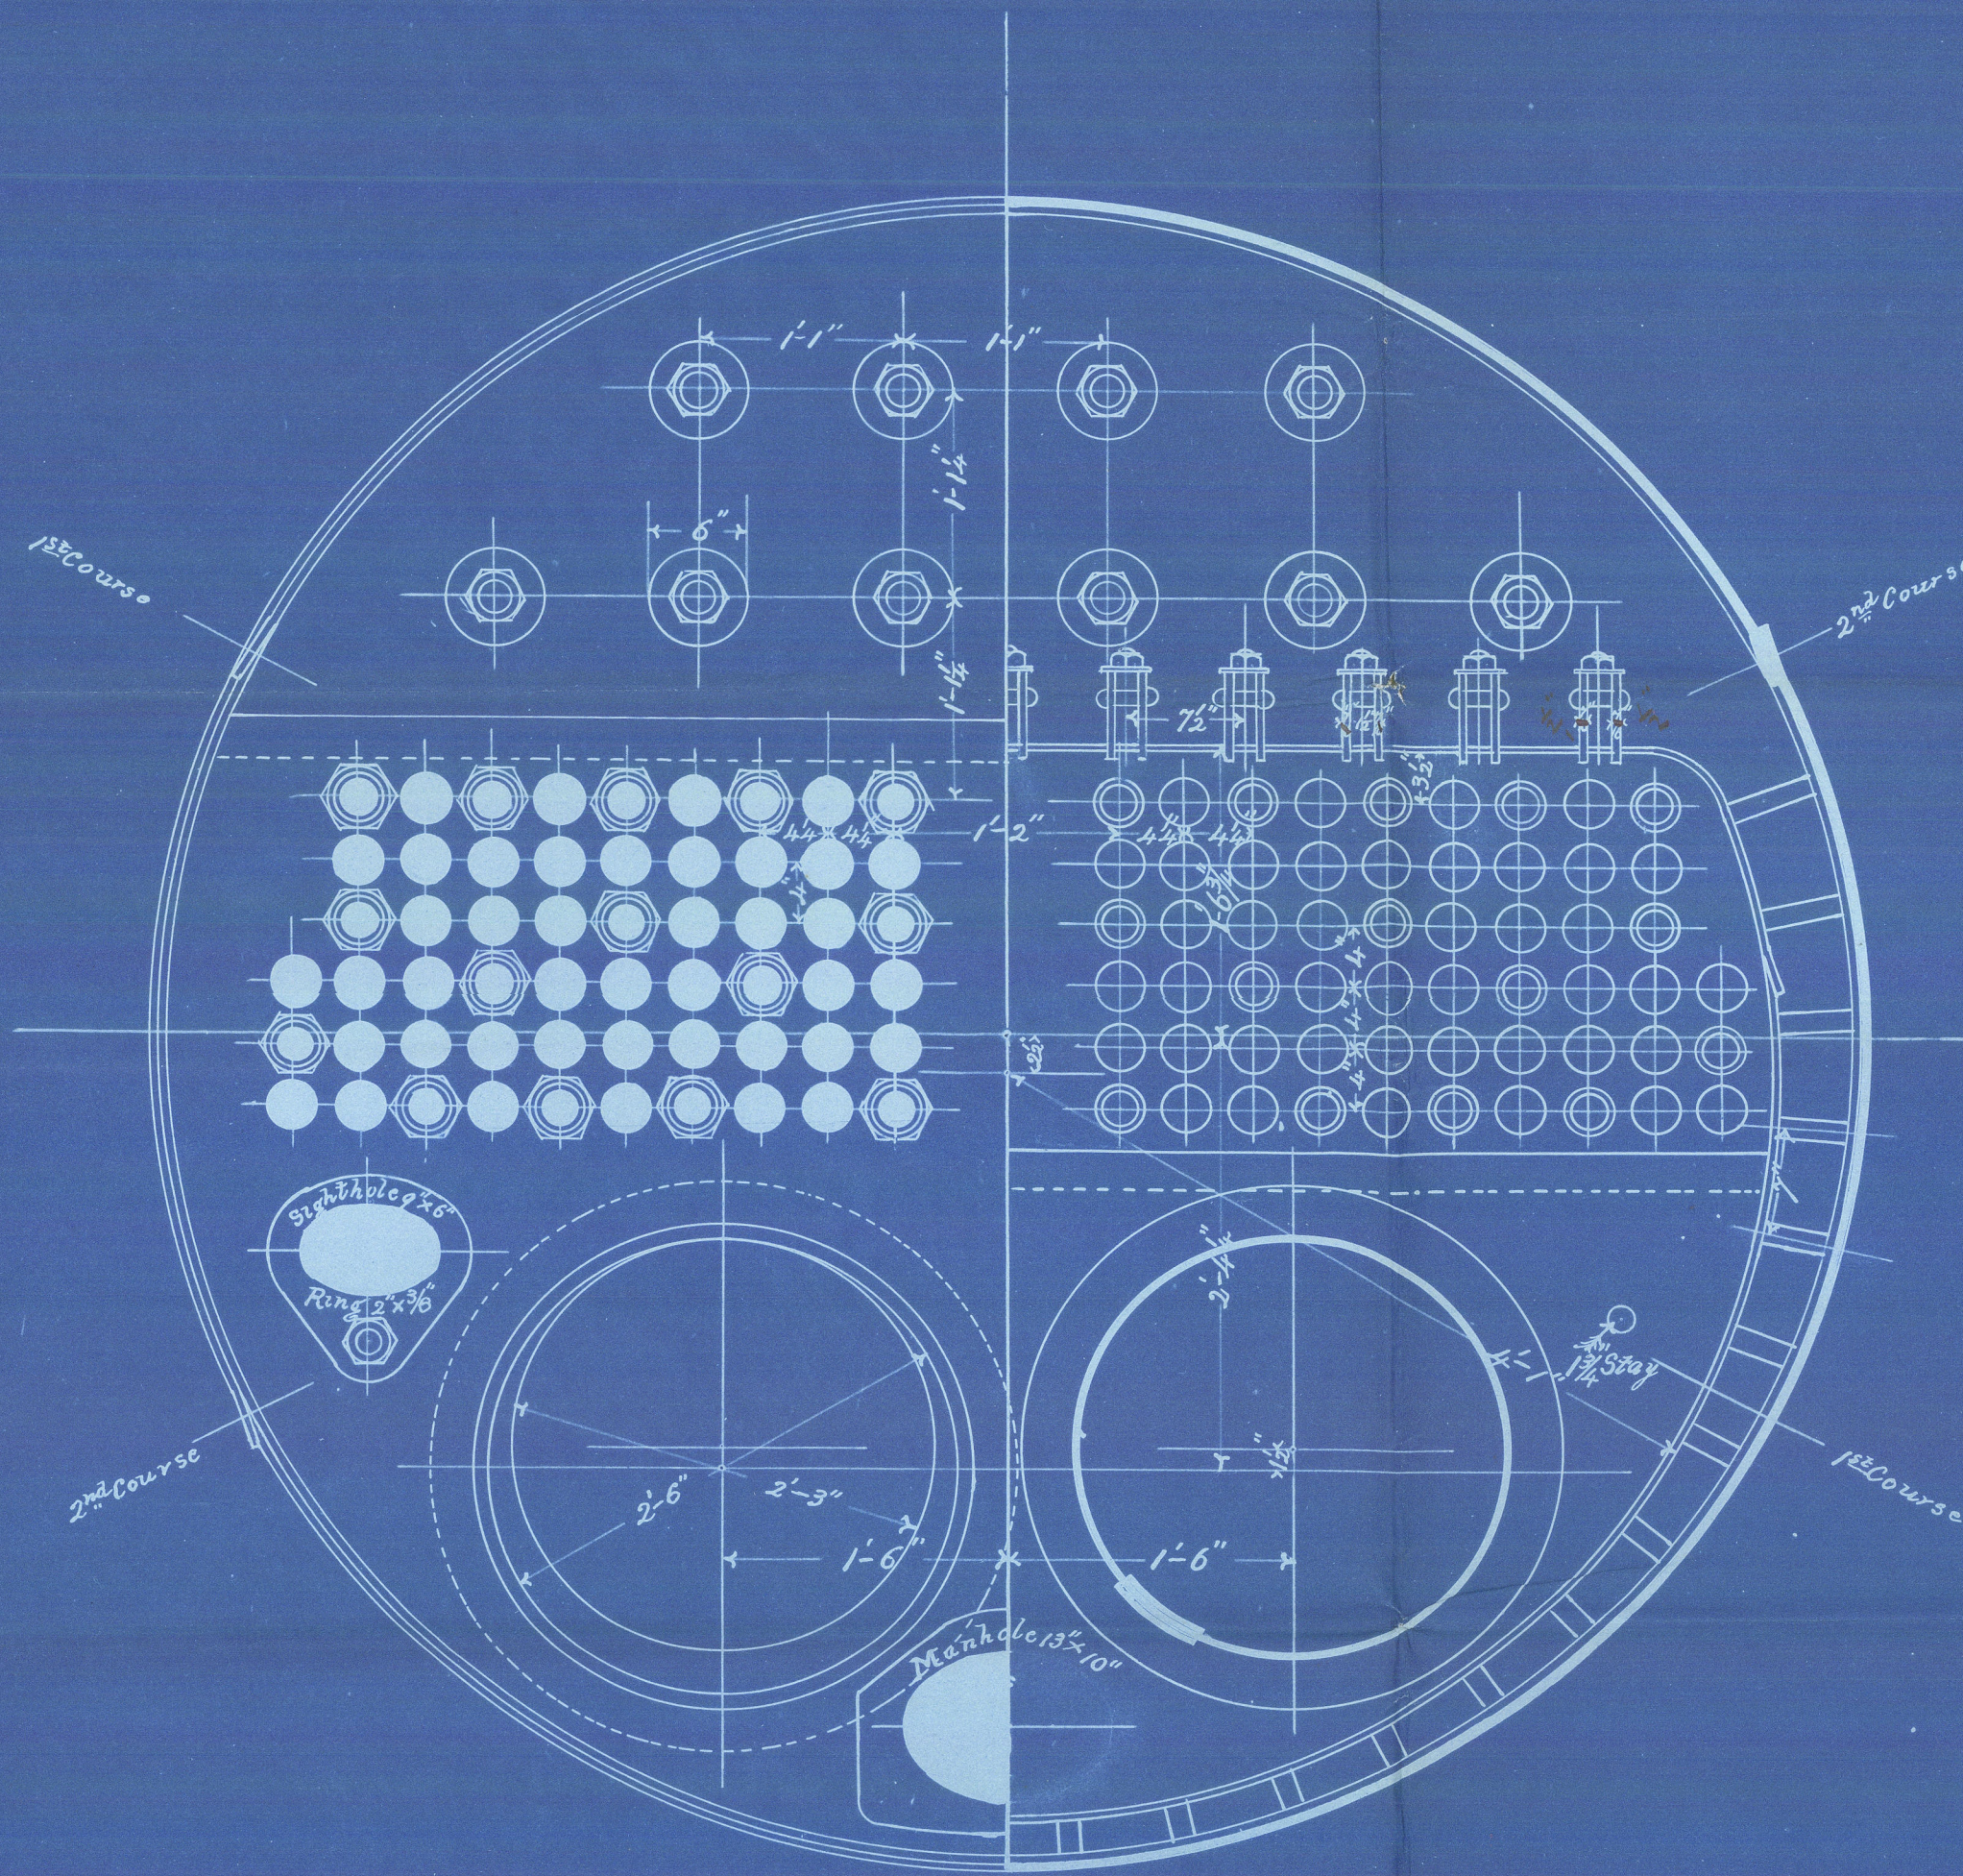

Note - Allocated stays in firebox to have nuts and washers on both ends


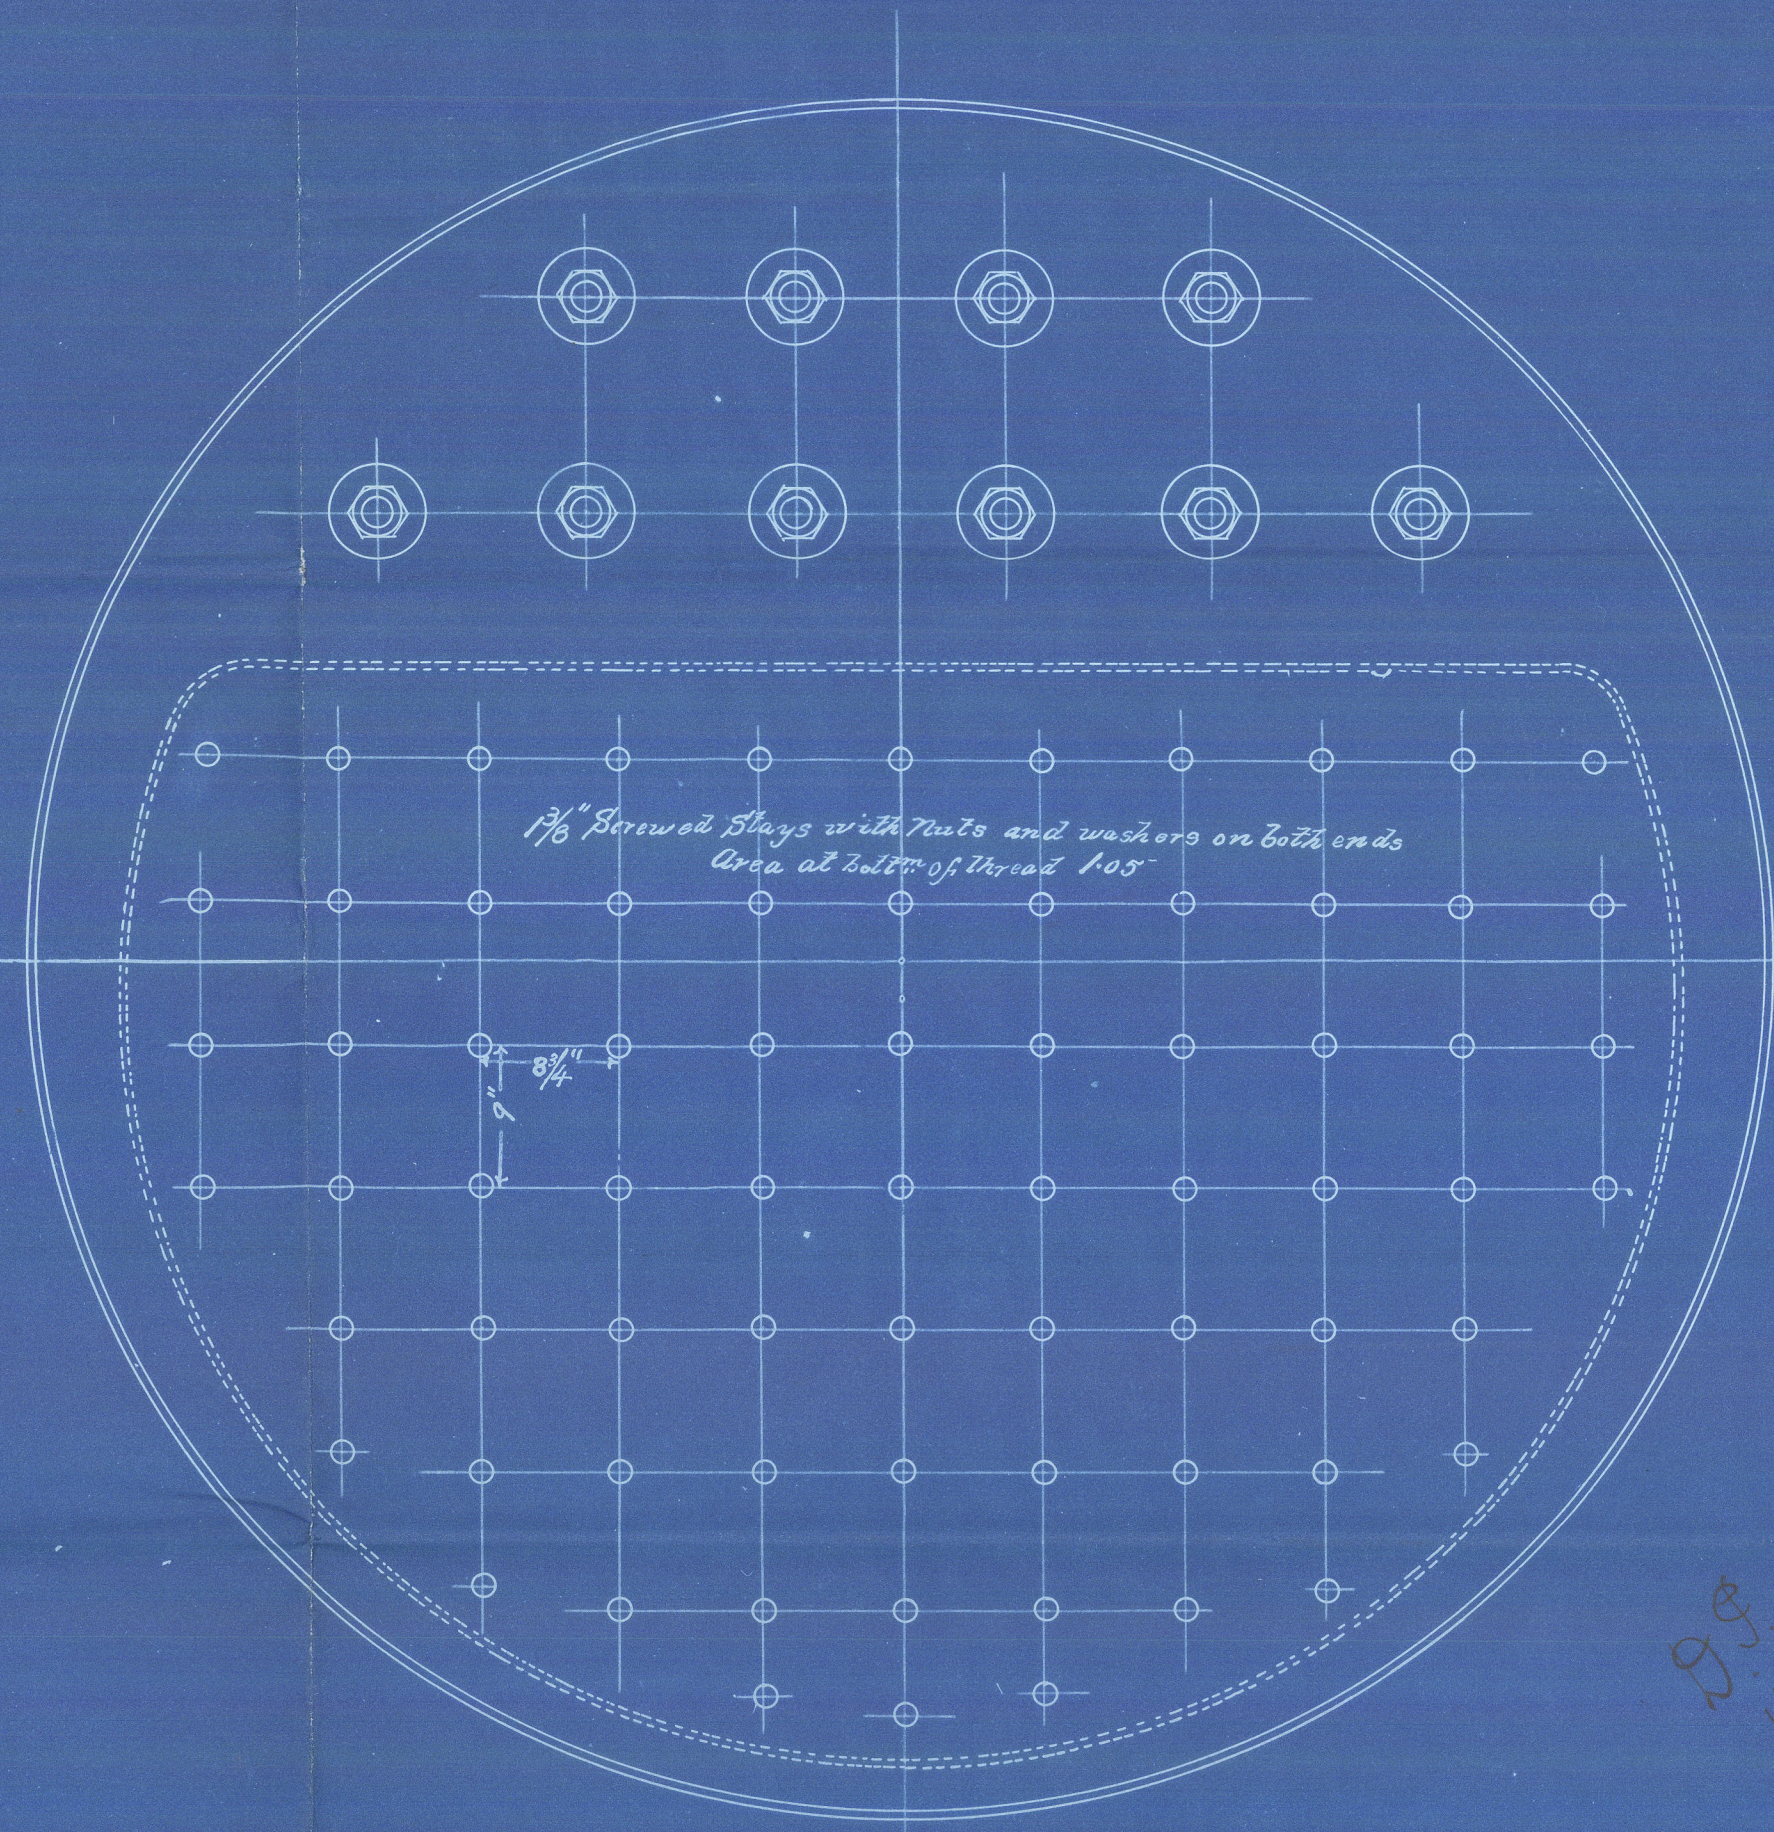


D.S.
11/4/84

For S.S. "Dewdrop"

Dundee report No 350

— **BOILER No 230** 9'-0" dia 7'-3" long —
— Scale 1" = 1 foot — 28th March 1884 —
— Working Pressure 80 lbs. per sq. inch —
— Boiler wholly constructed of steel excepting tubes & stays —

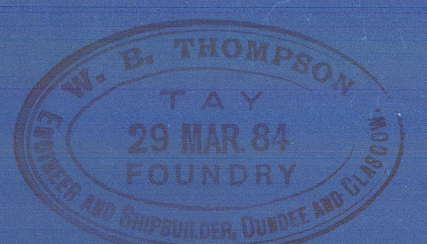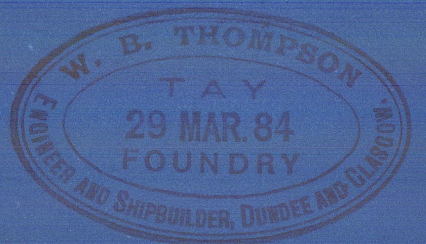

Recd 31/3/84
4-84