


Lt. & Dundee  
7/2/84

Profile & Deck Plan  
S.S. No 19  
Scale  $\frac{1}{8}$ th = a foot.

S.S. "Herald"  
Dundee report No 4752.

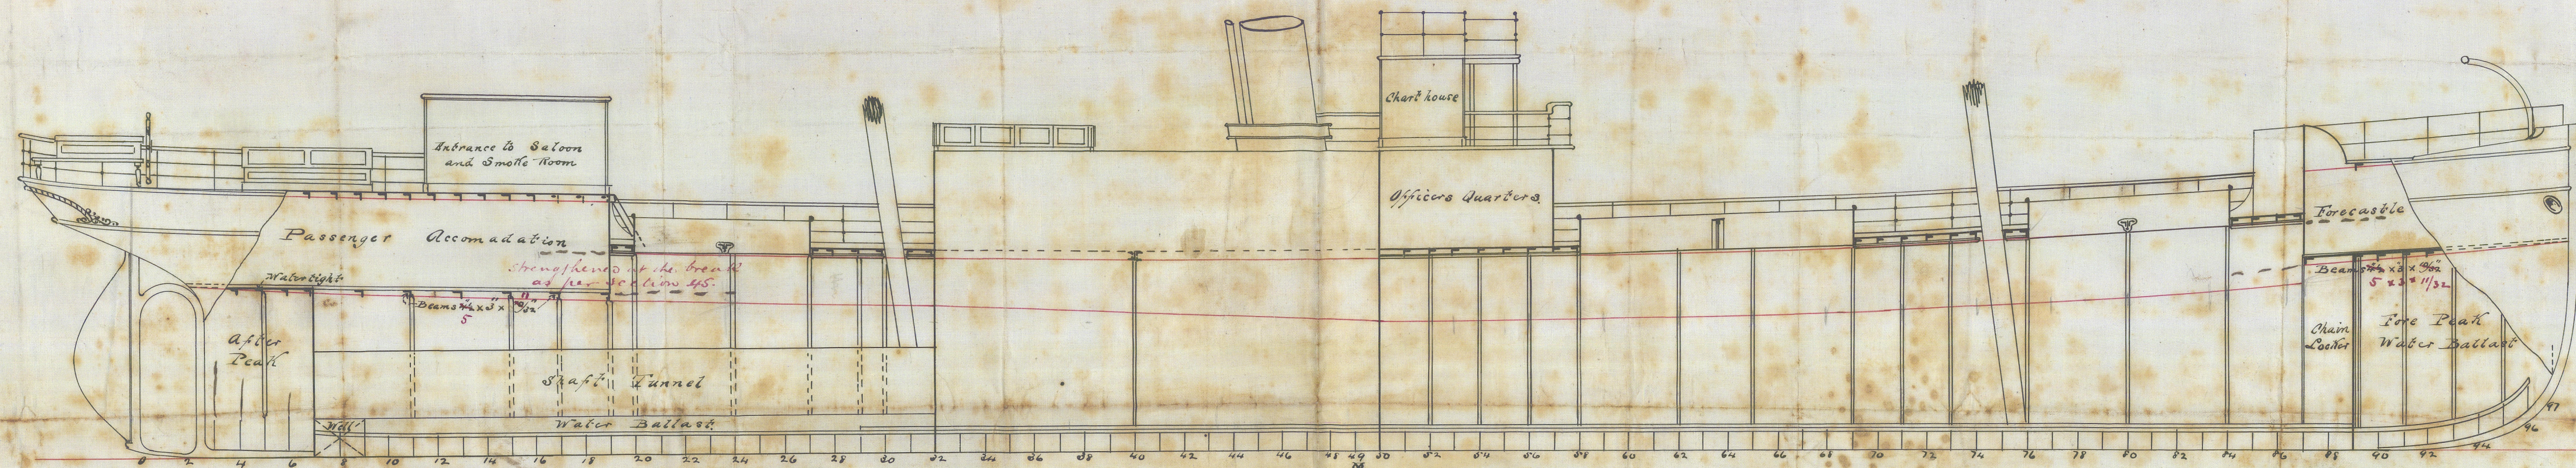

BM  
J.H.  
6/2/84



9.6  
© 2021

Lloyd's Register  
Foundation

DUN110-0229