

7/2/84.

Steel S. S. N^o 19

Special Survey


Scale $\frac{1}{2}$ " = a foot.

Dimensions

Length between perp ^{trs}	142' 0"
Breadth moulded	28' 0"
Depth do	13' 11"
Depth of hold to floors	13' 2 1/2"

S. S. "Herald"

Dundee report No 4752

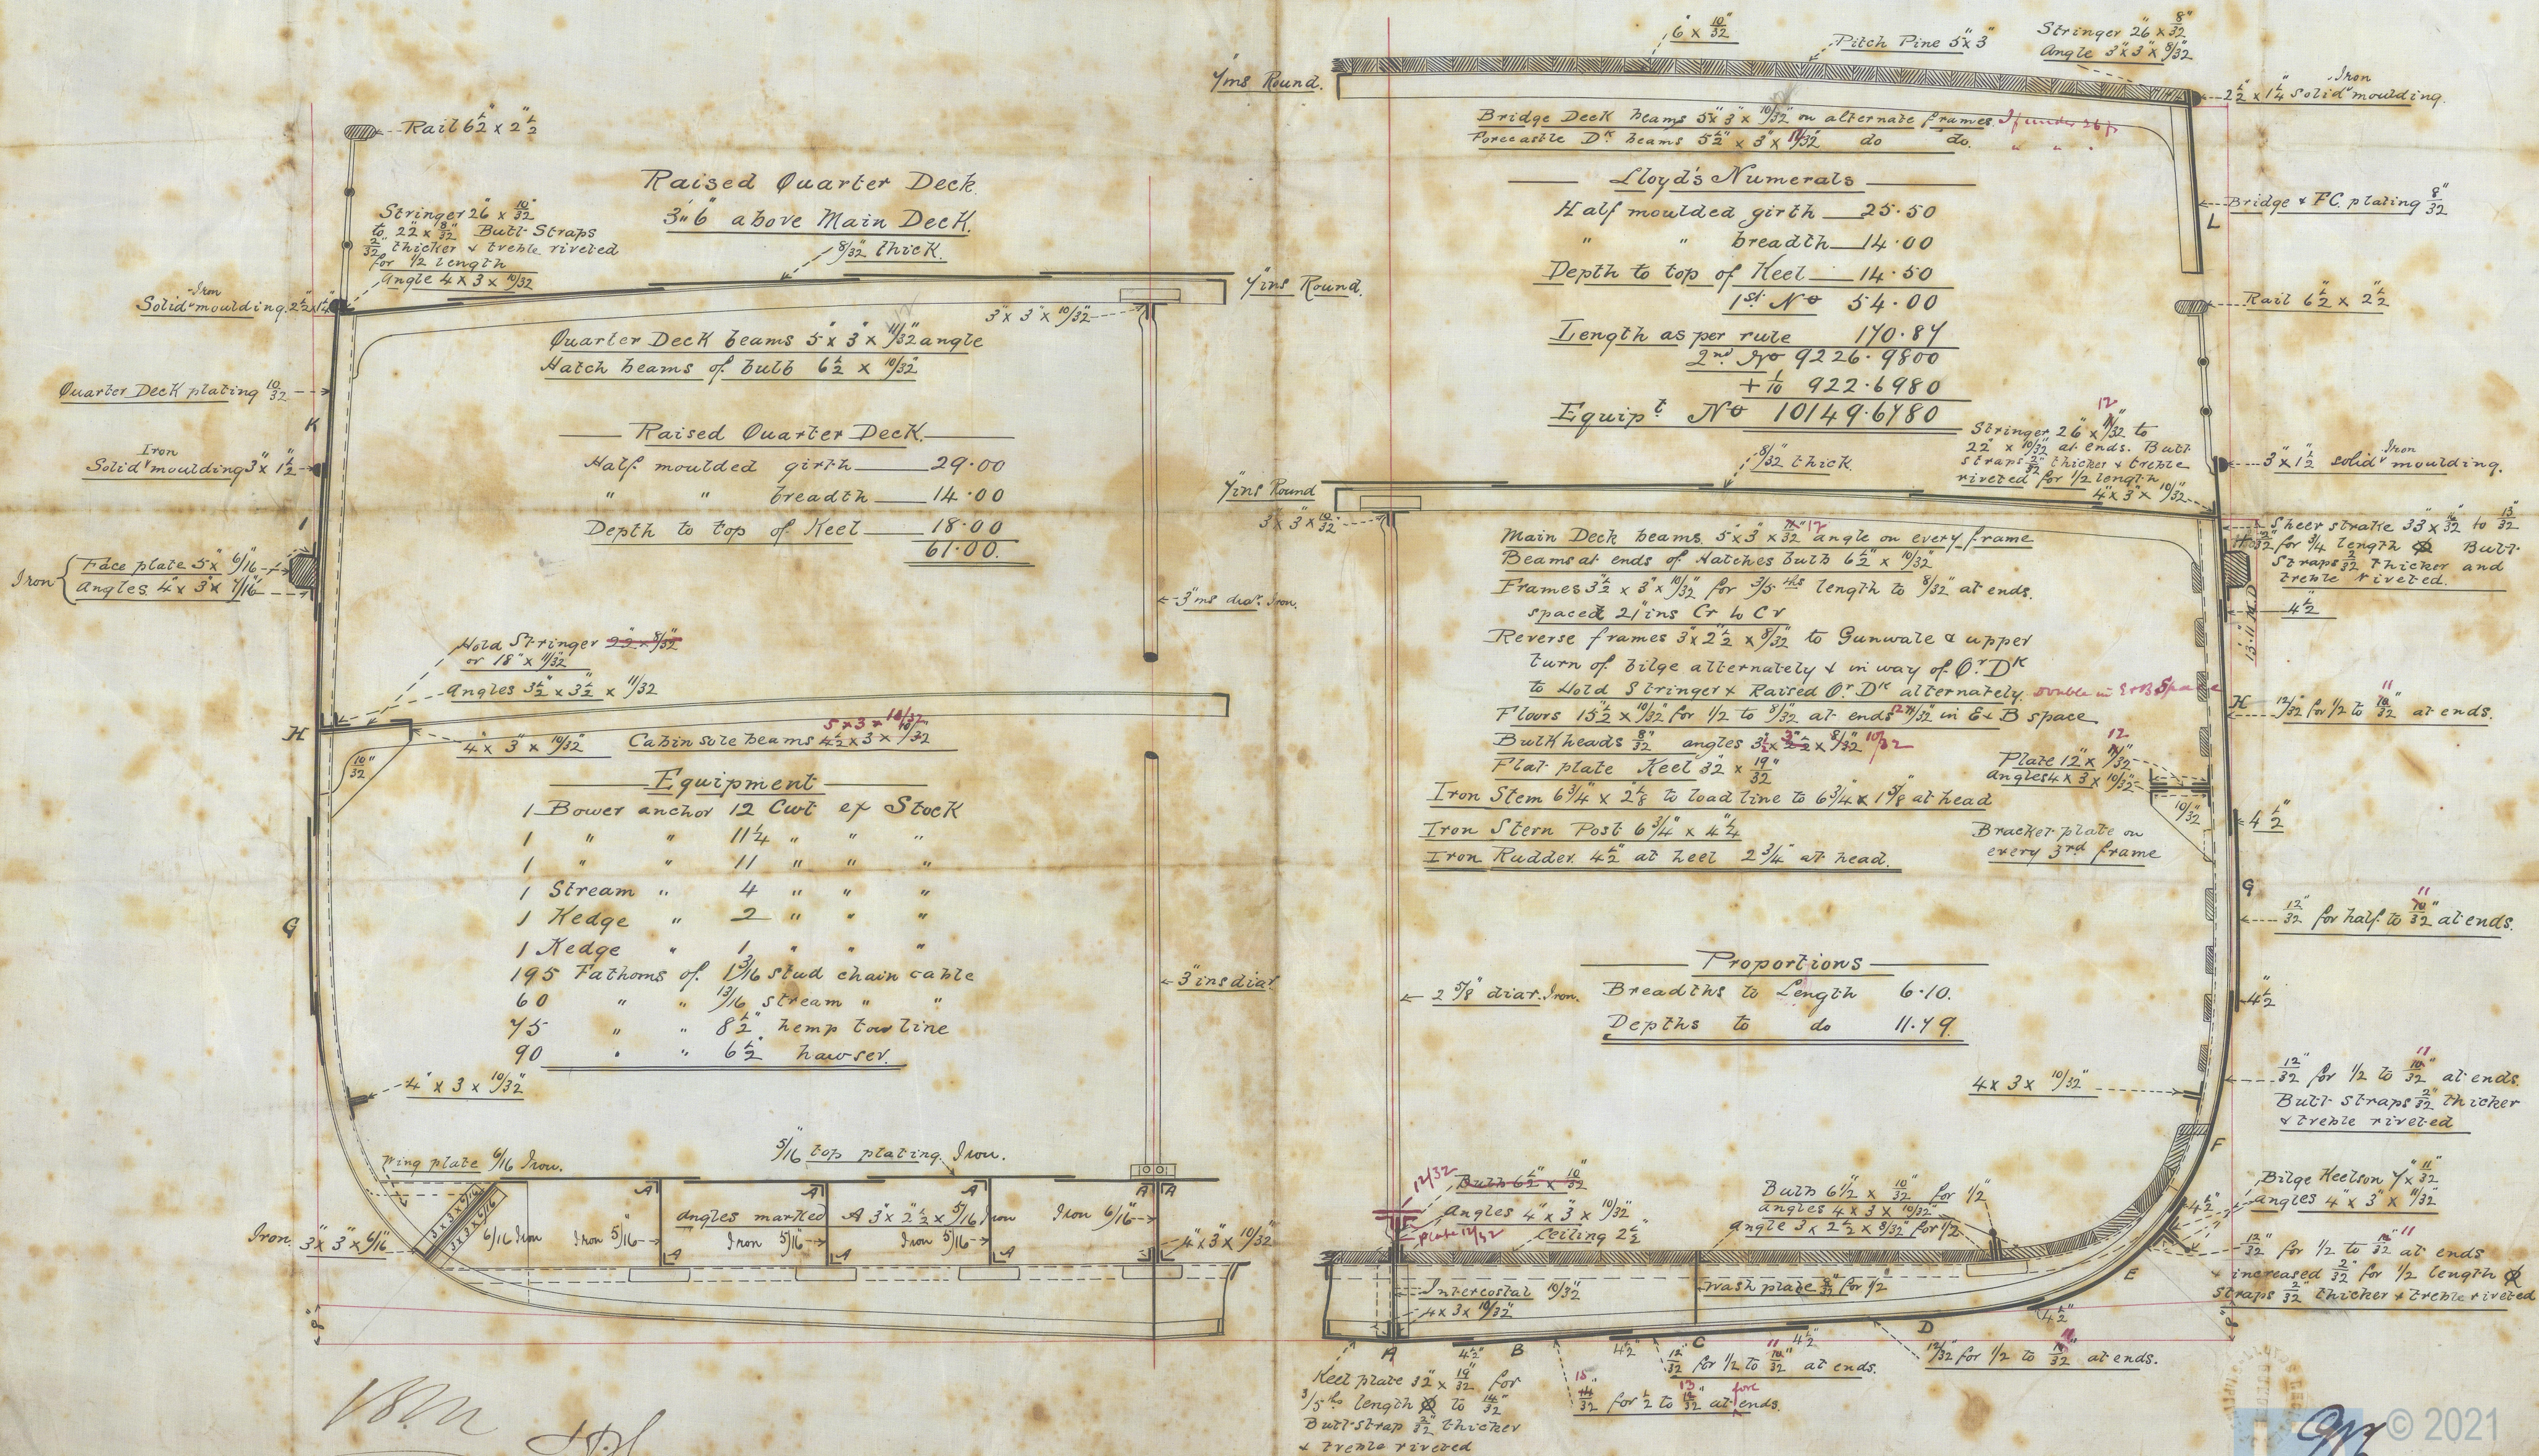

18m