

Midship Section
Steel Screw Steamer

S.S. "Shieldrake"

Dundee Report No. 4850


Let. to Dem
29.1.85.

13. 3. 85. (Proposed mtr.)
carried out

No 69



SCALE 1/2 INCH TO A FOOT

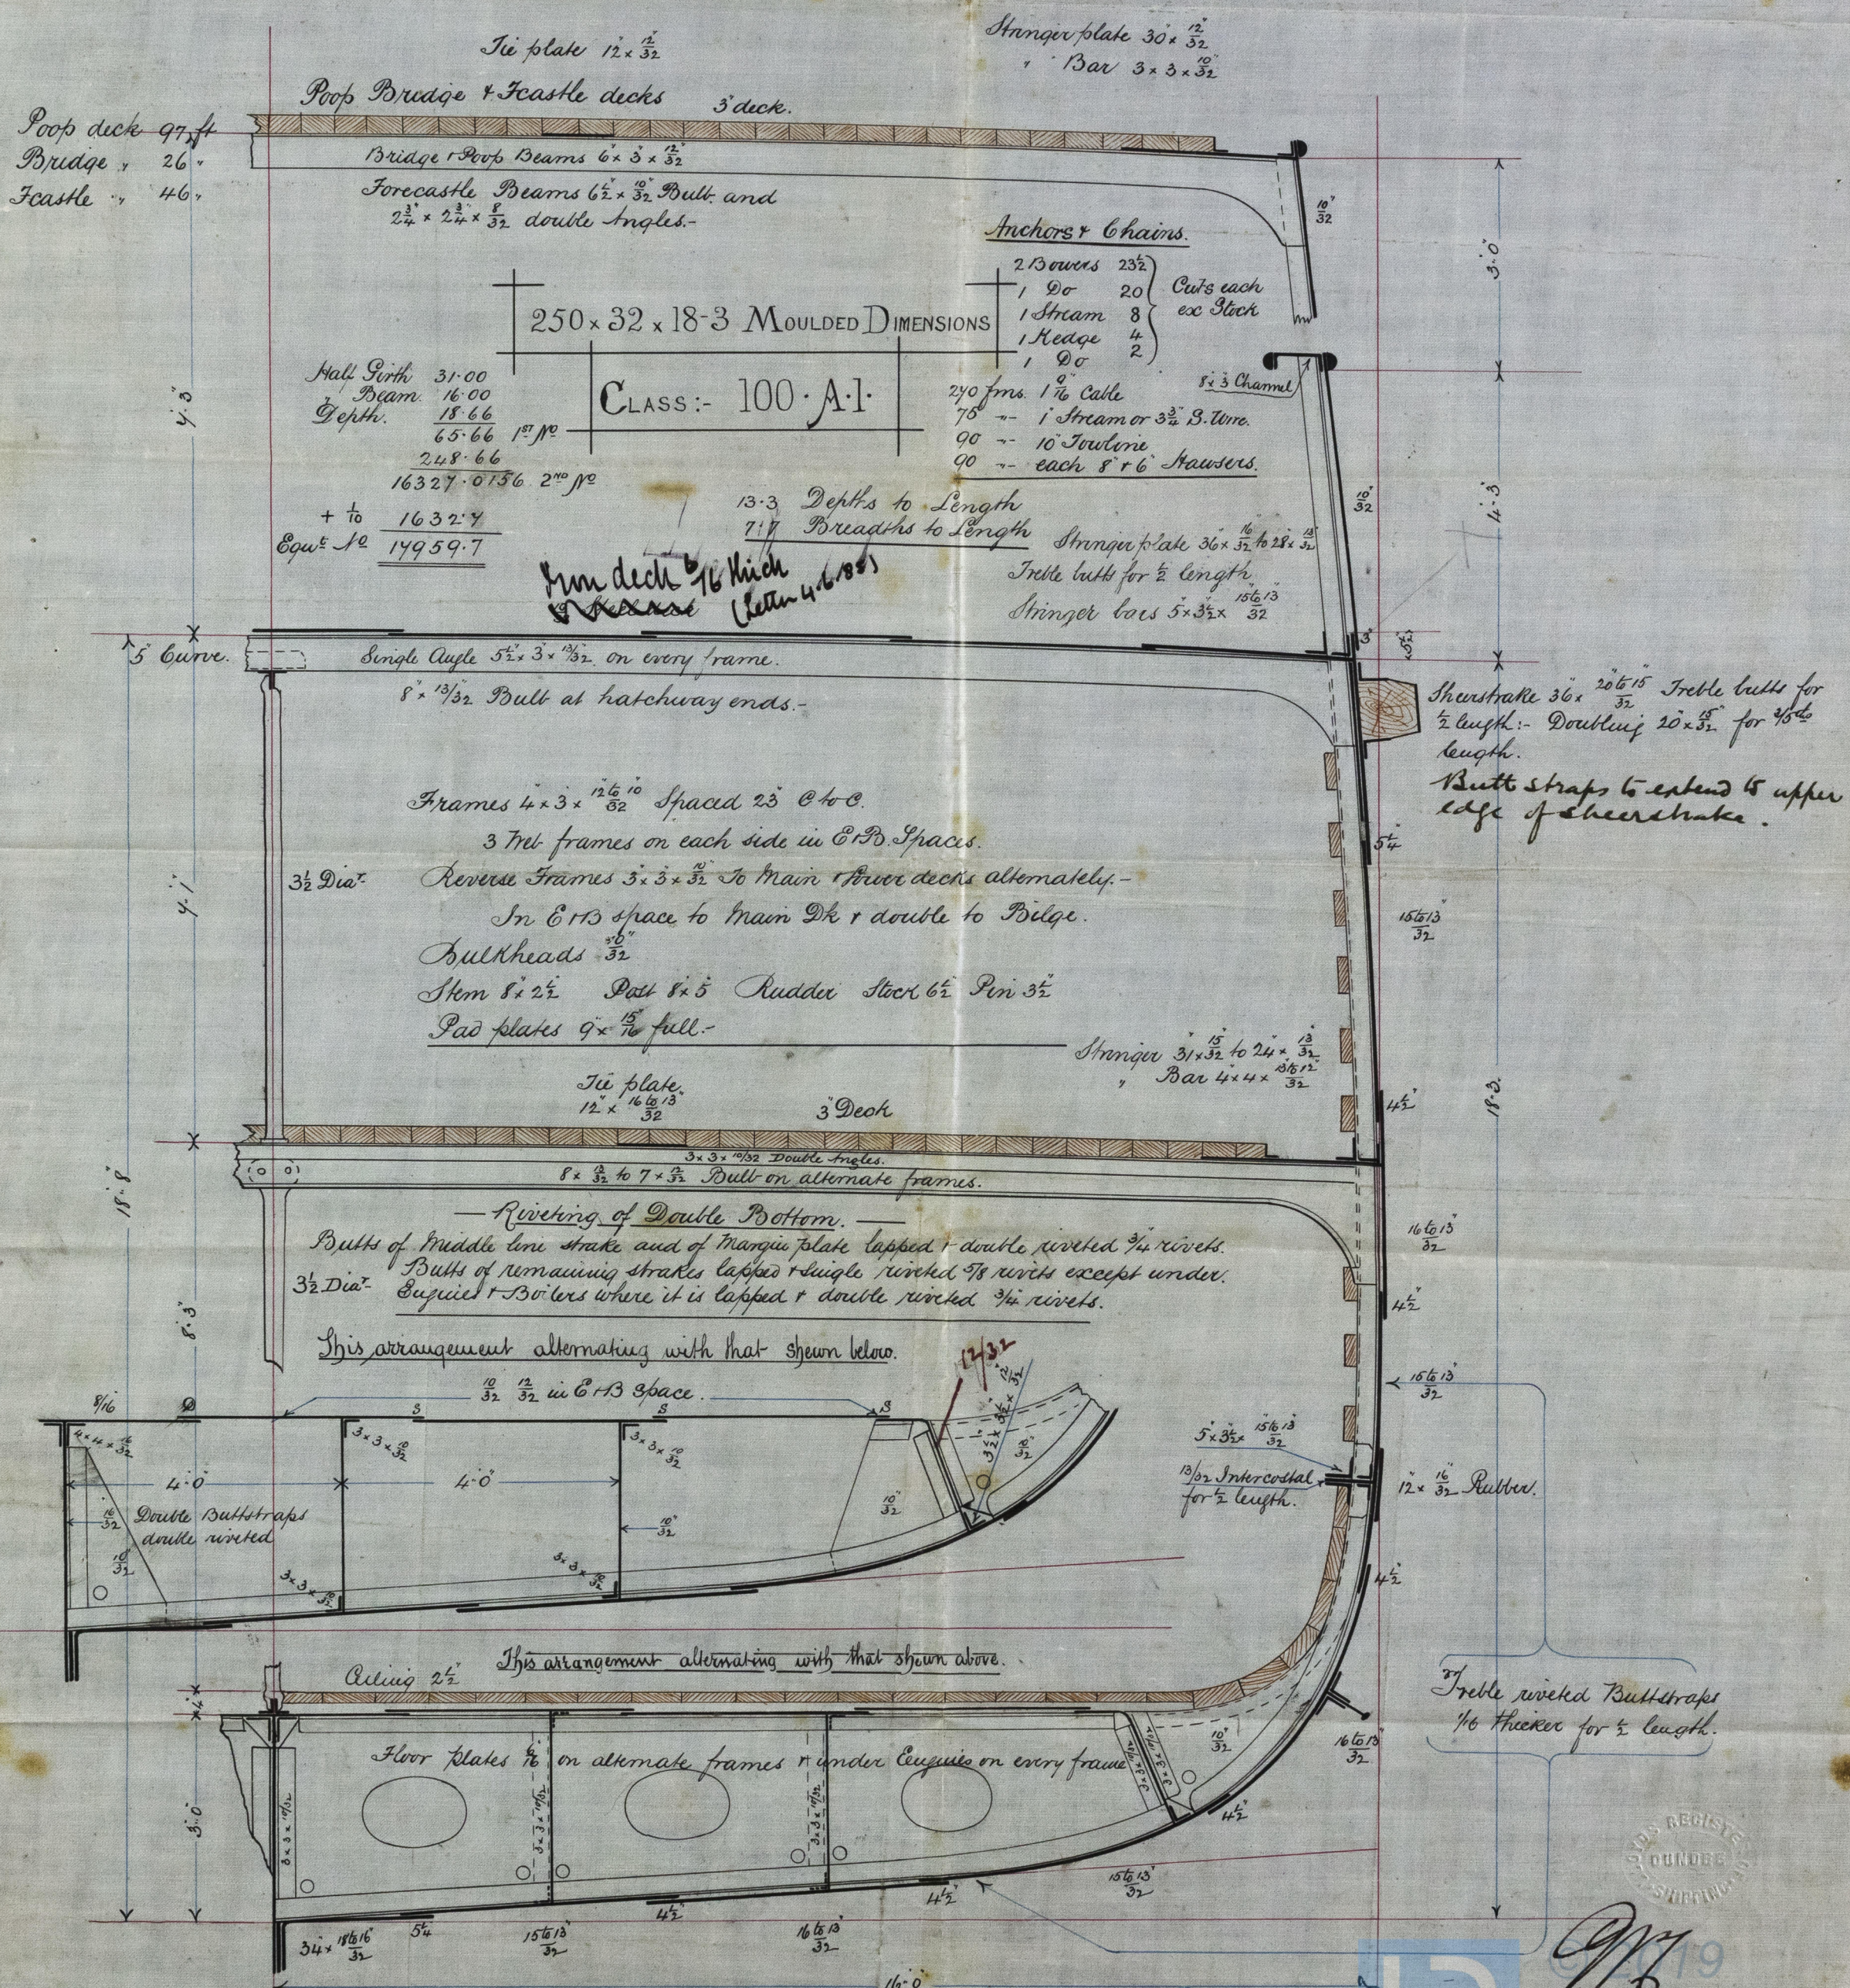

28/1/85



Q. 10

Lloyd's Register
Foundation

DUN210-0304