

# Lloyd's Register of British and Foreign Shipping.

(Report on Vessel No. 5034 Port Dundee)

No. 589a

## SHIP FORGINGS OR CASTINGS.

*S. S. Dean.*

I have to report that the undermentioned Iron or Steel Forgings or Castings, manufactured by Messrs The Darlington Forge Co of Darlington for the Vessel No. 129, being built by Messrs Gourlay Brothers of Dundee have been inspected by me as set forth below, and found to be, so far as can be seen, sound.

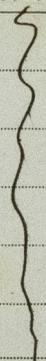
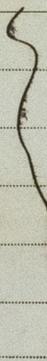
The words FORGINGS or CASTINGS, IRON or STEEL, should be struck out as may be required.

Mark on Forgings.

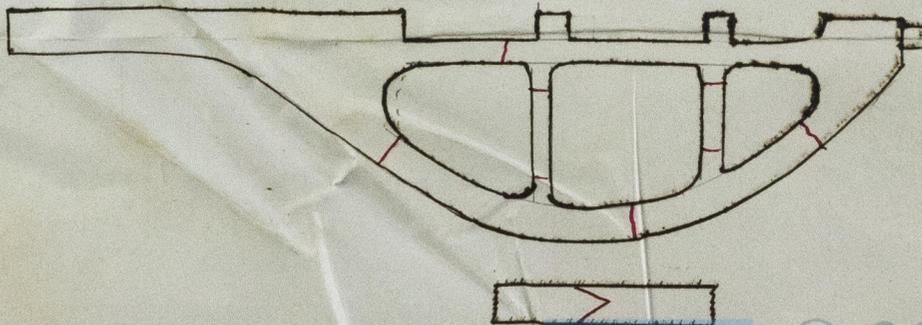
Lloyd's  
No. 589a  
No. 6

*Hugh Cameron*

*Sundaland  
2/5/84*

	STERN FRAME.	RUDDER FRAME.	STEM.
Material* - - - -		<i>Scrap iron</i>	
How made - - - -		<i>Forged</i>	
Dimensions - - - -		<i>5 3/4 - 3</i>	
Progress on Inspection -		<i>Forged Smithed</i>	
Dates when Inspected		<i>March 7-11-14-19-23 April 1-16-20-22/84</i>	

SKETCHES OF FRAMES SHEWING POSITION AND DESCRIPTION OF WELDS OF FORGINGS, OR PARTICULARS OF TESTS APPLIED TO CASTINGS.



\* If of Iron, state whether scrap or puddled iron.