


SS Dean
Drum Dep: 5037

Longitudinal Section
 Steel Screw Steamer No 129
 Scale $\frac{1}{8}$ Inch = 1 Foot.

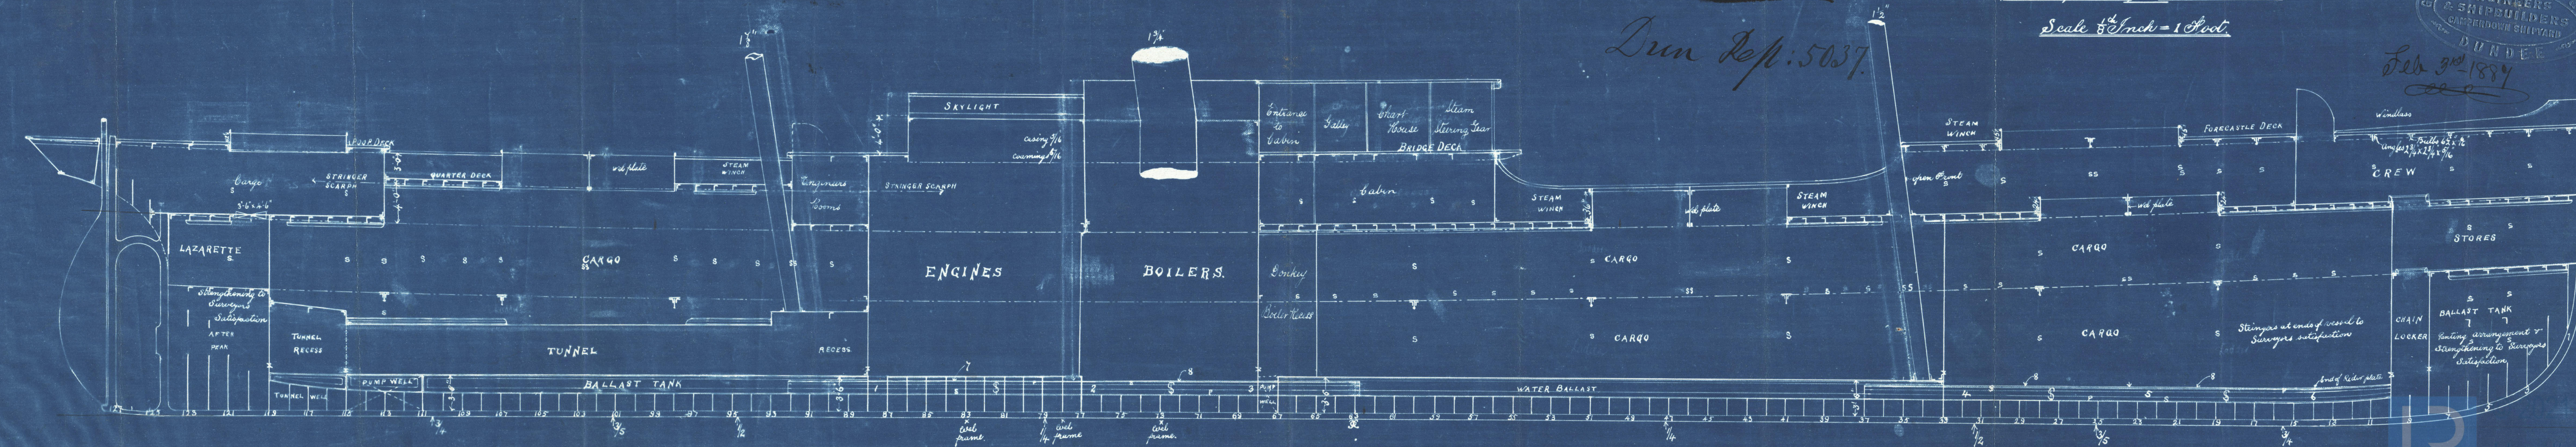

Lough Section
9 No 129

Amended

DUNM - 0210



© 2021

Lloyd's Register
Foundation