GOURLAY BROTHERS & Co
ENGINEERS
& SHIPBUILDERS
CAMPERDOWN SHIPYARD
DUNDEE

11.11.86.
224/12/86

S. S Dean.

Dun. Rep. 5031.

Longitudinal Section

Steel Screw Steamer No 129

Scale ⅛th Inch = 1 Foot

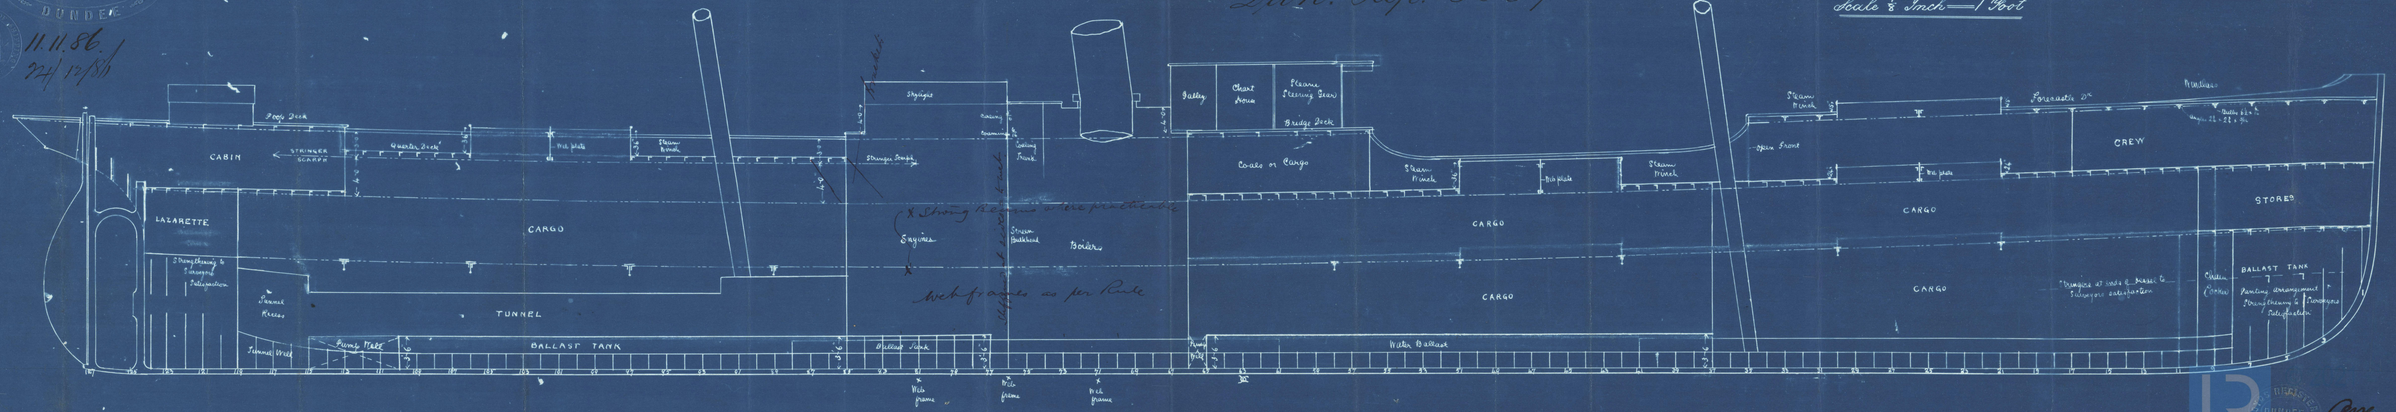

9/11/86