

- Class 100 A -


November 1886

Dun. Rep. 5037.

Dun. Rep. 5037.

11. 11. 86.

24/12/86

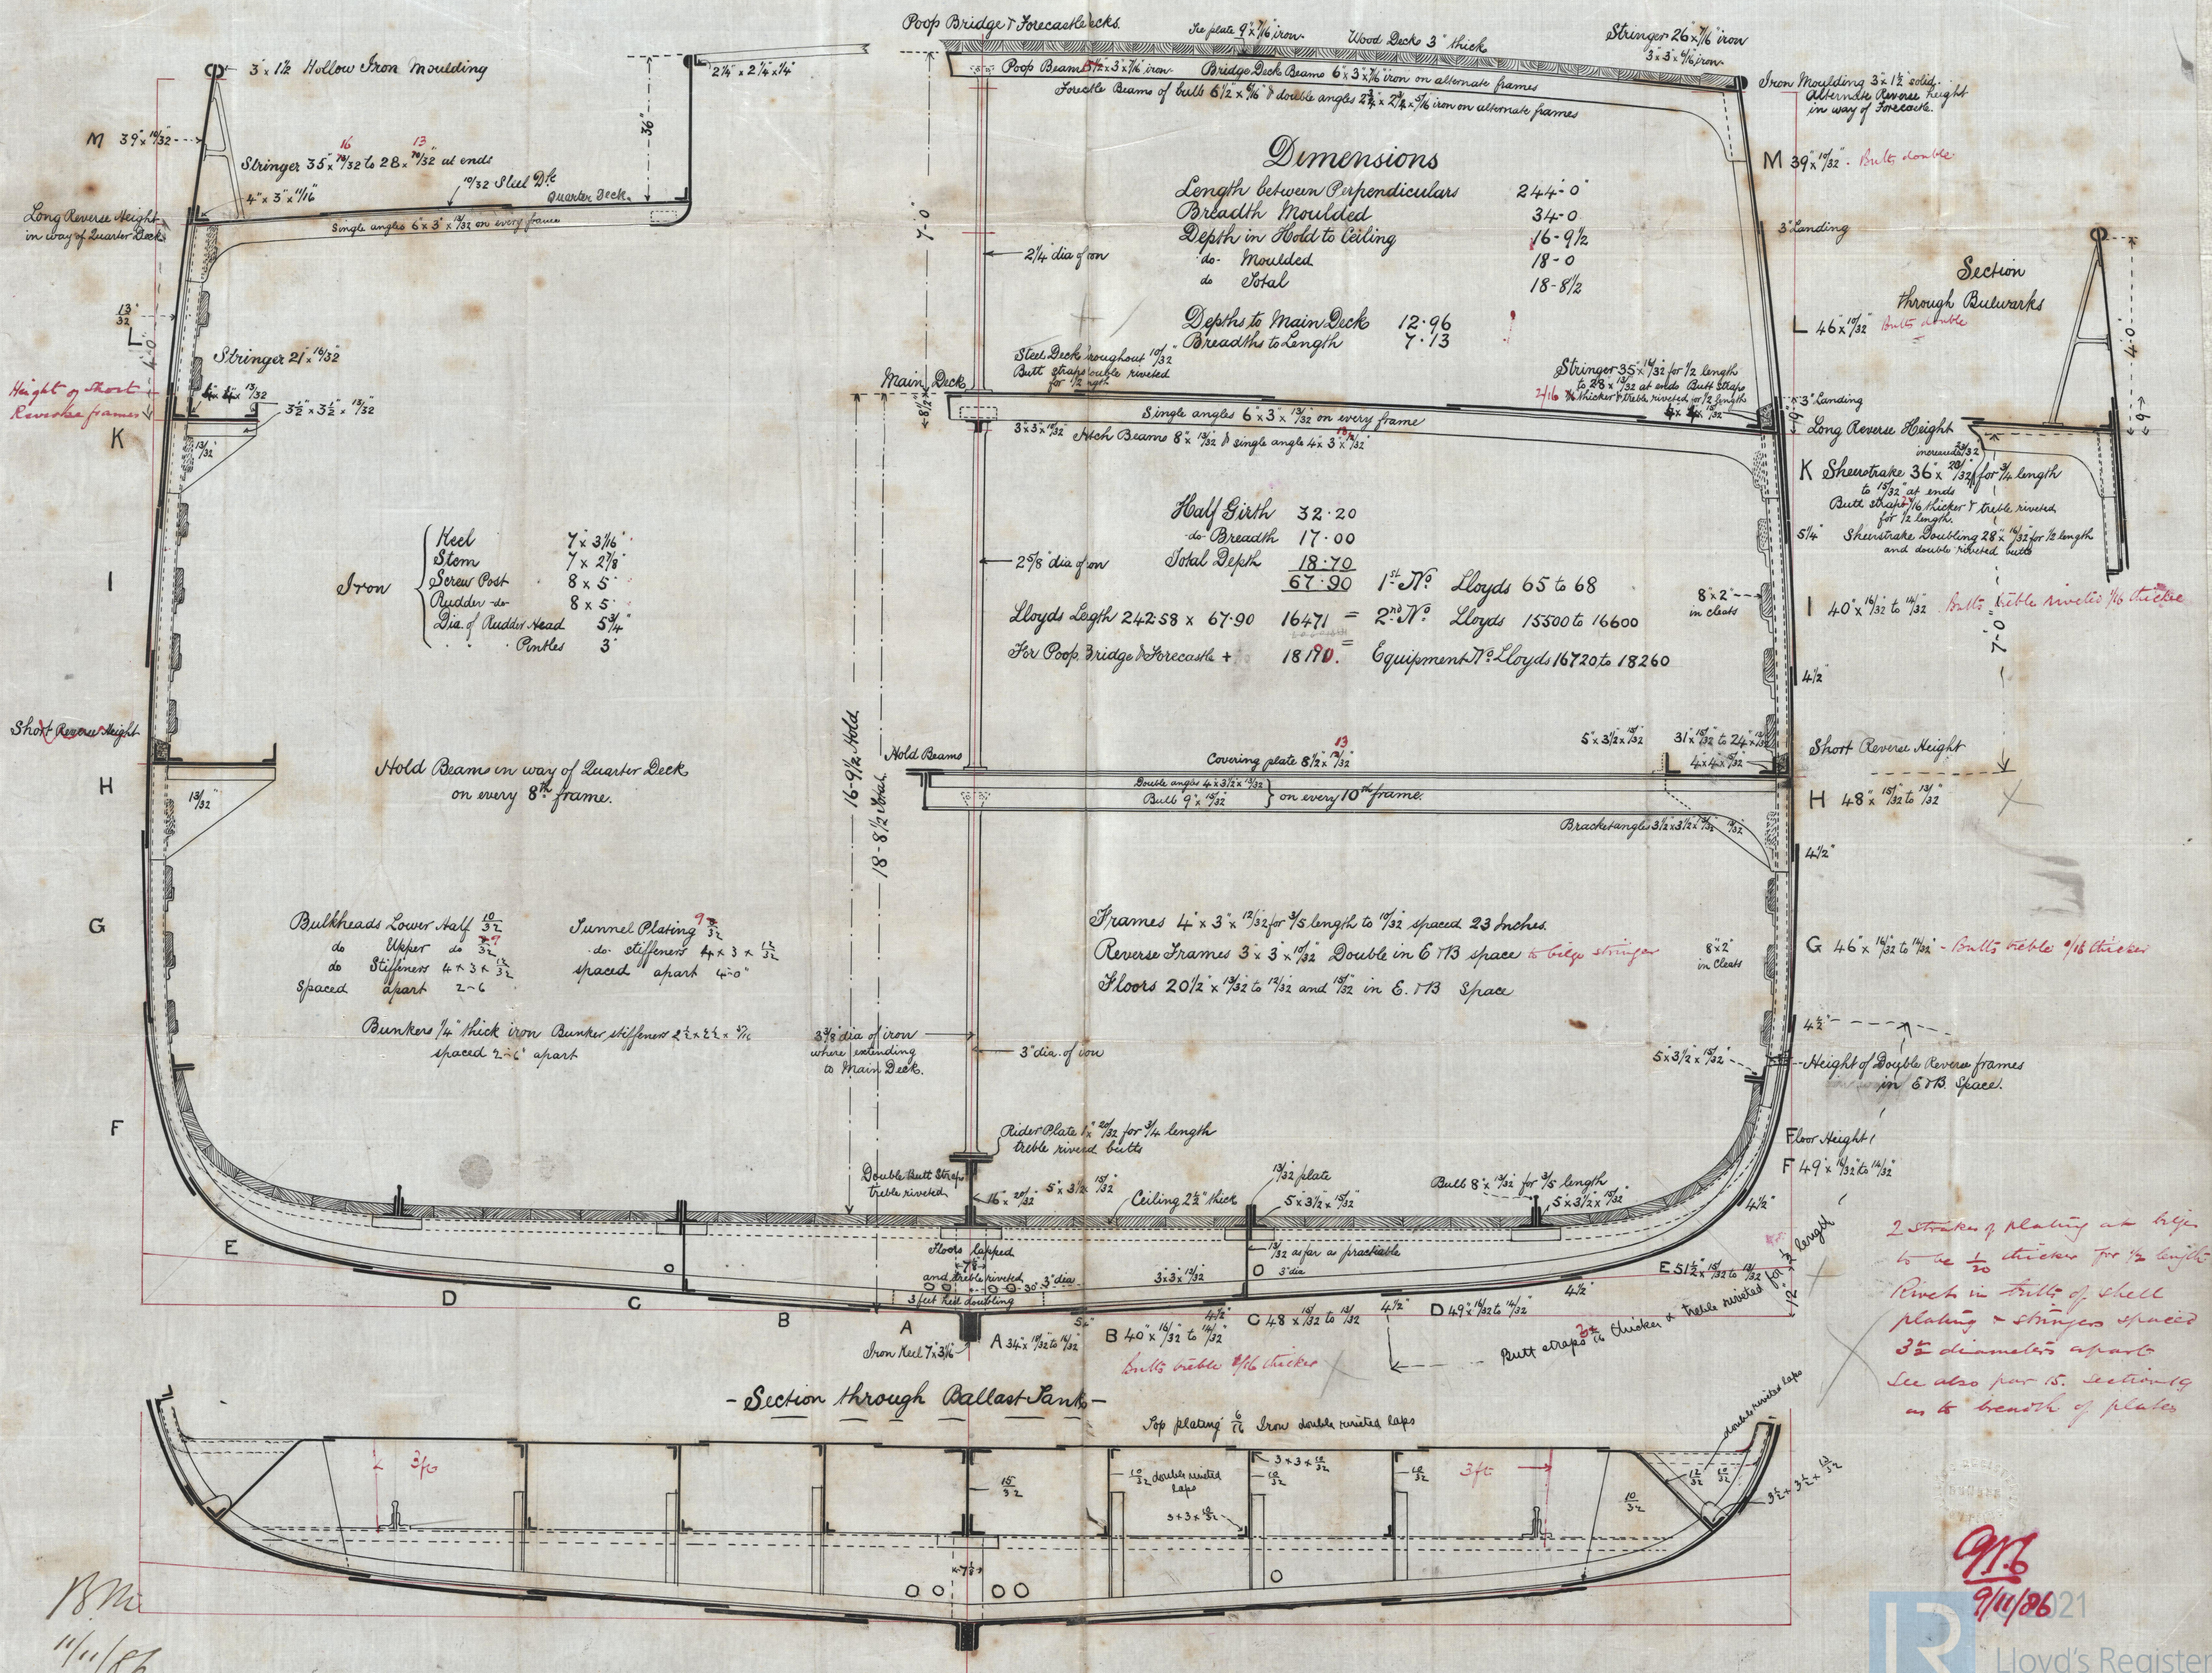

2 Stripes of plating at right  
to be  $\frac{1}{20}$  thicker for  $\frac{1}{2}$  length  
Rivets in middle of shell  
plating & stringers spaced  
 $3\frac{1}{2}$  diameters apart  
See also par 15. Section 19  
on to breadth of plates

916

9/11/86

9/11/2021

**LR** Lloyd's Register Foundation

DUN III - 0212