

26. 19/2/87

S-S- Portland-  
244 18.2.87


# STEEL BOILER.

Size of Rivets	1 1/16"
Pitch	8 1/4"
Strength of Plate at Joint	84.2% 84.1
" Rivets	85.5%
Heating Surface - Tubes.	1108
" Furnaces	157
" Chamber.	255
Total.	1500.

Note All plates & shell rivets of Steel  
other rivets of Miller's best Yorkshire iron  
All stays & tubes of iron

Handwritten  
shortened off.  
A.B.

W.B. THOMPSON & CO. L<sup>td</sup>  
ENGINEERS & SHIPBUILDERS  
DUNDEE

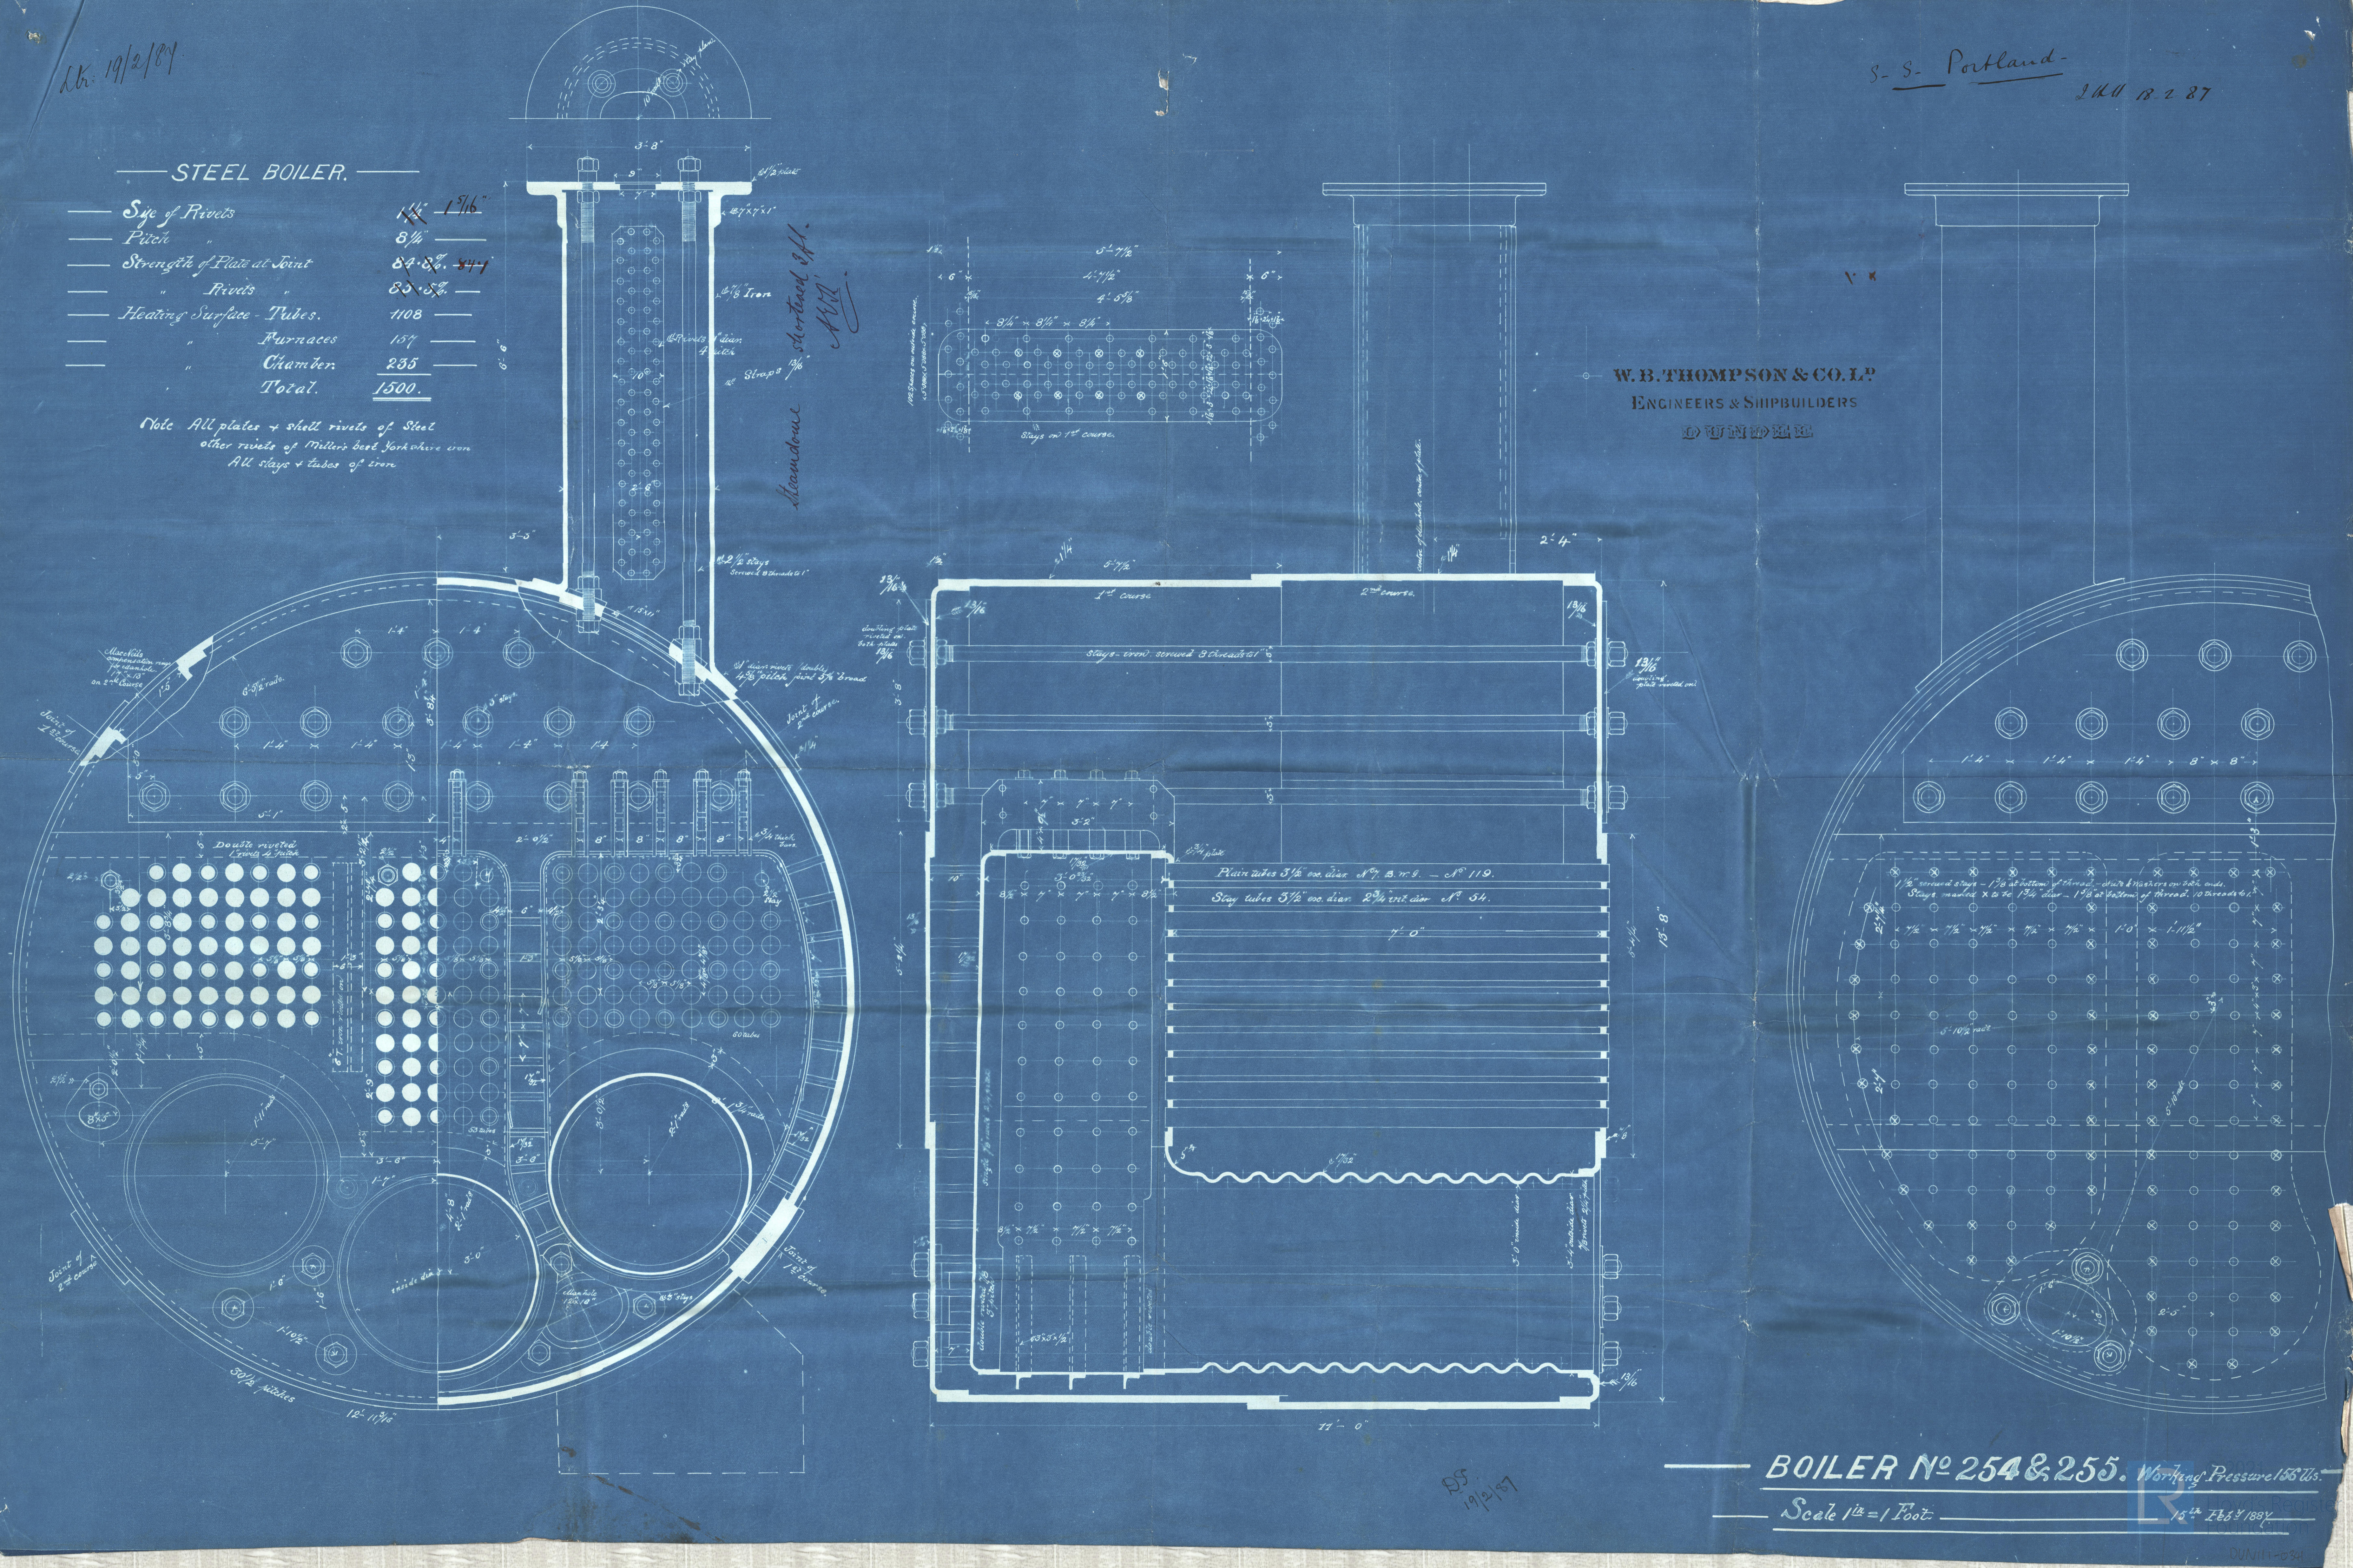

BOILER No 254 & 255. Working Pressure 158 lbs.

Scale 1/4" = 1 Foot

15th Feb 1887

25  
19/2/87

DUNDEE

S. S. "Portland"

156 U.S.

Boilers N<sup>o</sup> 254 & 255

Ship N<sup>o</sup> 81.

DUNIII-0341



© 2021

Lloyd's Register  
Foundation