

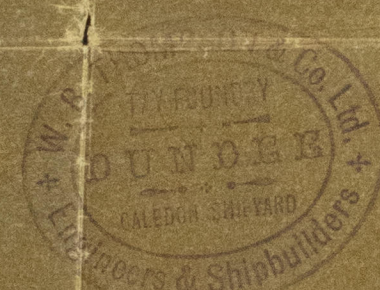


14.4.87.
22.4.87.

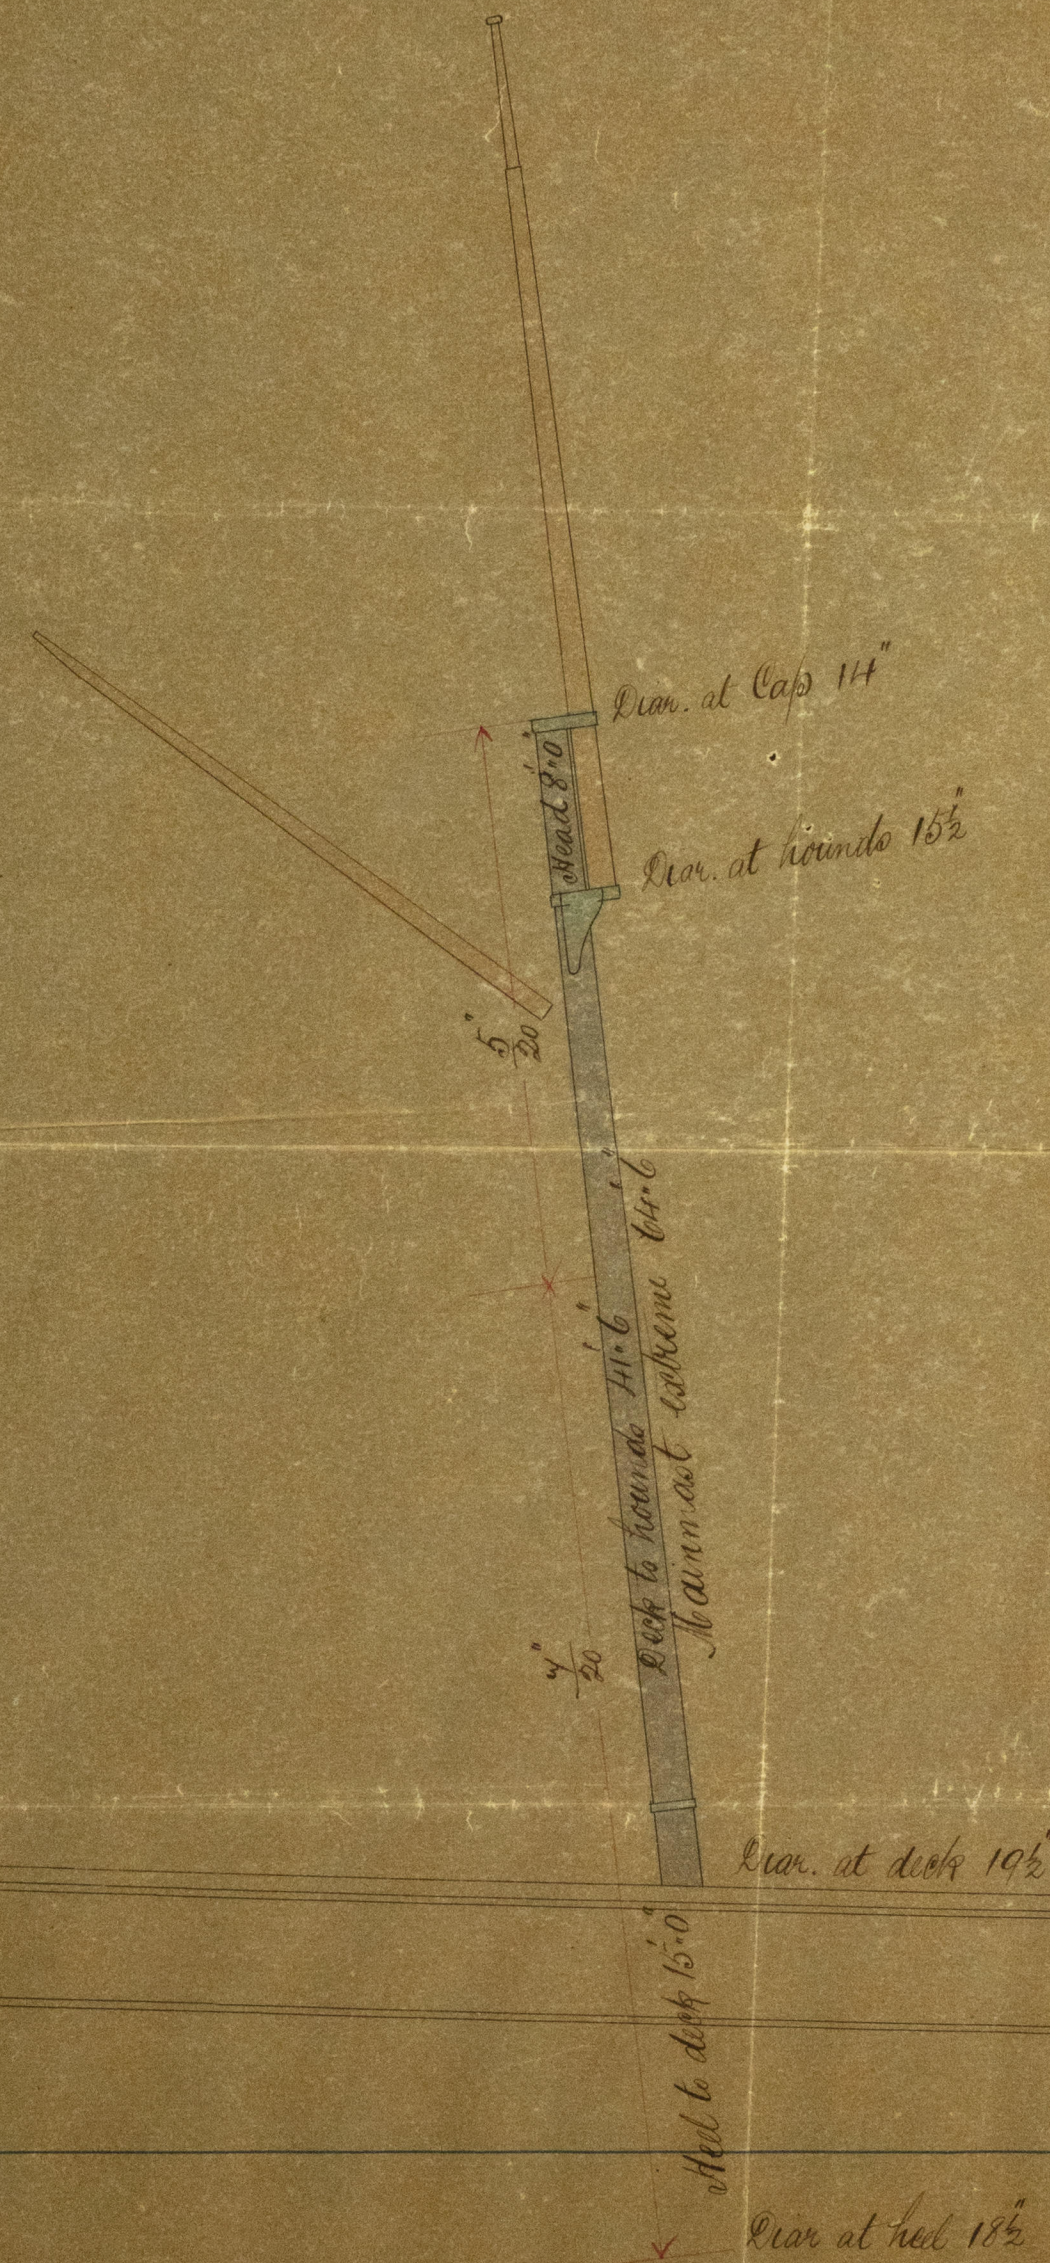

11/4/87

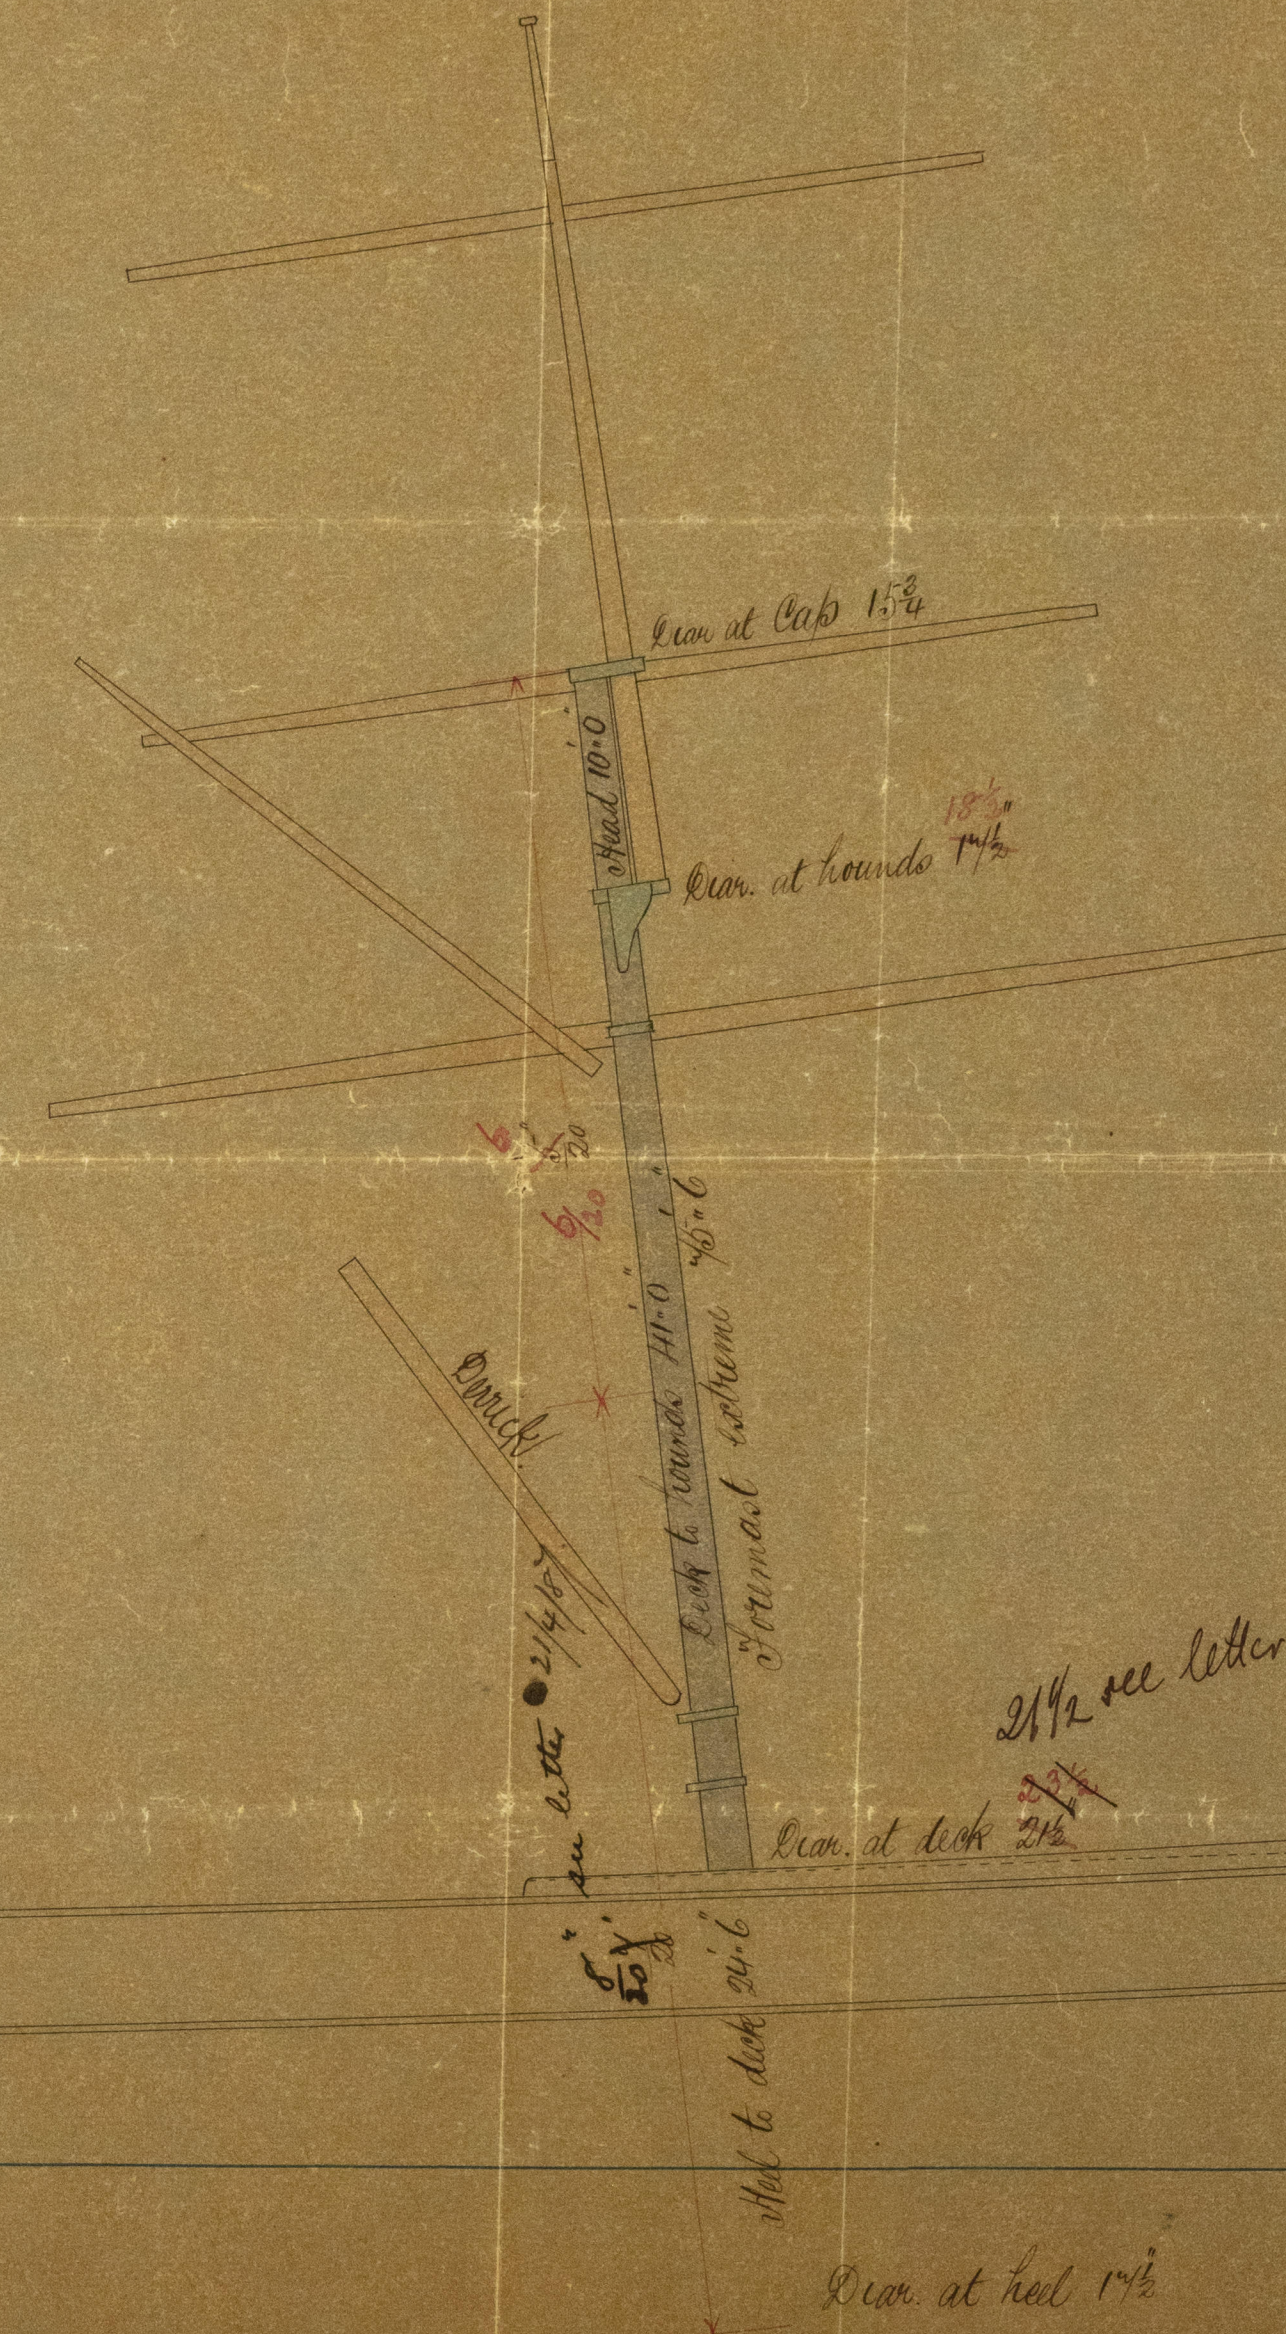

Steel Masts
S. S. No 81.

SCALE 1/8 INCH TO A FOOT

Fore and Main lowermasts of Steel
Two plates in the round: no angles
beams double riveted throughout } 5/8 rivets
all bulwarks triple riveted 3/4\"/>

21 1/2 see letter of the 22nd April 1887.

J.H.L.
13/4/87

J.H.L.
21/4/87