

Amended.

Longitudinal
Section of
Engine & Boiler
Space
of
S.S. No. 143.

Gourlay Bros. & Co.

S.S. "Hirondelle"

Dundee

Report No. 5381.



© 2019

Lloyd's Register
Foundation

DUN114-0276


S. S. 'Hirondelle'

Report No. 5381

Longitudinal Section
S. S. No. 143
Scale $\frac{1}{4}" = 1 \text{ Foot}$

10/3/90.

THU 13 MAR 90
TIME 13 MAR 90

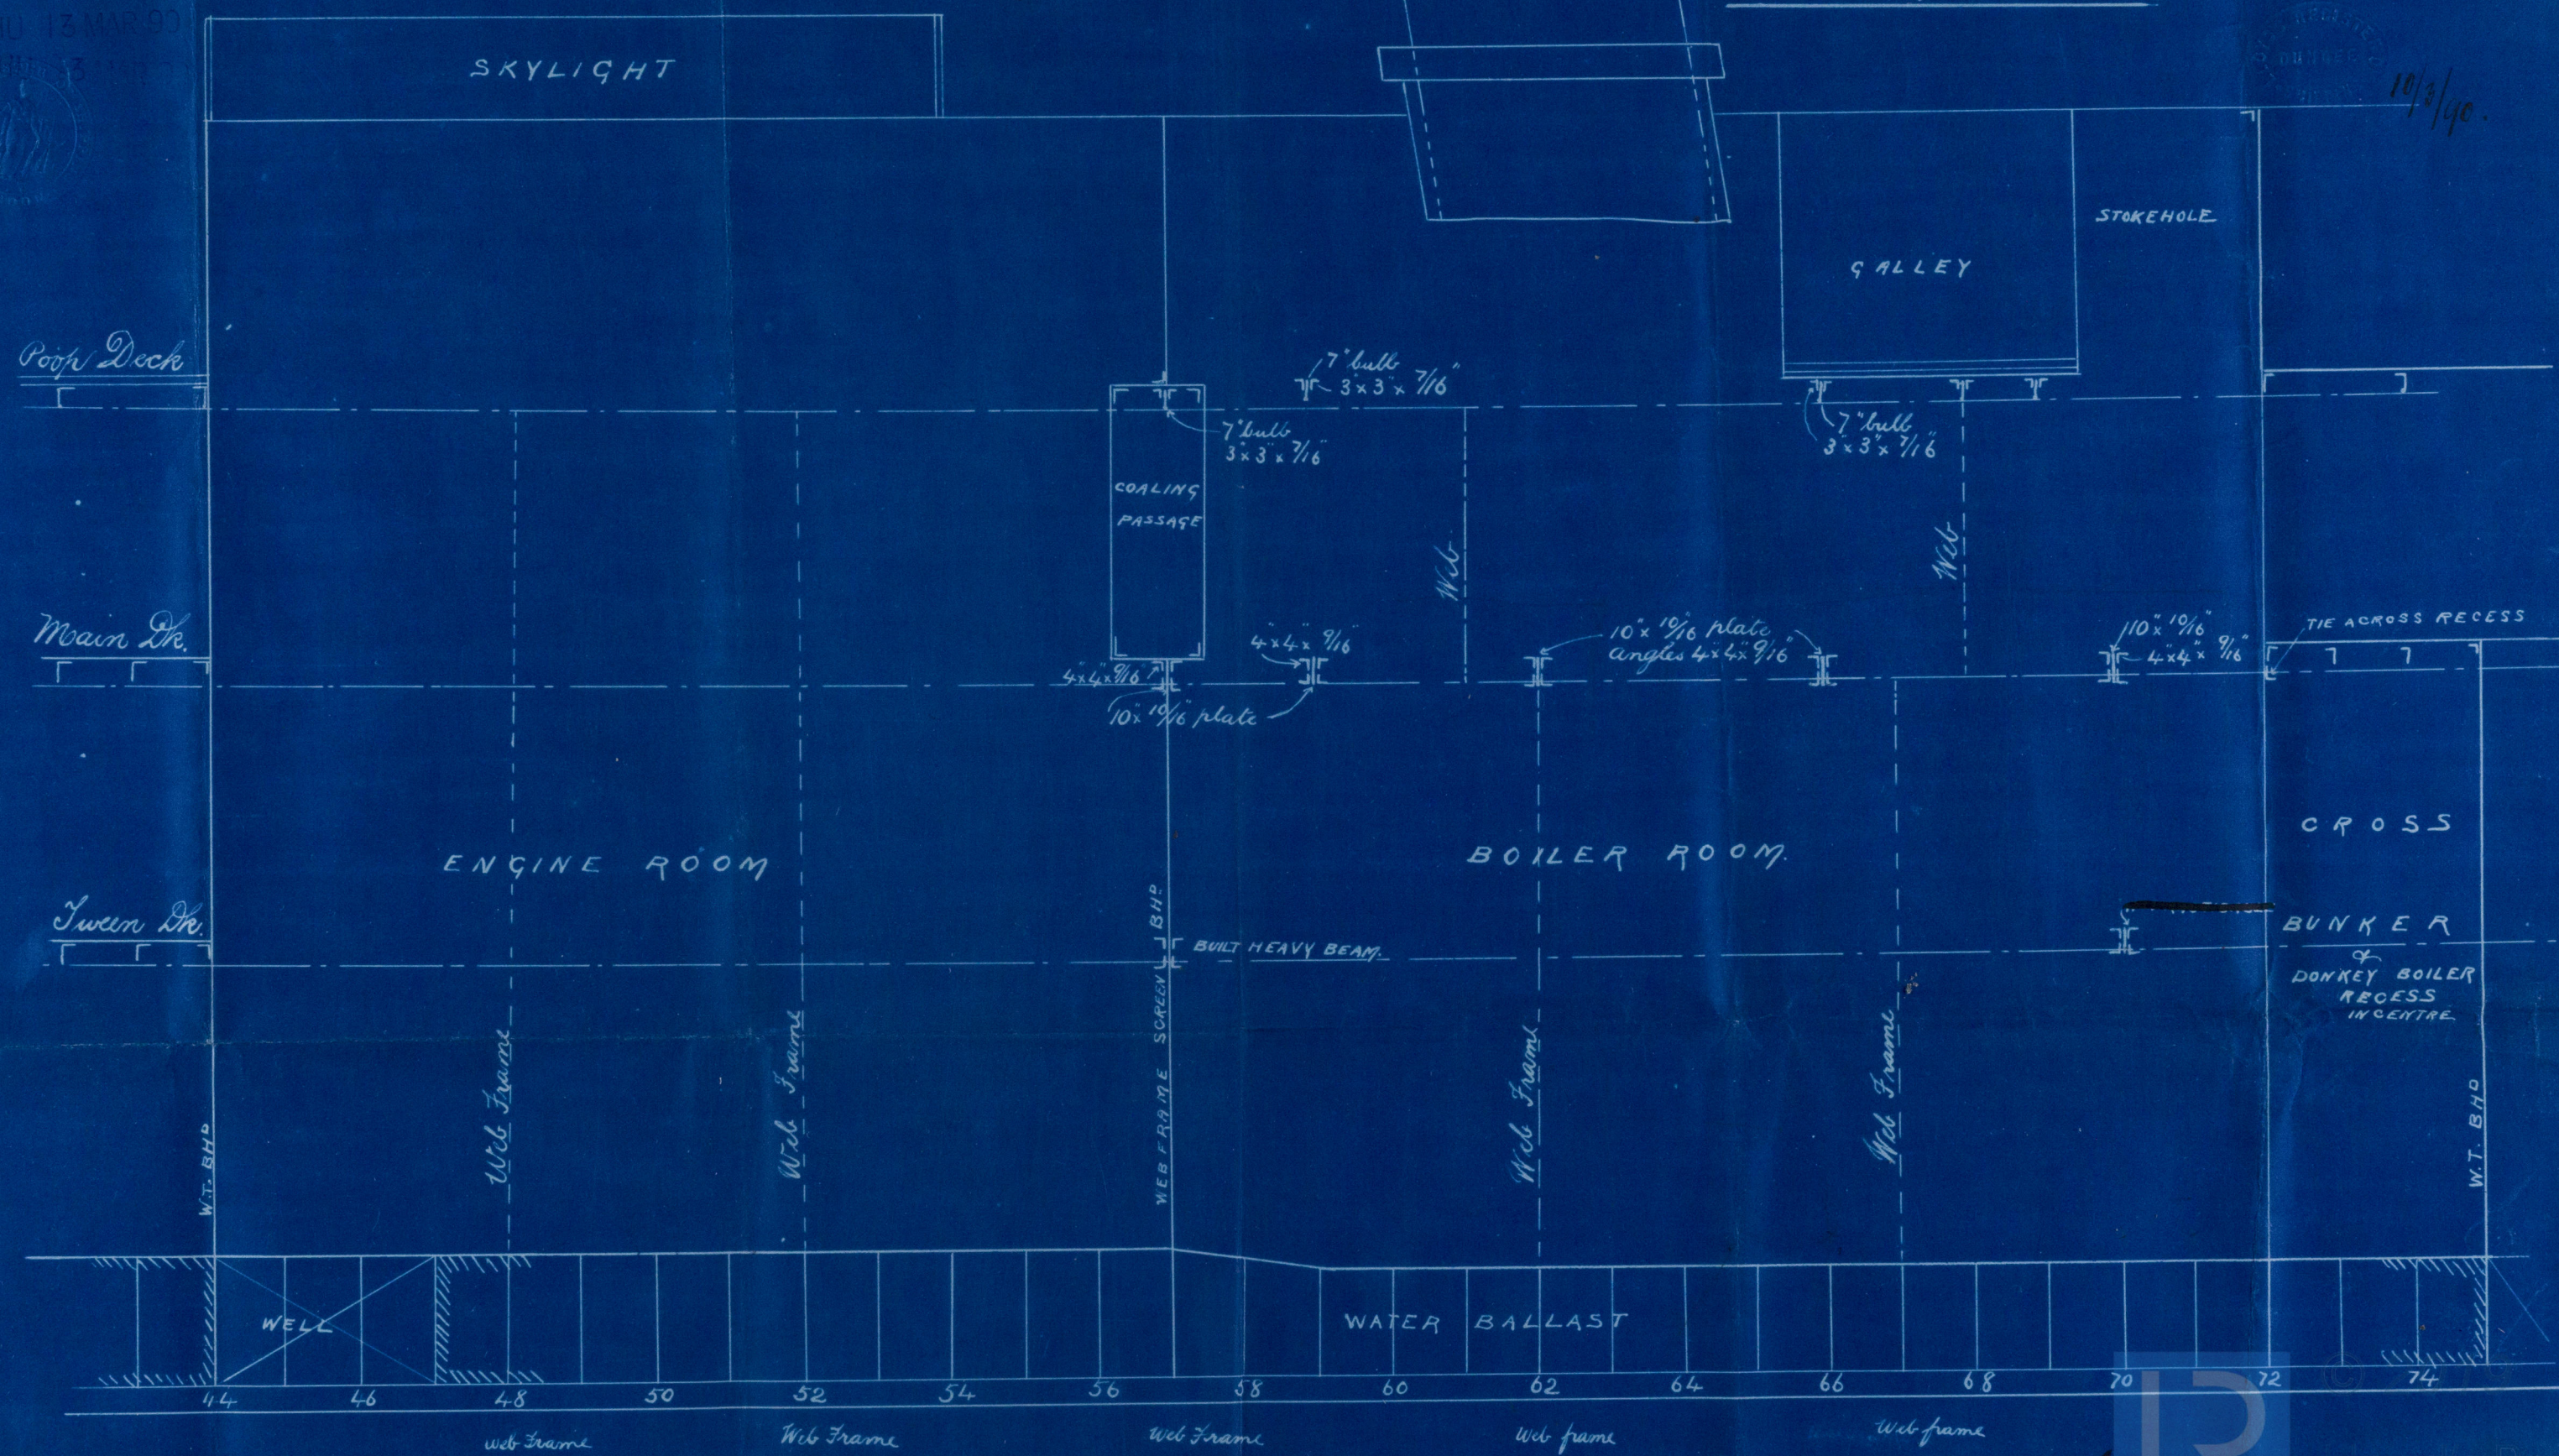

13/3/90



Lloyd's Register Foundation
000000-0276