



S.S. "~~Osphej~~" "*Himnodella*"
Scale 1" = 1 foot

Plates	Boat Rule	7bs	Lloyds Rules	7bs	Unit	Surfaces	Sq. ft.
Shell	$\frac{6470 \times 883}{100} \times 30 \times 3 = 153.5$	160	$\frac{260 \times 1318 \times 83}{100} = 185$	166	1/32	464	2525.6
Ends top	$\frac{113.5 \times (75-12)}{100} = 16.6$	16.6	$\frac{116.0 \times (72-2)}{100} = 178.5$	173	1/32	3	112.0
Ends tube plate	$\frac{100 \times (157-12)}{90} = 225$	225	$\frac{100 \times (12)}{60 \times 5} = 178$	178	1/32	3	112.0
Ends bottom					1/6	6	183.0
Rock tube plates	$\frac{40 \times 3 \times 21 \times 24 \times 2222}{80 \times 32 \times 3 \times 5} = 100.5$	100	$\frac{100 \times 116 \times 5}{90} = 127.8$	128	1/32	1	29.7
Base		5'3"	Long				
Total area two tubes		39.5	1/32				
Area base plates		1.00					

Shell $\frac{3}{32}$ " thick (steel) River holes $1\frac{1}{2}$ " dia $8\frac{3}{4}$ " pitch
Outer butt straps $1\frac{1}{8}$ " thick Inner butt straps $\frac{1}{8}$ " thick
Cover plates $\frac{1}{2}$ " thick

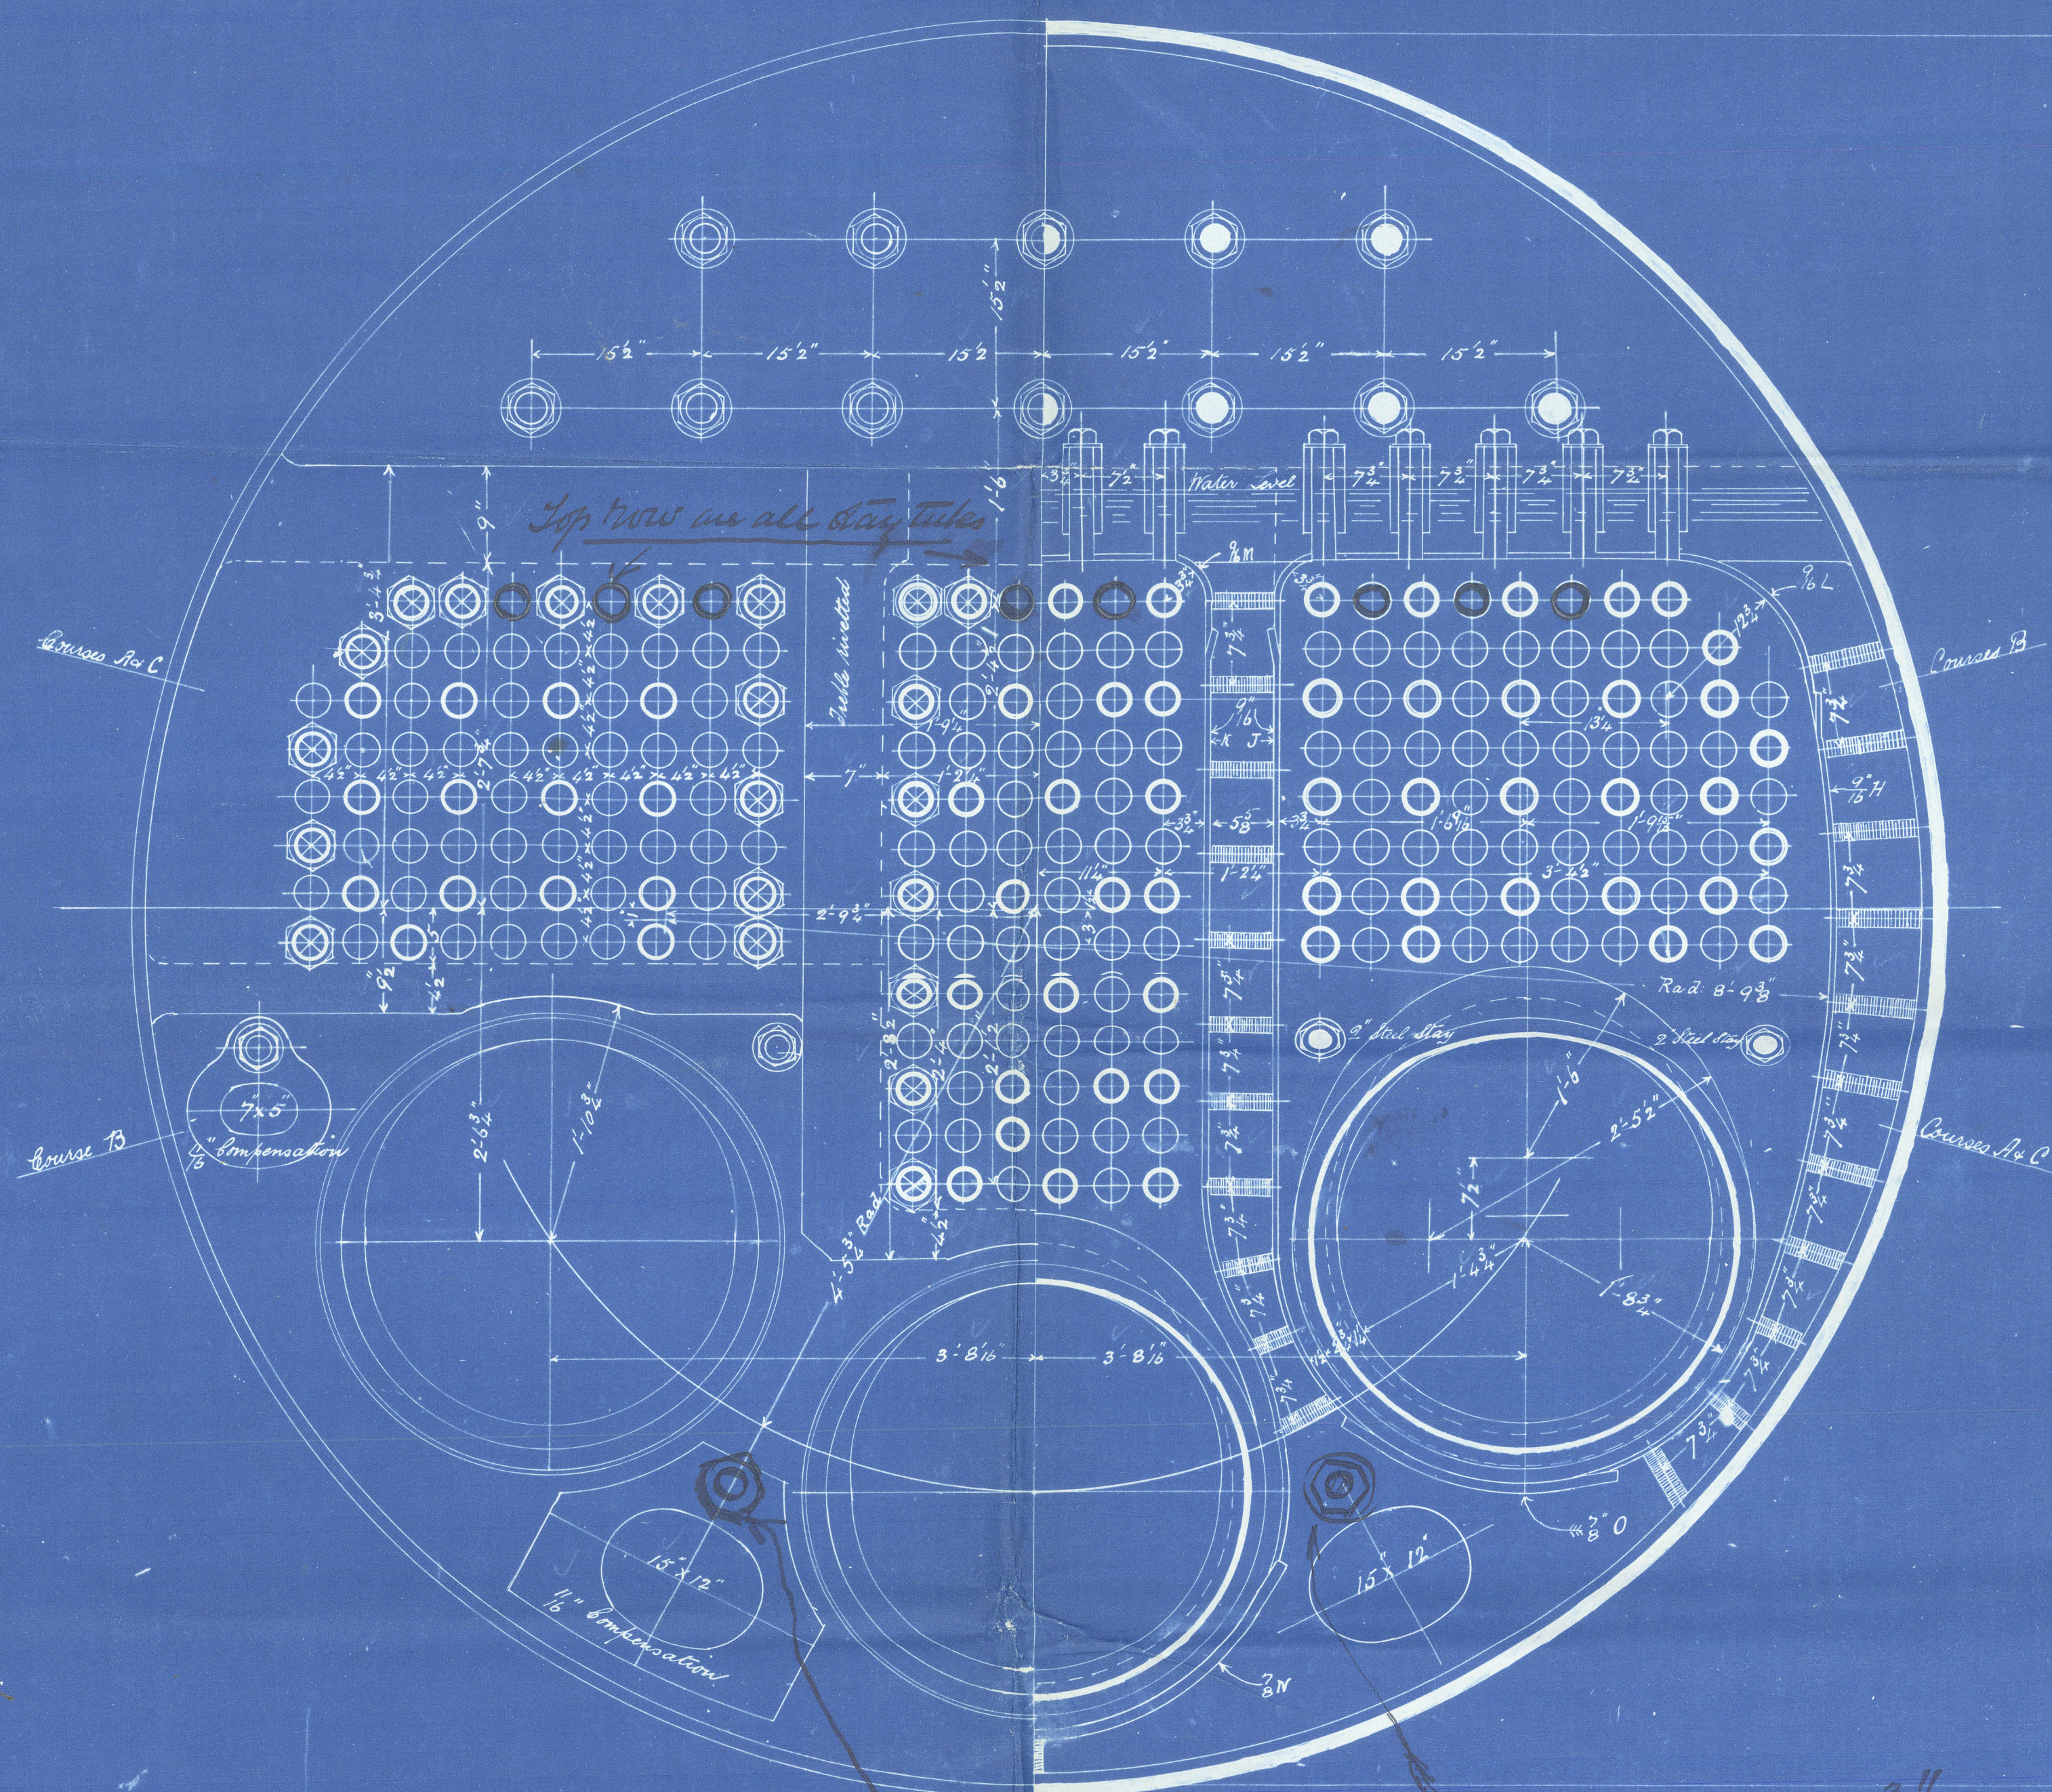

Two days through water from mid to mid 2^d division over threshold

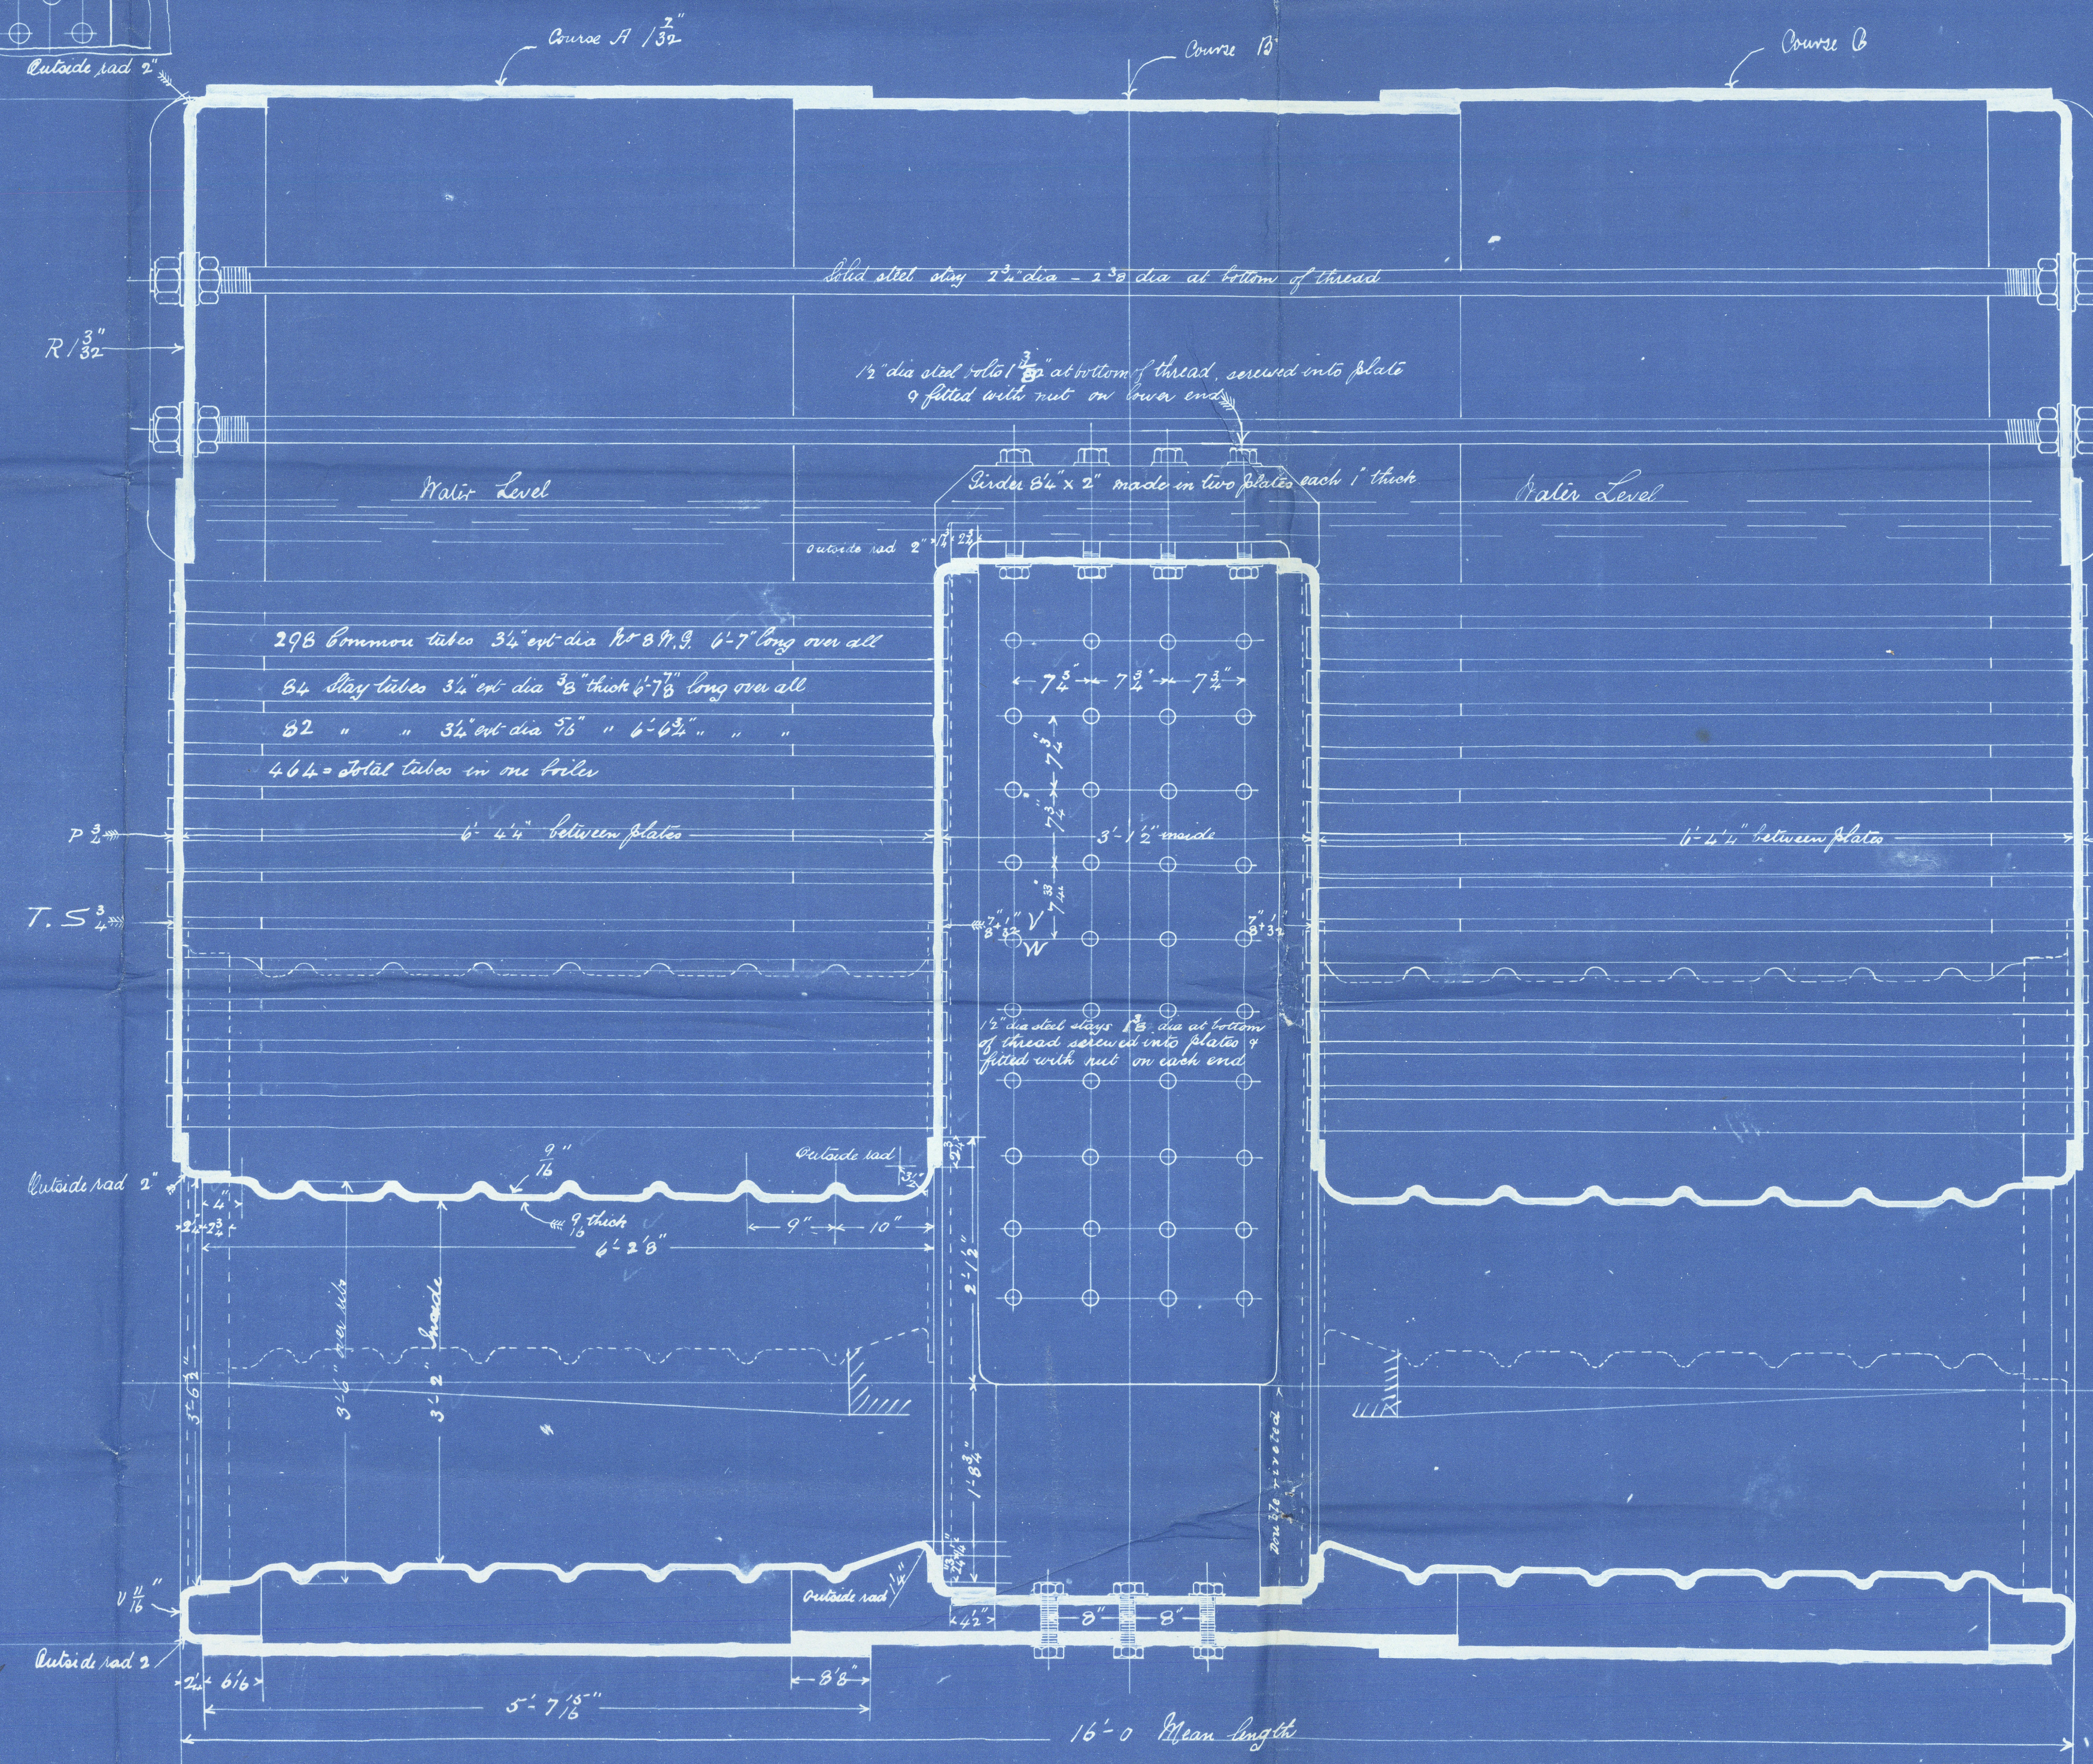

Steel Boilers.

N^o. 295

S. S. ~~Captain~~ "Hirondelle"
Gourlay Bros & Co.
S.S. No. 143.

No. 562

Lloyd's Test


320 lbs.

A.E.K. 12.4.90.

Dundee.

Report. No. 5381.

S. S. "Hirondelle"

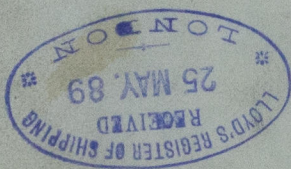

DUN114-0277

© 2020

Lloyd's Register
Foundation