



ENGINEERS  
 & SHIPBUILDERS  
 DUNDEE

# S.S. "HIRONDELLE"

## Report No. 5381.


= Longitudinal Section =  
 S.S. No 143  
 Scale 1/8" Inch = 1 Foot  
 11th July 1889.

REGISTERED  
 DUNDEE  
 SHIPBUILDING  
 20th July 1889

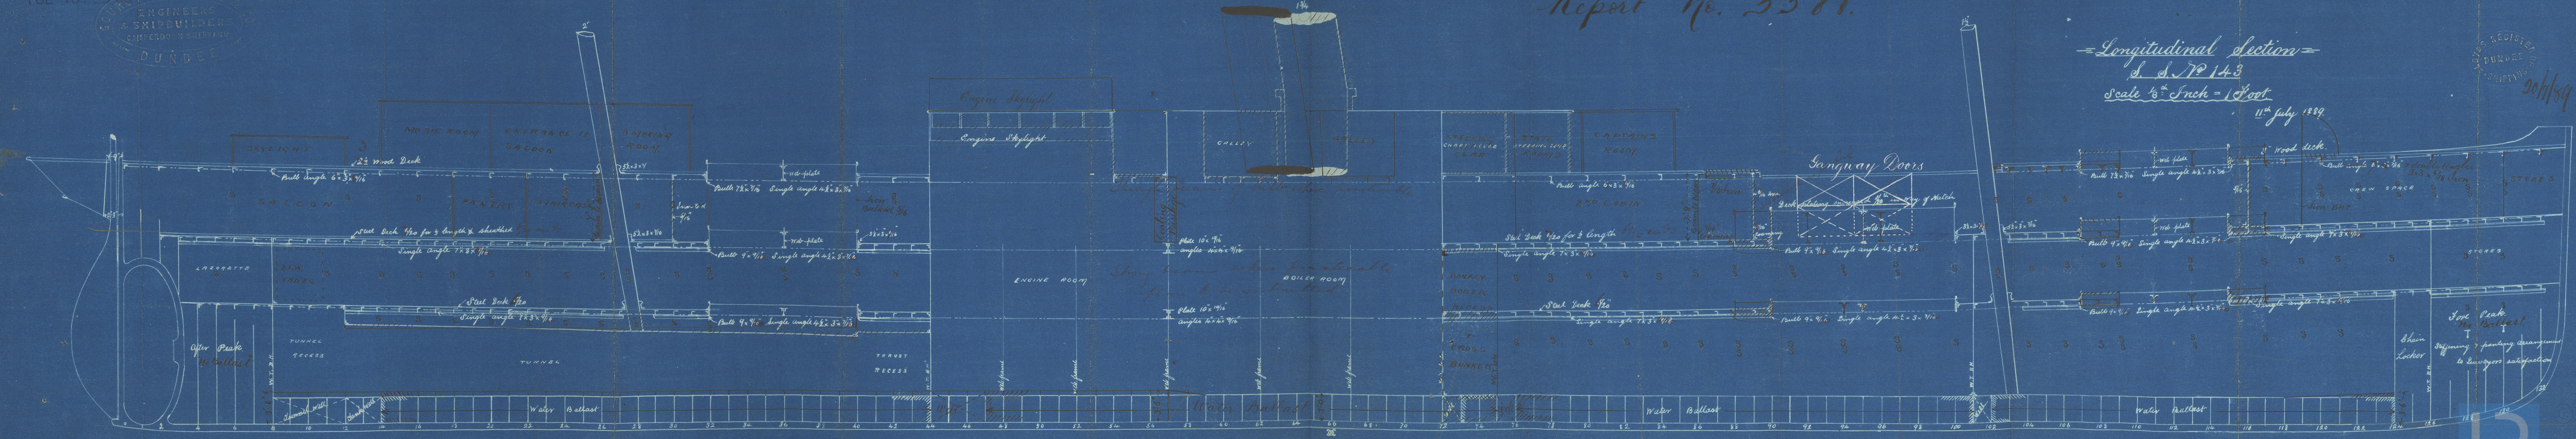

31/7/89



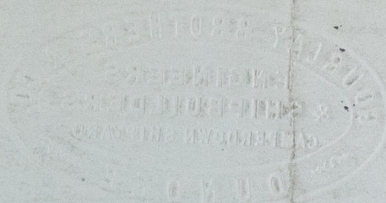

*Donor, Webster*

*4/1/10*







© 2020

Lloyd's Register  
Foundation



Longitudinal Section  
of  
Iron & Steel  
Sew. Stm. No. 143.  
Gowlay Bros. & Co.

Dundee  
Report No. 5381  
S.S. "Hirondelle".

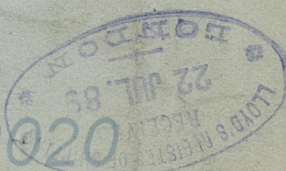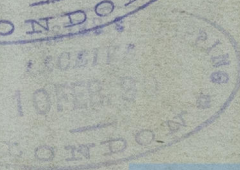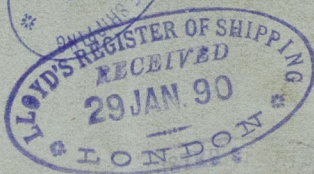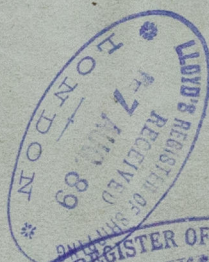

© 2020  
Lloyd's Register  
Foundation

DUN114-0344