

AMENDED ARRANGEMENT
IN WAY OF MAIN HATCH


S S 146

SCALE 1/4 INCH = 1 FOOT

S. S. 'Tharmigan'
Report No 5467



130000 90
1/16

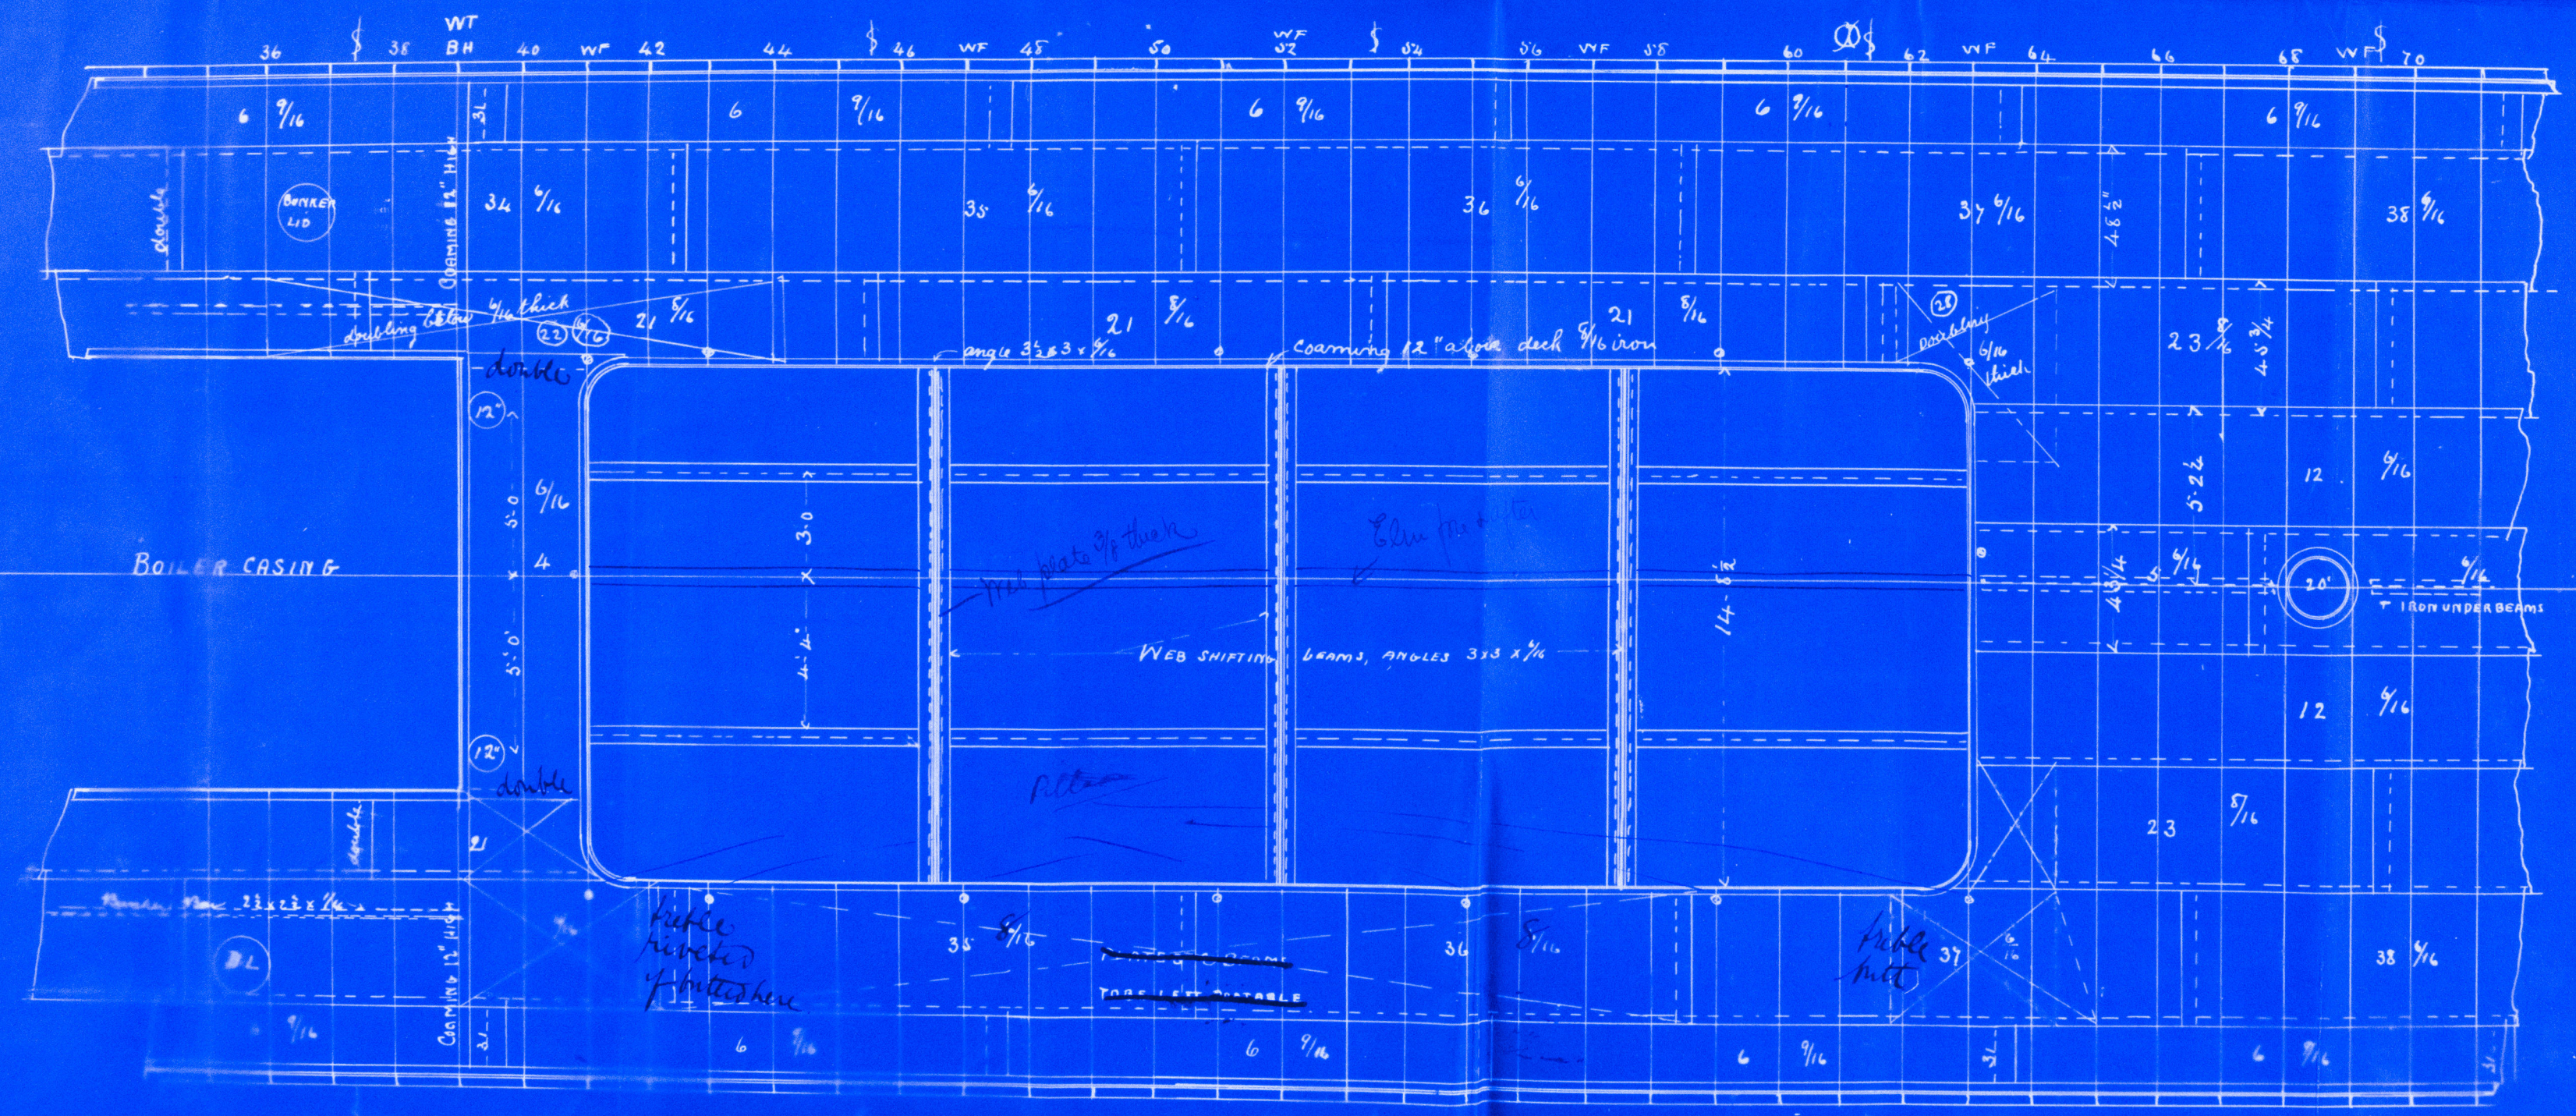

Amended.
Arrangement
in way of
Main Hatch.

S. S. No. 146

Gourlay Bros
& Co.

S. S. "Parramatta".

Dundee.

Report No. 5467.

DUN116-0266



© 2019

Lloyd's Register
Foundation