




SAT 5 JUL 1901

S. S. "Osprey".  
Report no 5509

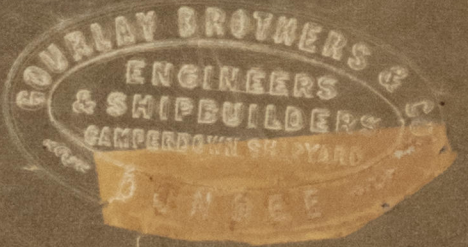

July 1/90  
HJ

Plan of Screwframe

S. S. Osprey.

Scale 1" = 1 foot.

No rivet holes to be bored in Sternpost.  
Holes 17/8" diam. 5/8" apart centres.



2/7/90.

Sketch of Gudgeon

Scale 5" = 1 foot.



By Messrs. J. & W. G. & Co. Ltd.  
Rudders  
London  
2/7/90



Holes not to be drilled



© 2021  
Lloyd's Register  
Foundation




Screw frame  
for

S.S. "Osprey"

Gourlay Bros & Co

Dundee

Report No 5509

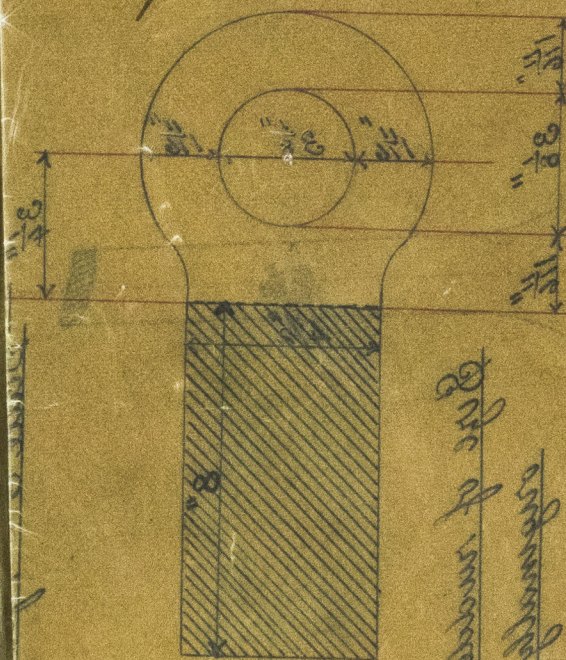

One of squares marked  
as shown by lines & better than

LR

© 2021

Lloyd's Register  
Foundation