
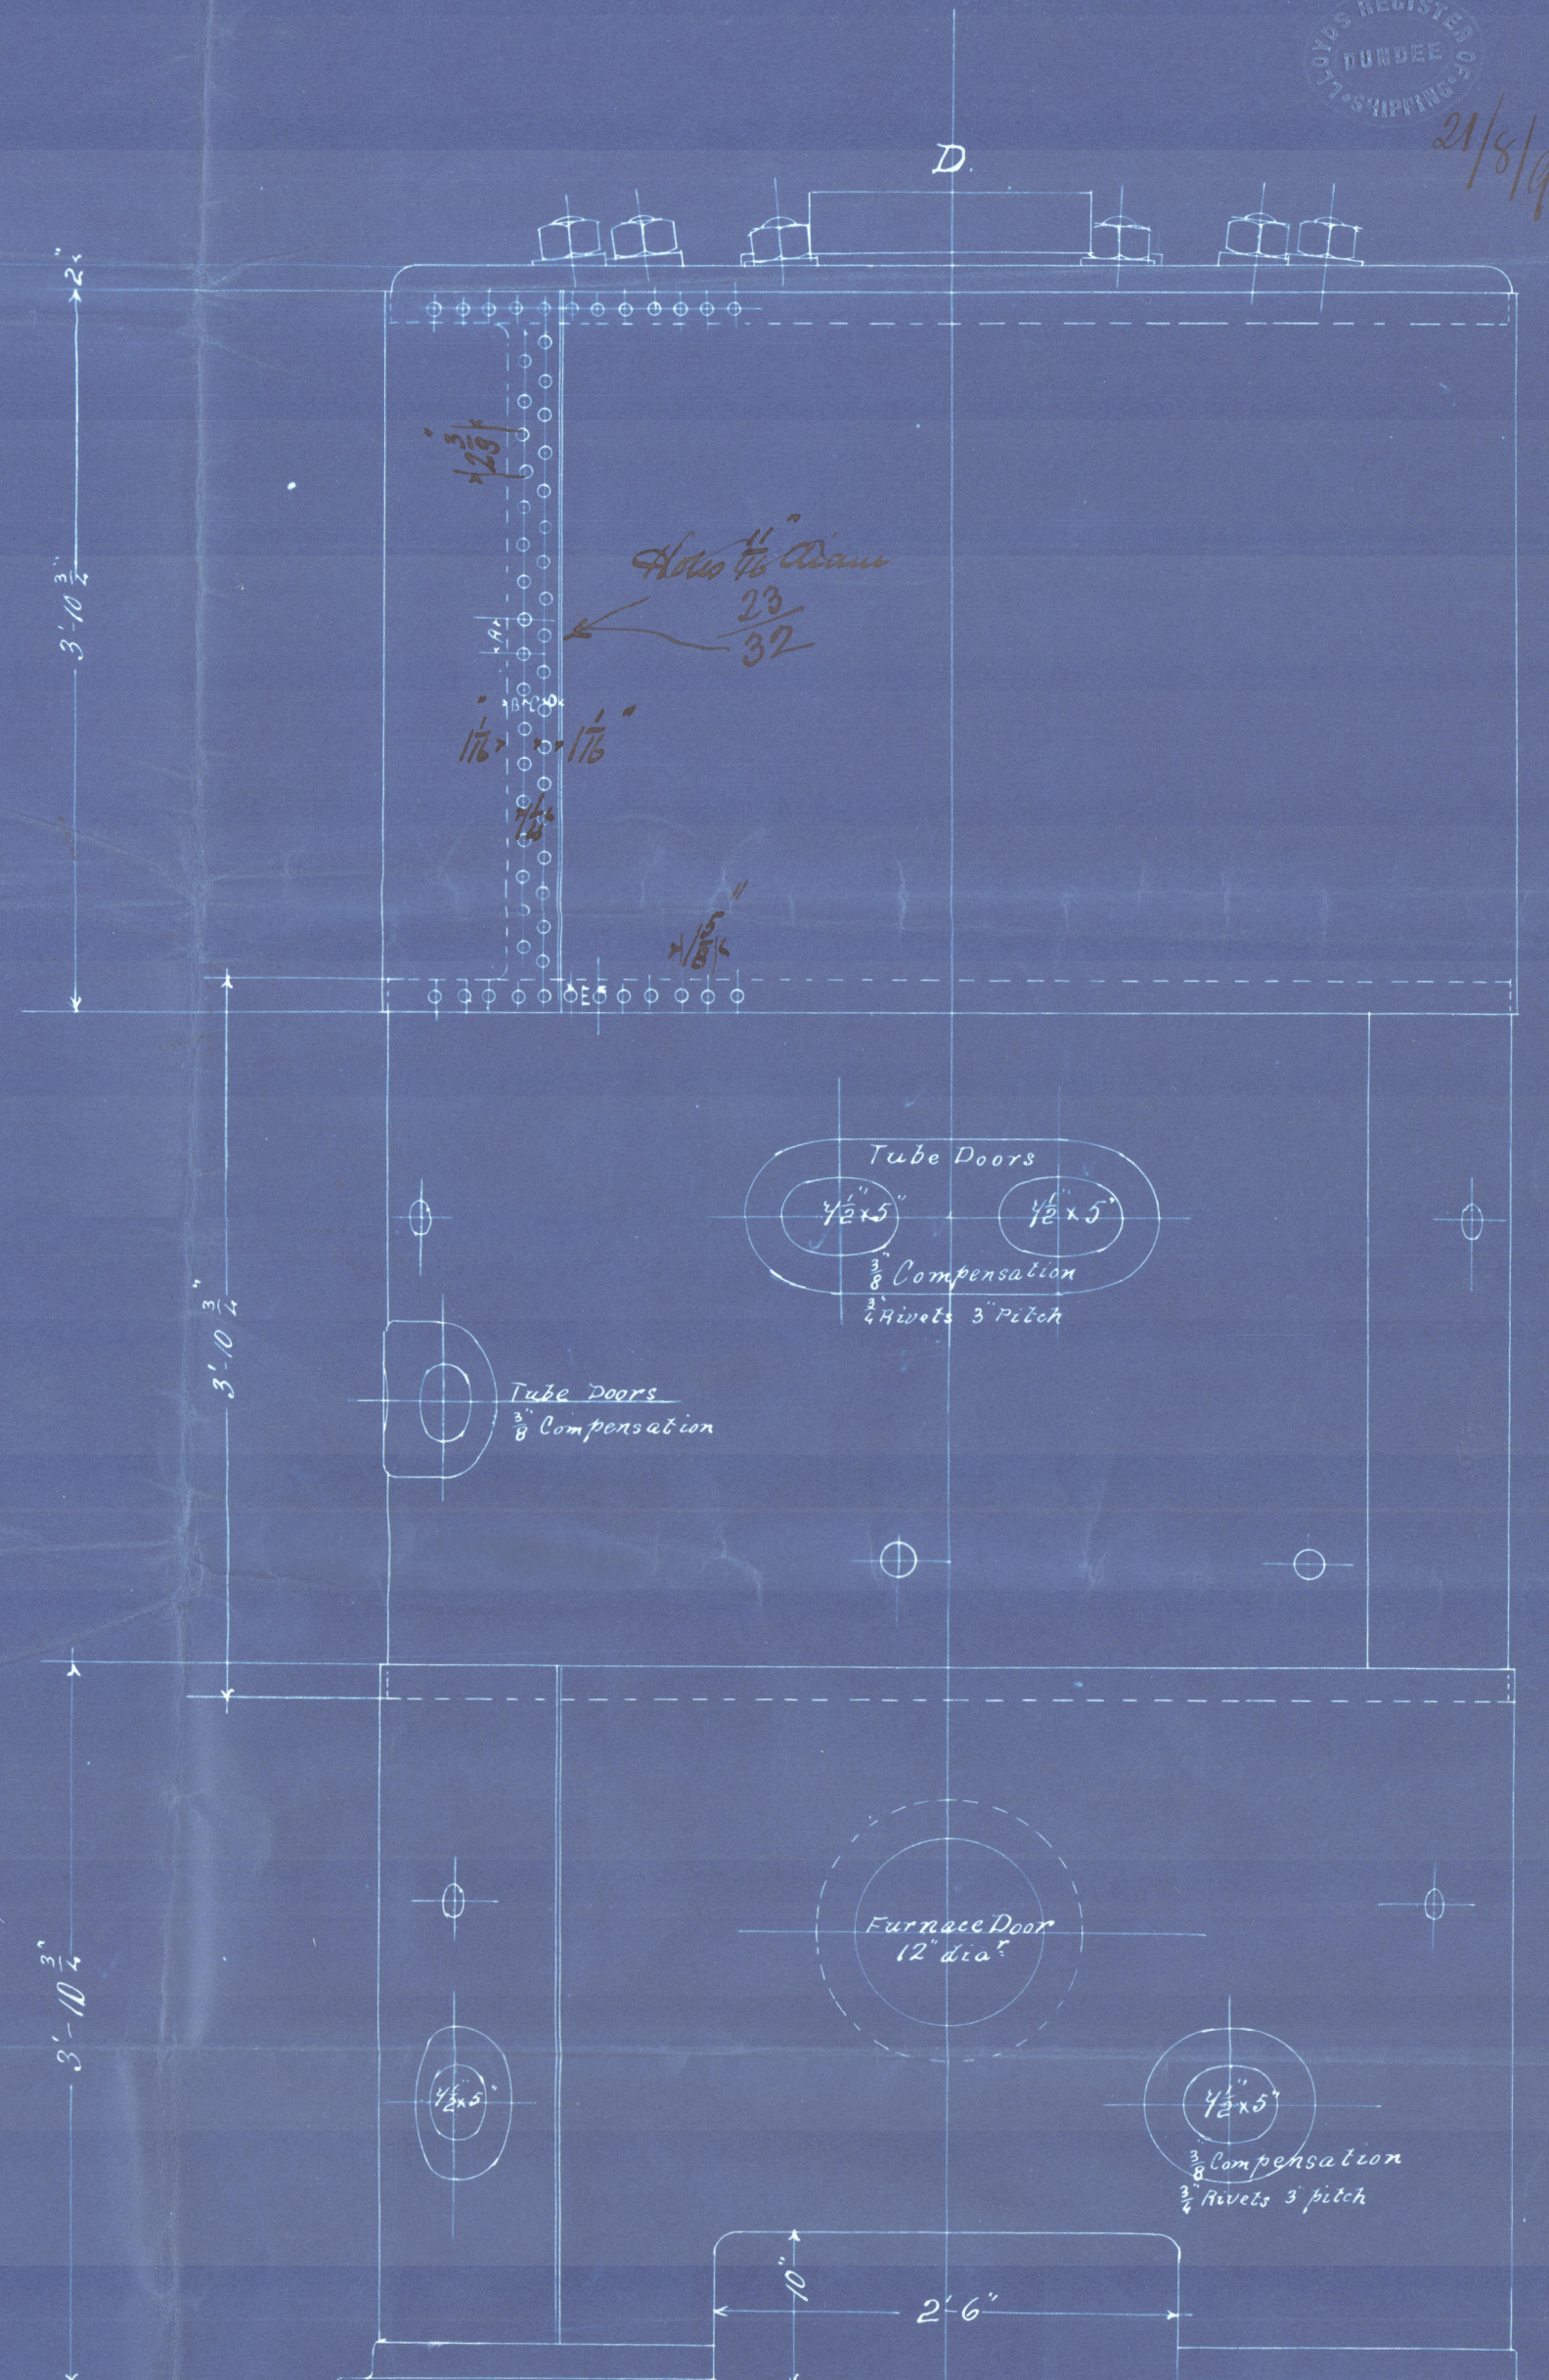


Ln. 23. 8. 90


21/8/90.

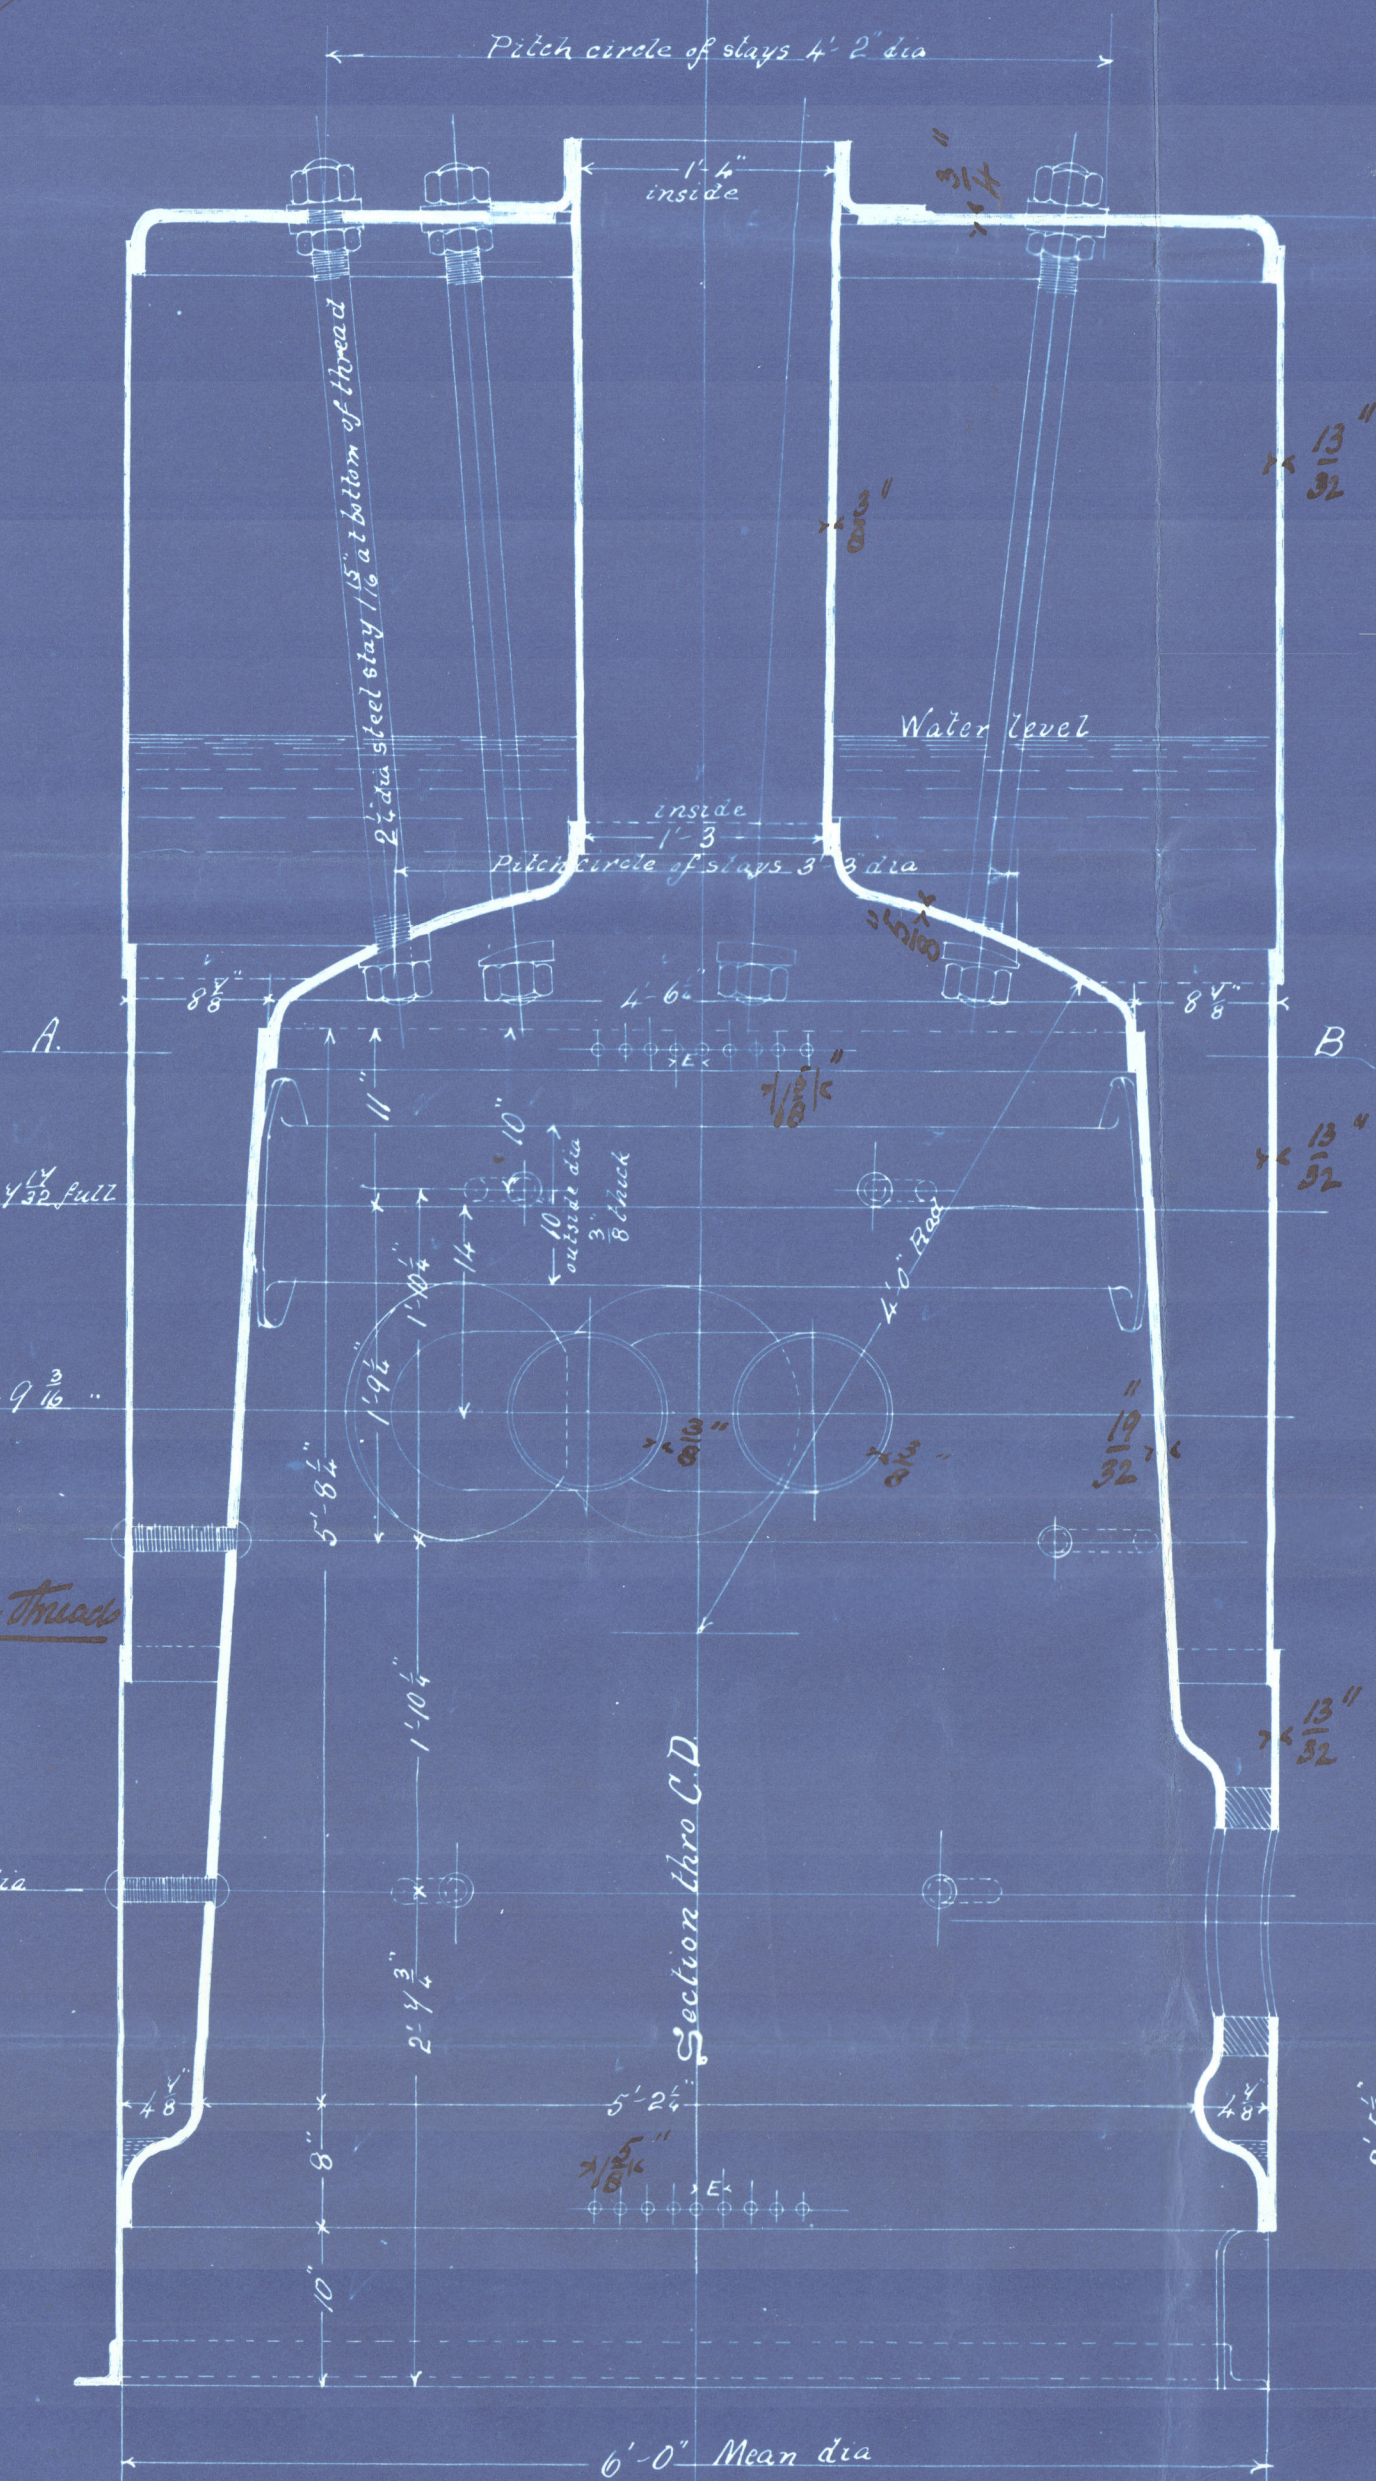

Water Surface	26.8 Sq ft
Heating	136.0
Grate	19.6

Donkey Boiler S.S. "Caspary" Eng. No. 303
 Working Press 80 lbs per square inch
 All material steel except uptakes & cross
 tubes which are of lowmott iron

Scale 1" = 1 ft.

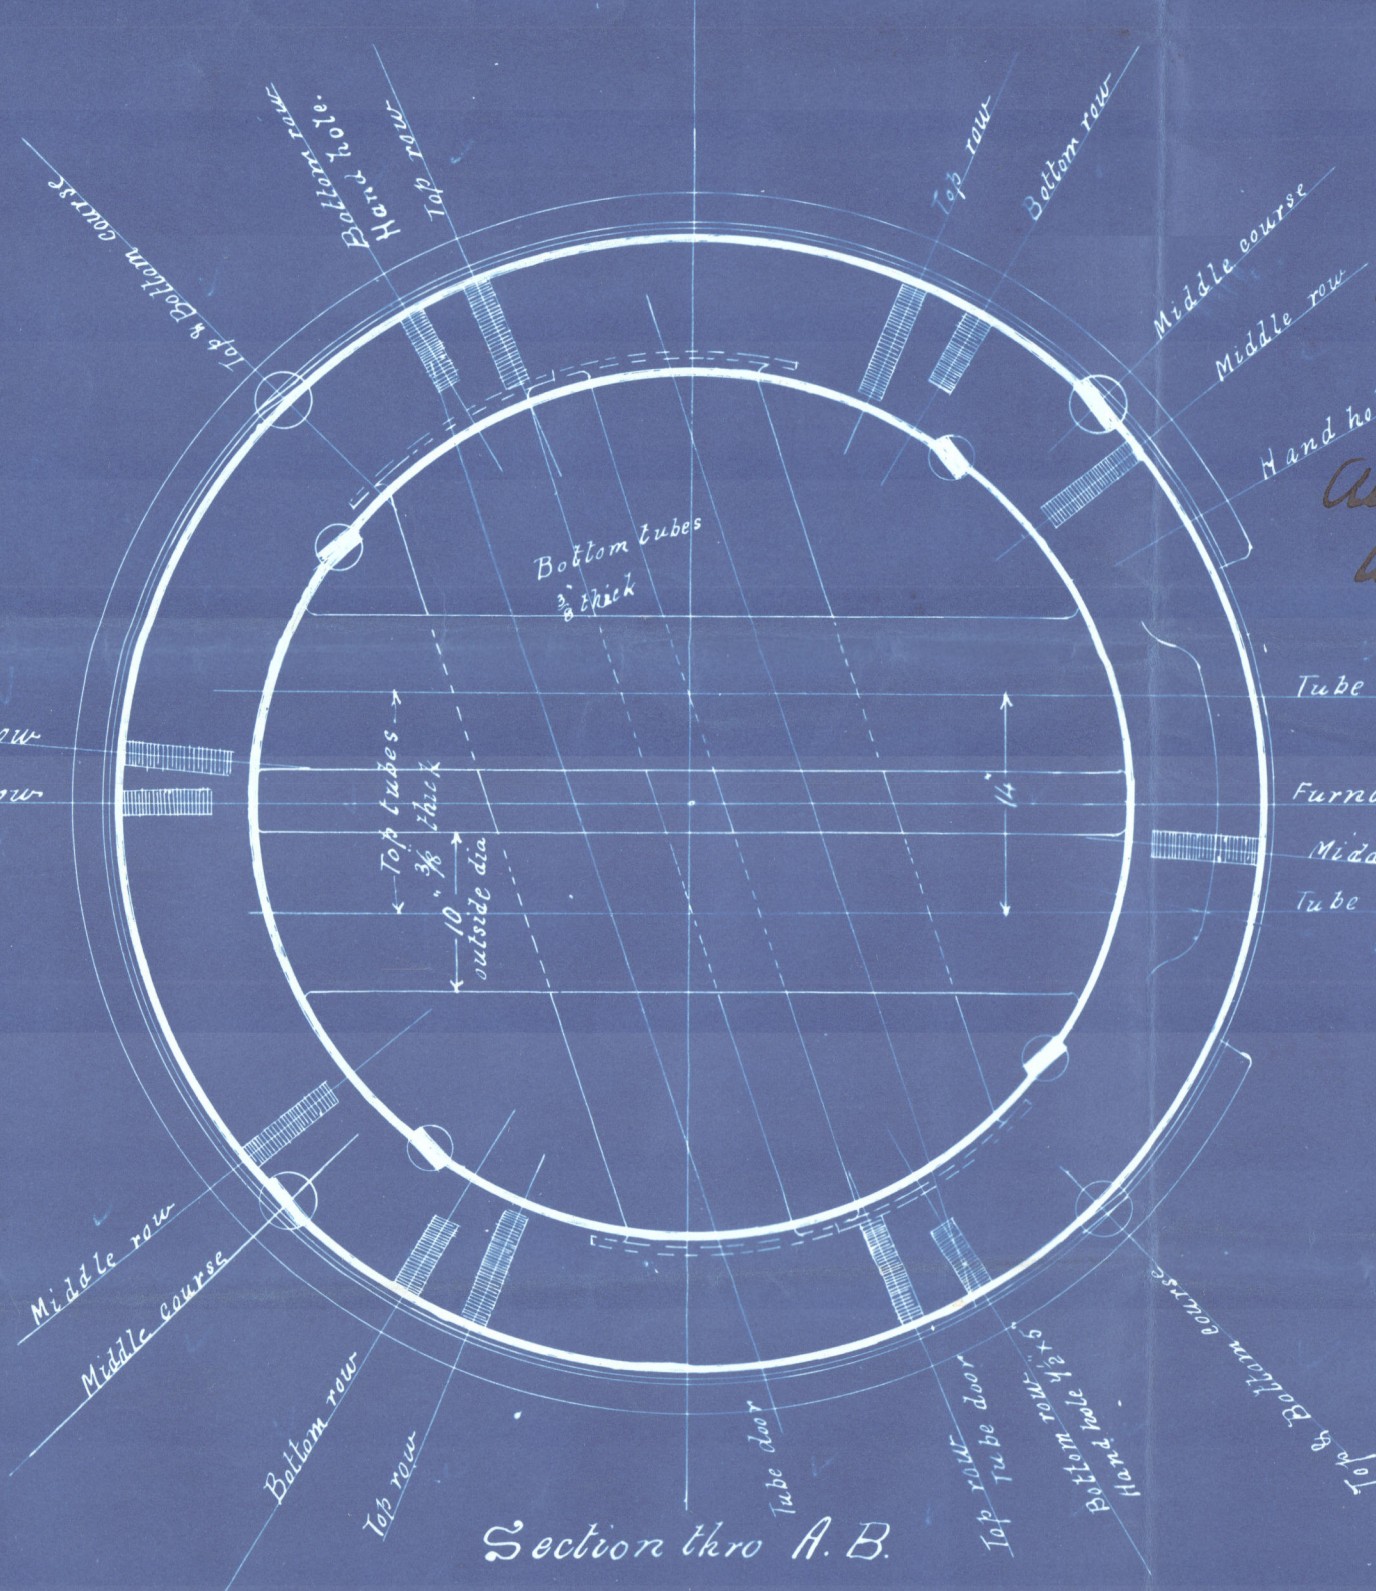

Donkey Boiler
for

S.S. "Osprey"

Gourlay Bros & Co

No. 584

Lloyds Test

160 lbs

Atk. 6.2.91.

Dundee:

Report No 5509



© 2021

Lloyd's Register
Foundation