



WED 3- DEC 91

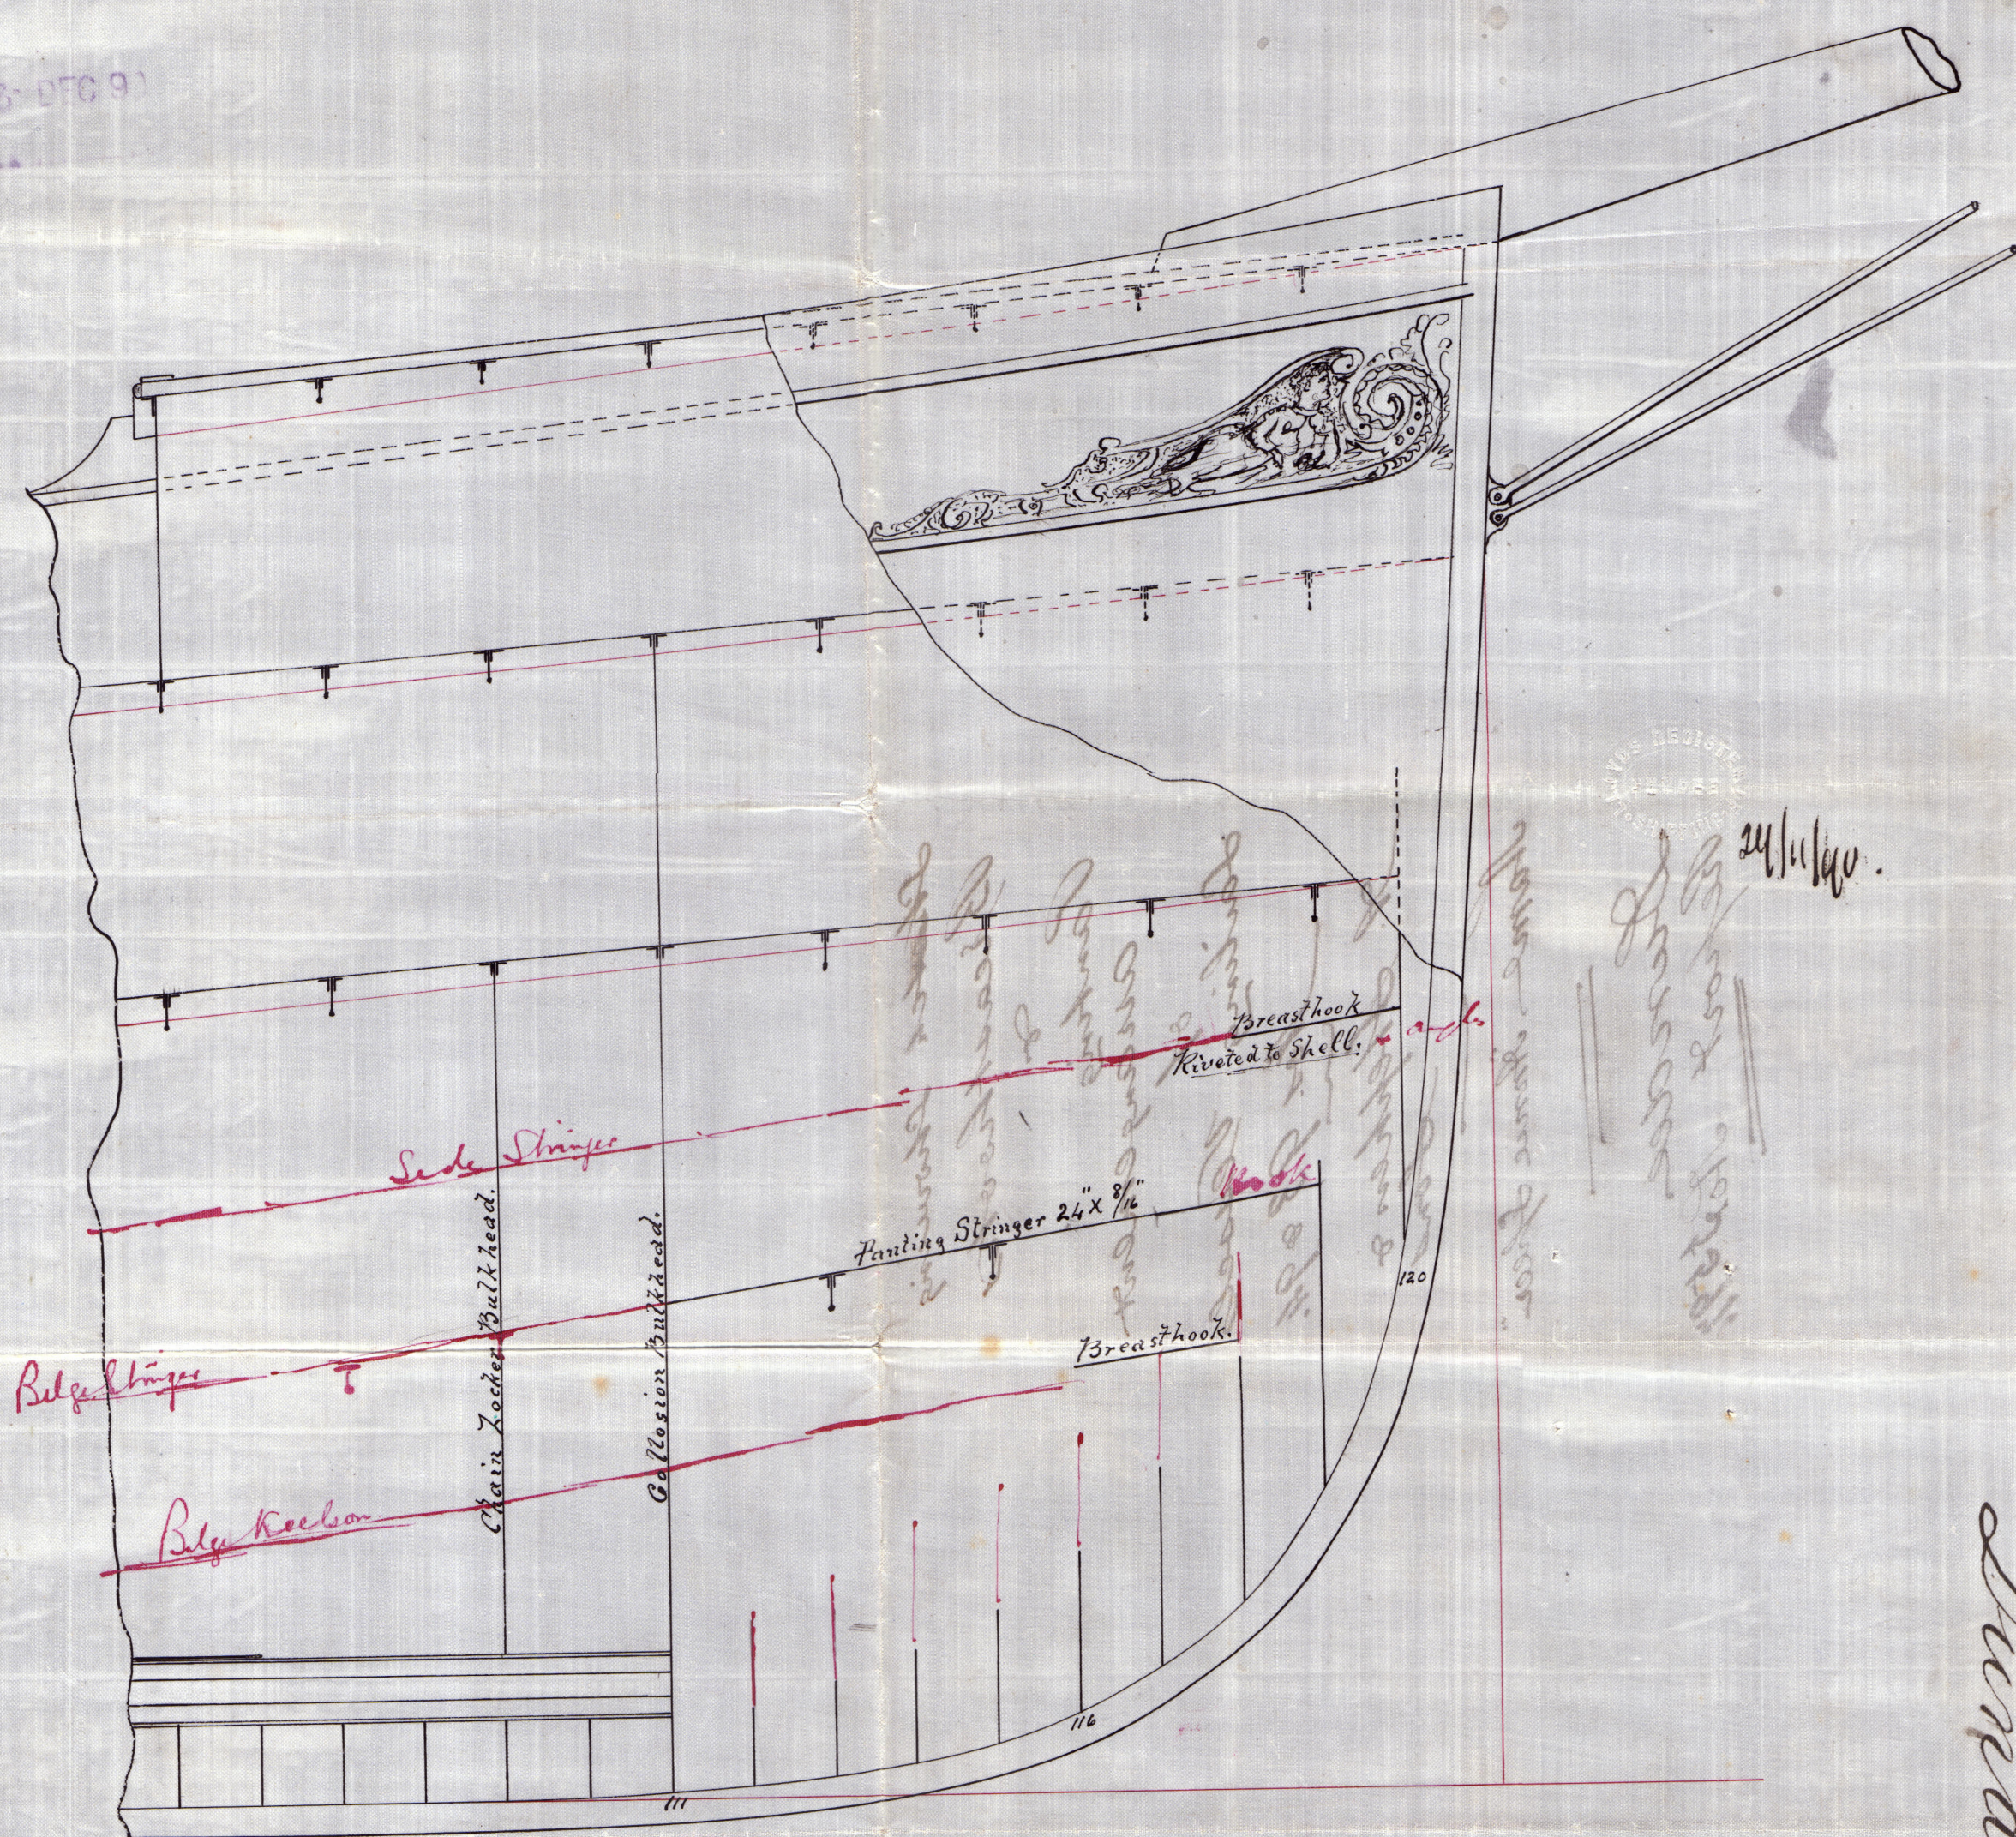

Sketch showing Breasthooks
and Plating Arrangement of
Sailing Vessel

— No 93 & 94. 21/11/90.
Scale 1/4 inch = one foot R.M.

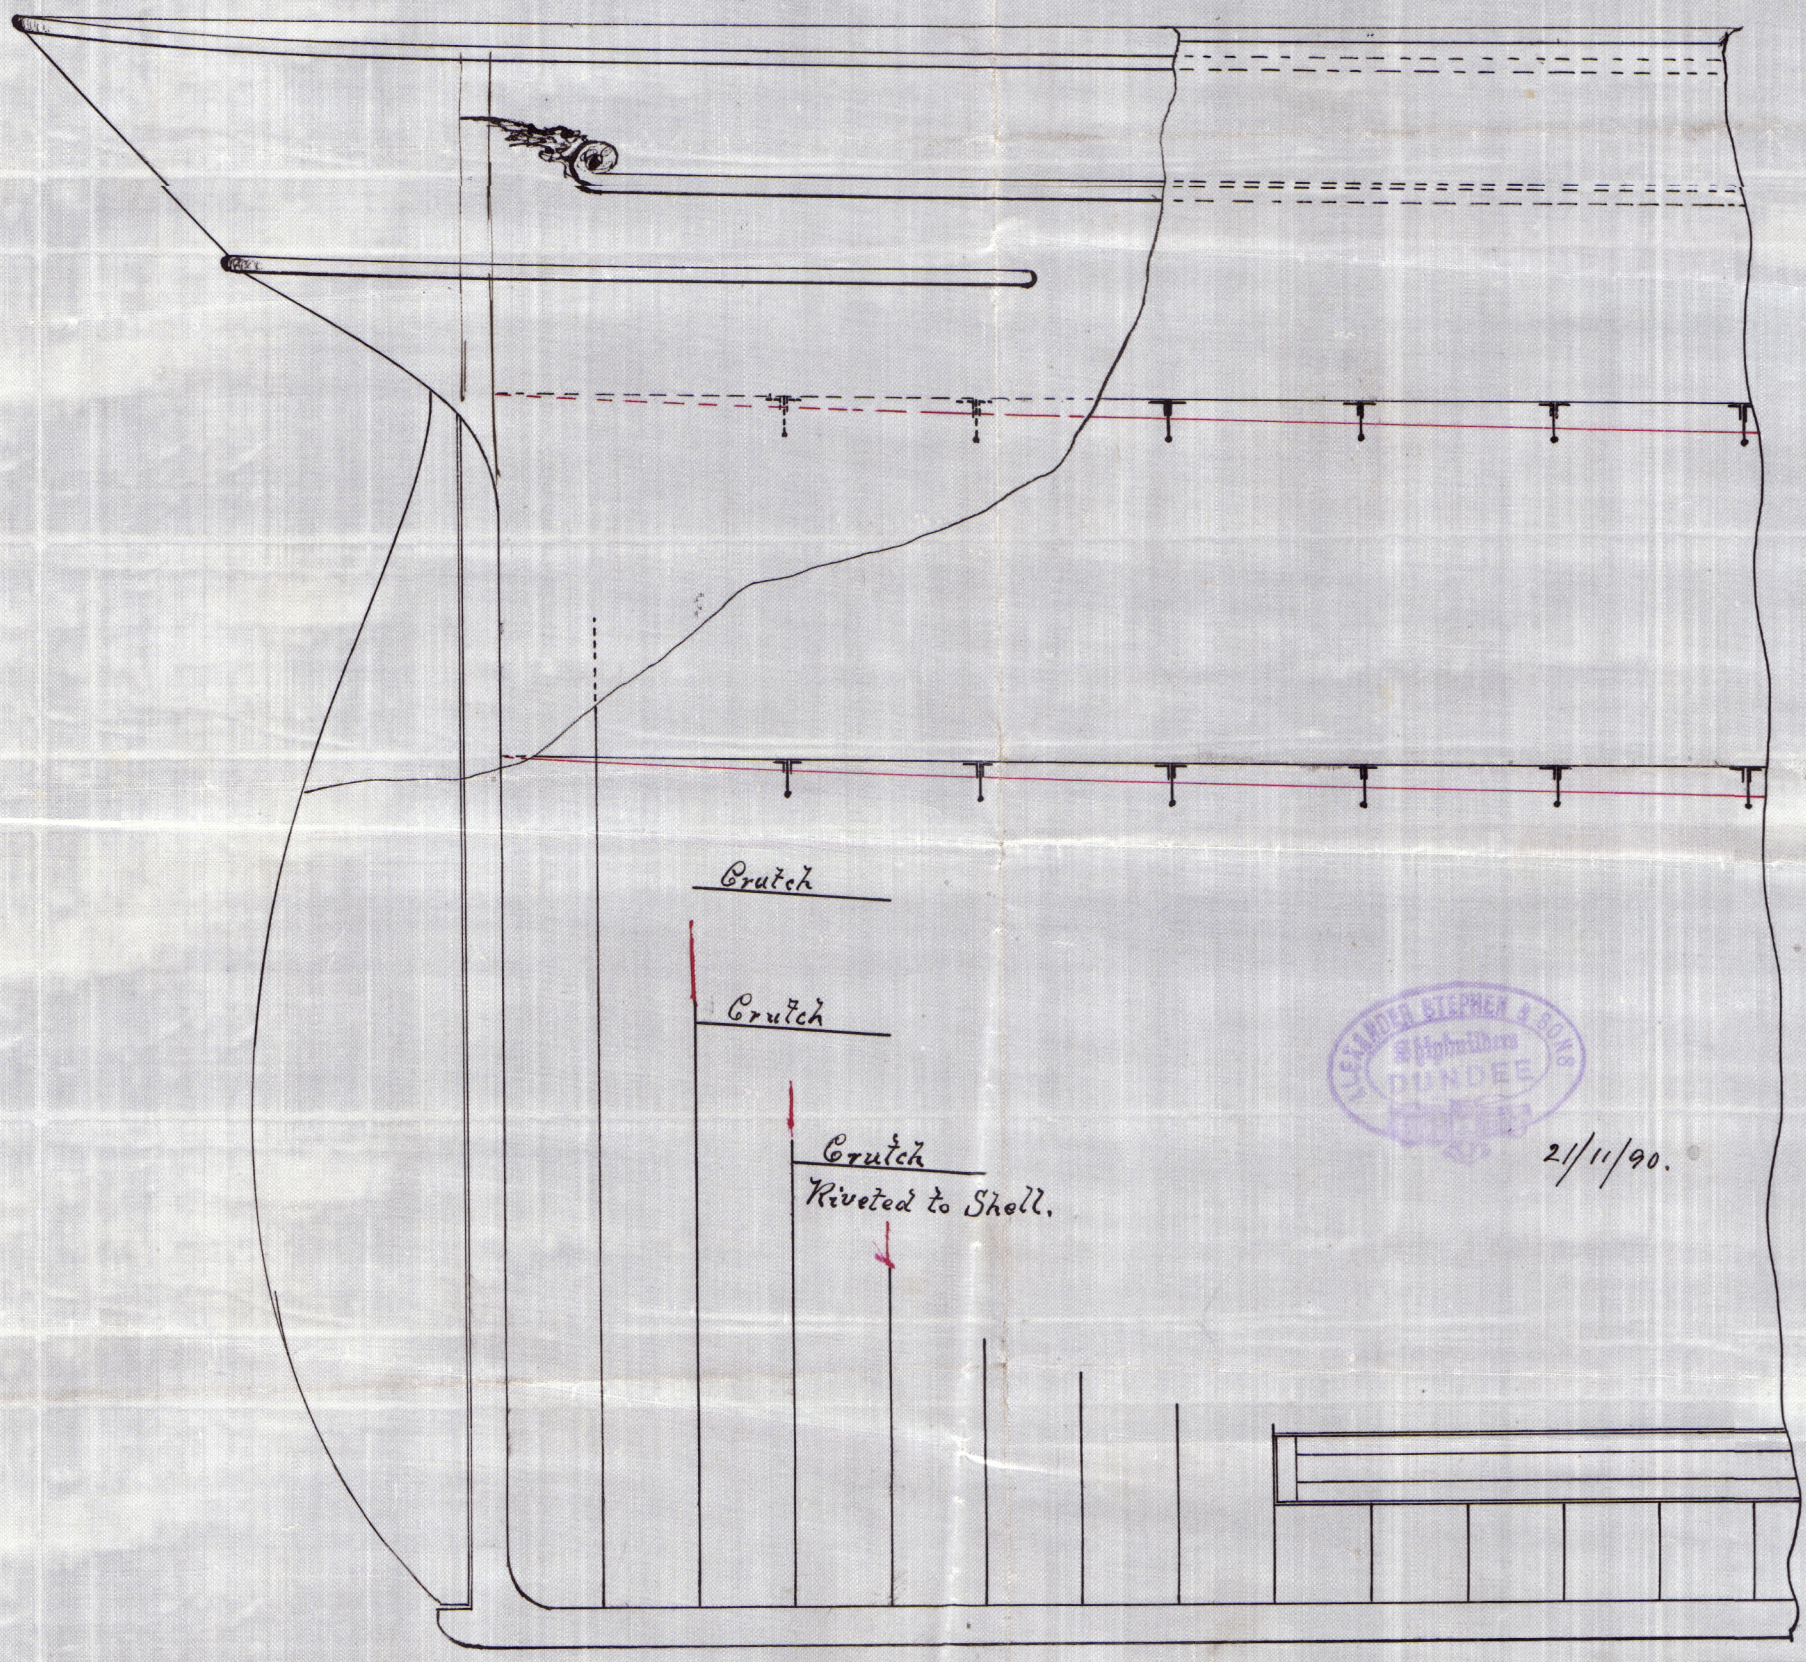

Lundee Report No 55-97

Sketch showing
Breasthooks
&
Panting
arrangement
of
Sailing Vessels
Nos. 93 & 94.

A. Stephen &
Sons

Name "Anne Speer"

Dundee.
Report No. 5597

© 2021

Lloyd's Register
Foundation