


5/3/91



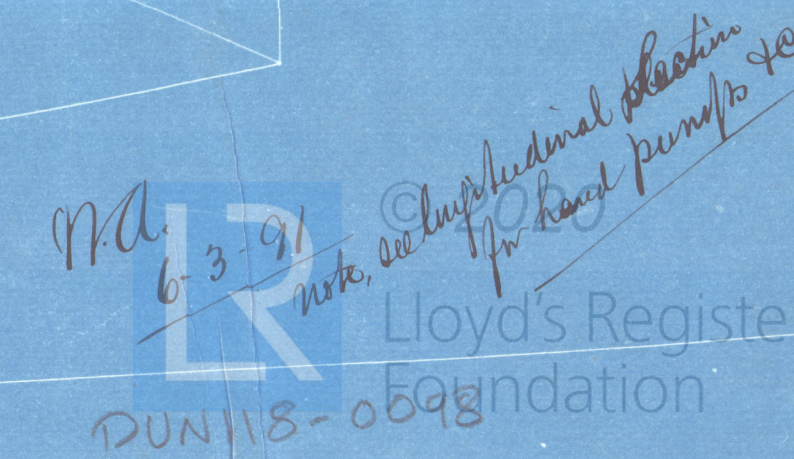

Bulge &  
Tank Arrangements  
S. S. "Berlin."  
(No. 106.)

W. B. Thompson.  
H. L.

Owners.

Yorkshire Coal  
& Steam Ship  
Co. London

Dundee.

Report No 5629.



© 2020

Lloyd's Register  
Foundation  
DUN18-0098