
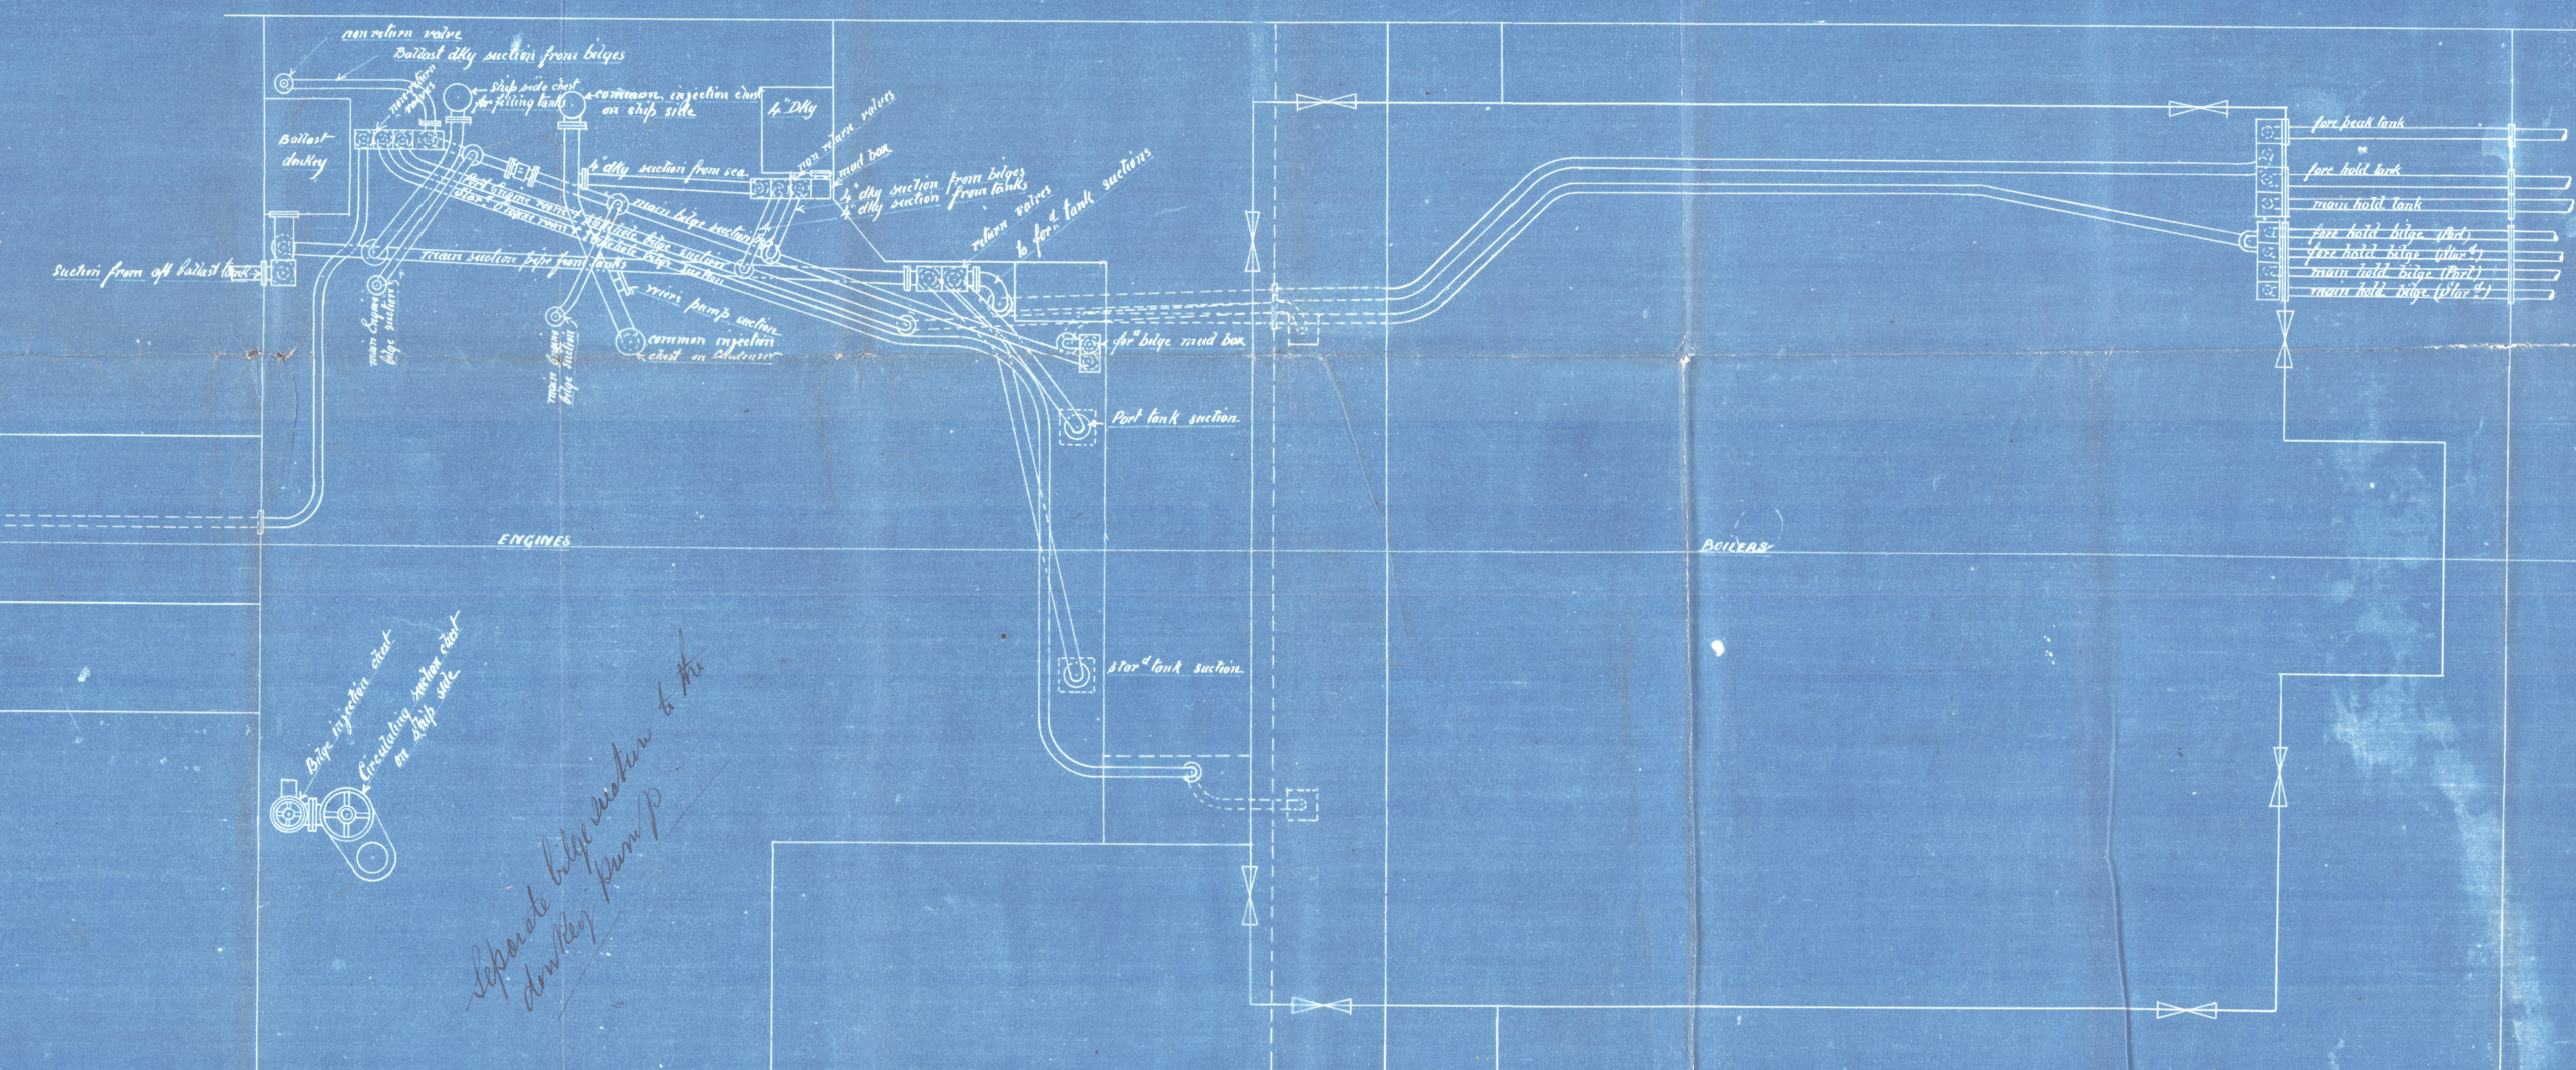


Lt 24.3.91

W. B. THOMPSON & CO. LTD.
14.3.91
DUNDEE
ENGINEERS & SHIPBUILDERS

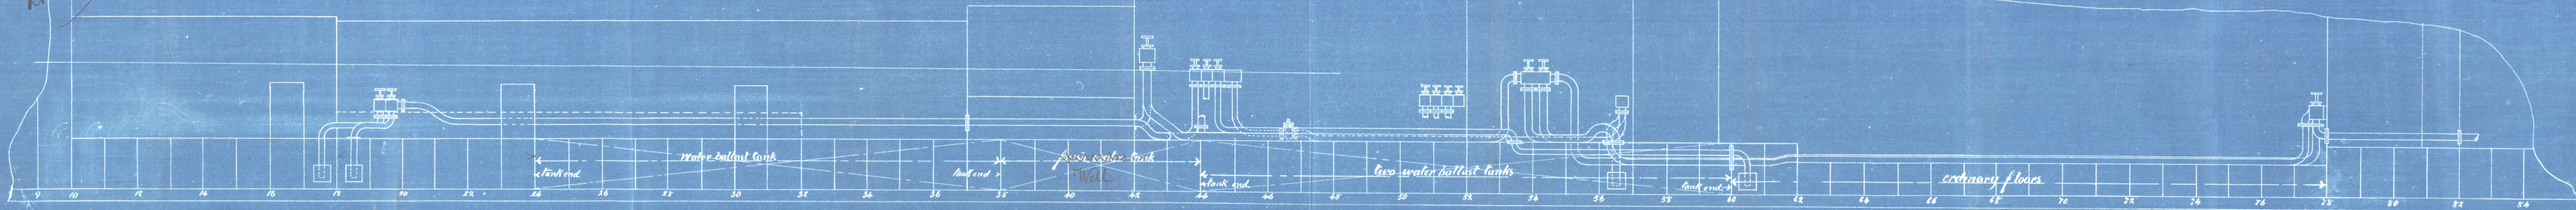

Granger
Report No 5627

— Plan of tank + bilge pipes for S. S. Peregrine —
— Tank pipes 4" dia? Bilge pipes 3" dia? —
— Scale 1/4" = 1 foot —
— 4/3/91 AMB

Separate bilge suction to the
docking pump

Ad.
21.3.91

W. B. THOMPSON & CO. LTD.
ENGINEERS & SHIPBUILDERS
DUNDEE

W. B. THOMPSON & CO. LTD.
LIVERPOOL
ENGINE & BOILER WORKS
DUNDEE

Plan of Tanks
& Bilge Pipes.

S.S. "Peregrine"
(No. 105.)

H. B. Thompson
& Co. Ld.

Dundee
Report No 5637



© 2020

Lloyd's Register

Foundation

DUN148-0162