


TUE 11 NOV 90




*Handwritten notes in cursive script, likely detailing construction specifications or measurements for the ship's hull.*

*Handwritten note: X 1/2*

Cargo Gangway Arrangement  
S.S. No 105 S.S. "Peregrine"  
Scale 1/4 inch to a foot  
Under  
Report No 5637

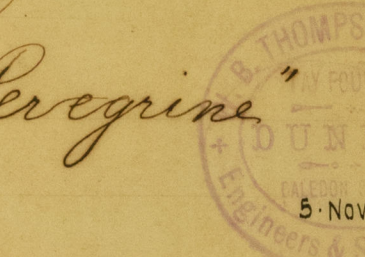

This arrangement at each side of Bulwark Gangway 1/2" SCALE

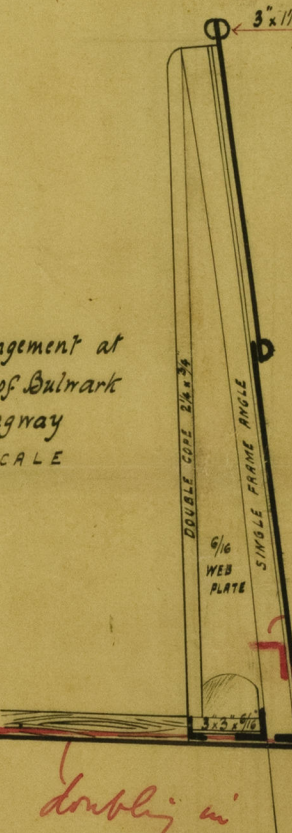

*Handwritten notes in red ink: "Large and scarping ports. Double to upper edge of sheerline in way of port."*

*Handwritten note: J.H. 11/11/90*



Cargo Gangway  
Arrangement


S.S. No. 105.

H. B. Thompson  
& Co. Ltd.

Dunall.

Report No. 5637.

S.S. "Peregrine"

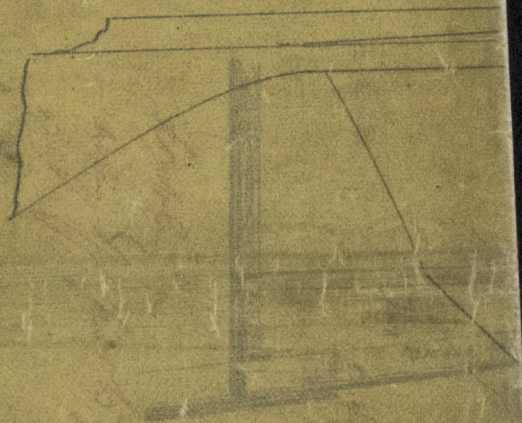

© 2020

Lloyd's Register  
Foundation