

Single Plated
Rudder
for

S. S. Peregrine


H. G. Thompson
& Co. Ltd.

Dundee.

Report. No. 5637.


© 2019

DUN118-0170

Lloyd's Register
Foundation



46/91

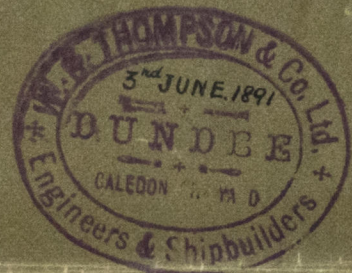


SINGLE PLATE RUDDER.

— S.S. PEREGRINE — *Dundee Report No 5637.*

— No 105 —

SCALE 1" = ONE FOOT

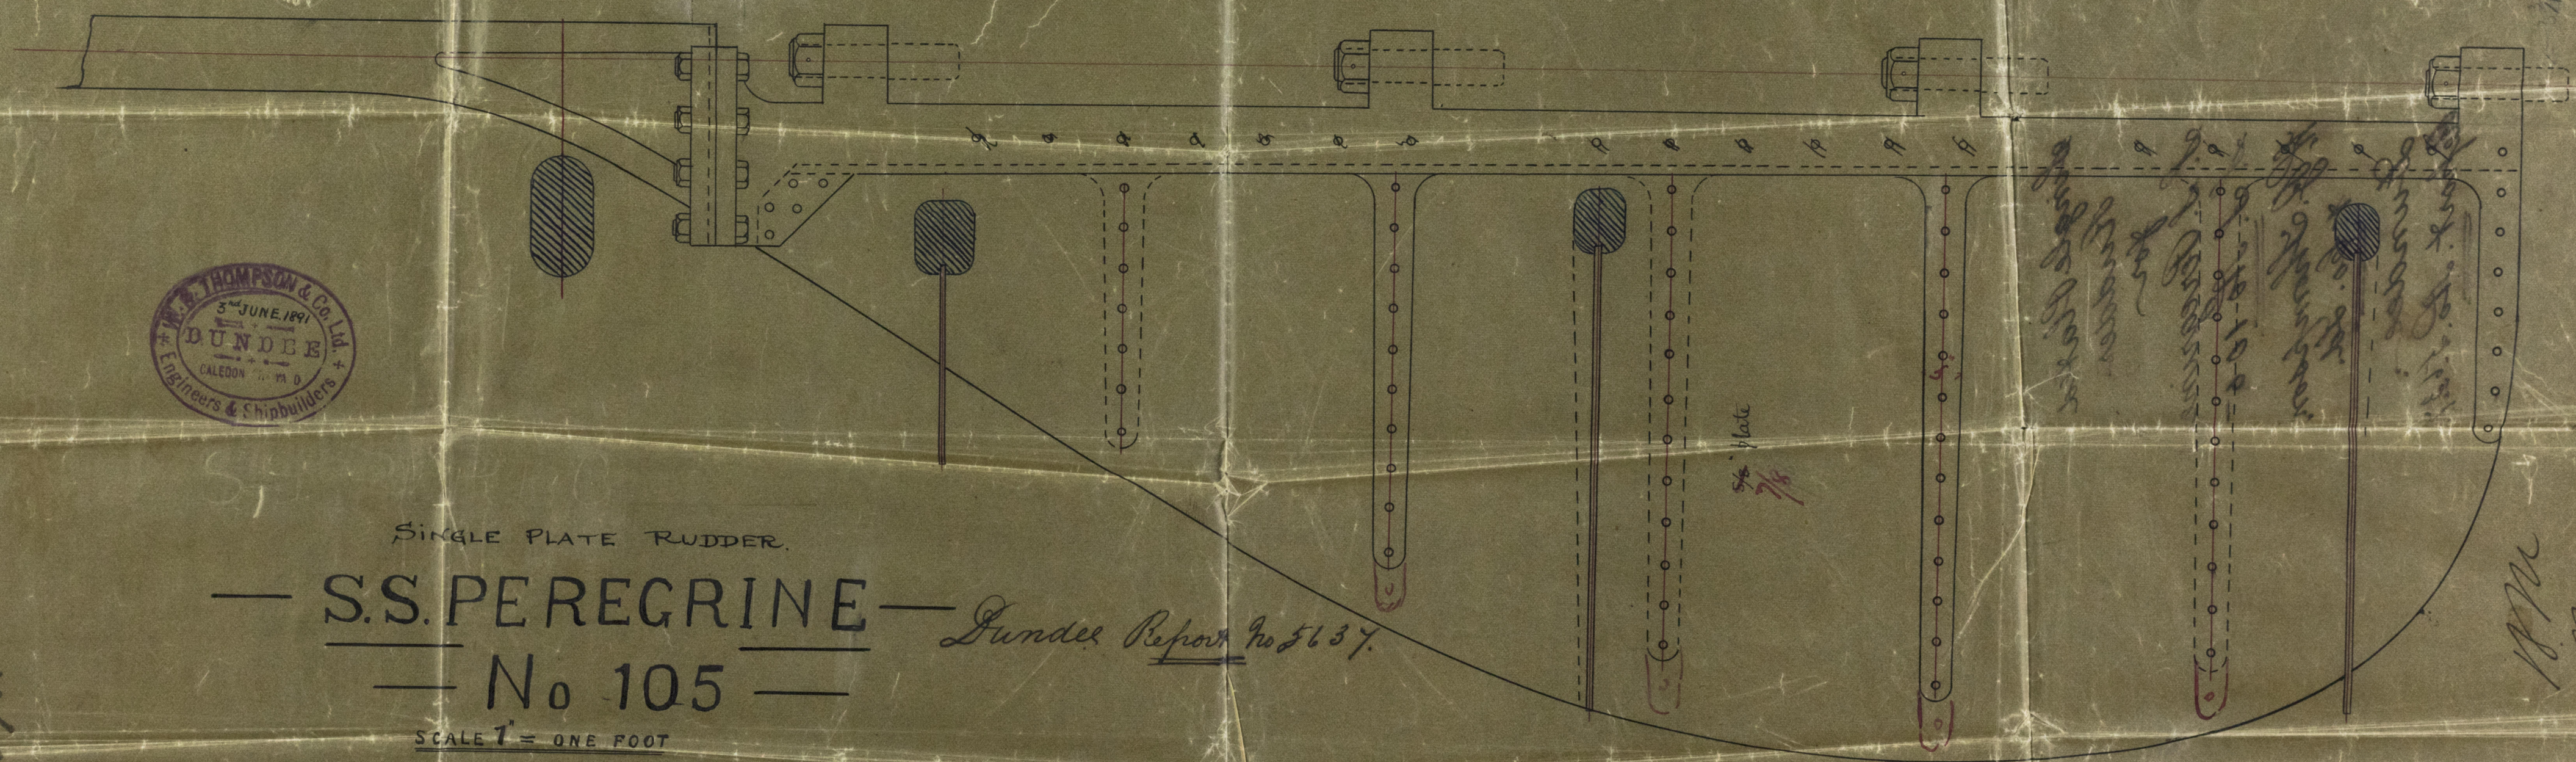

