

FRI 21 NOV 90

13.5.91

With frames in way
of half beams to be
connected at head
thus:—

13/11/90

Iron deck
DOUBLE 3" x 3/16"
BULB 8" x 1/4"

Web frame

Stringer plate 15" x 7/16"
base plate 3" x 3/16"
Diamond plate 30" x 21" x 1/4"

FRAMES BETWEEN
WEB FRAMES

BRIDGE DECK

Dundee


Report No. 5637

Engine & Boiler Spaces

Iron S.S. No. 105

Scale 1/4 inch = 1 foot

Lt. "Peregrine"

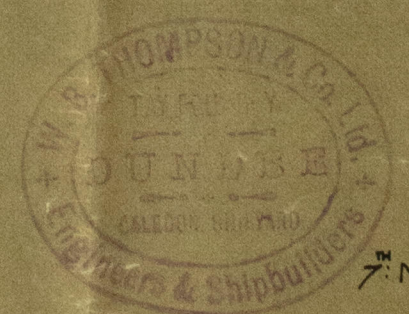

11th Nov. 90

MAIN DECK

LOWER DECK

17/6
20/11/90


Plan of
Engine & Boiler
Spaces.

S.S. No. 105.

H. B. Thompson
~~Esq.~~

S.S. "Peregrine".

Gundee
Report No 5637.

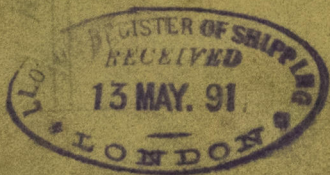

LR

© 2020

Lloyd's Register
Foundation
DUN118-0217