

Sundee
Report No 5648


SPAR PLAN

OF
N^{OS} 93 & 94

Scale 1/8 inch = one foot

Note. Metals in of Iron, Steel marked in Blue
 Yards
 Diameters given are inside of outside plates

30/1/91
 21/1/90.

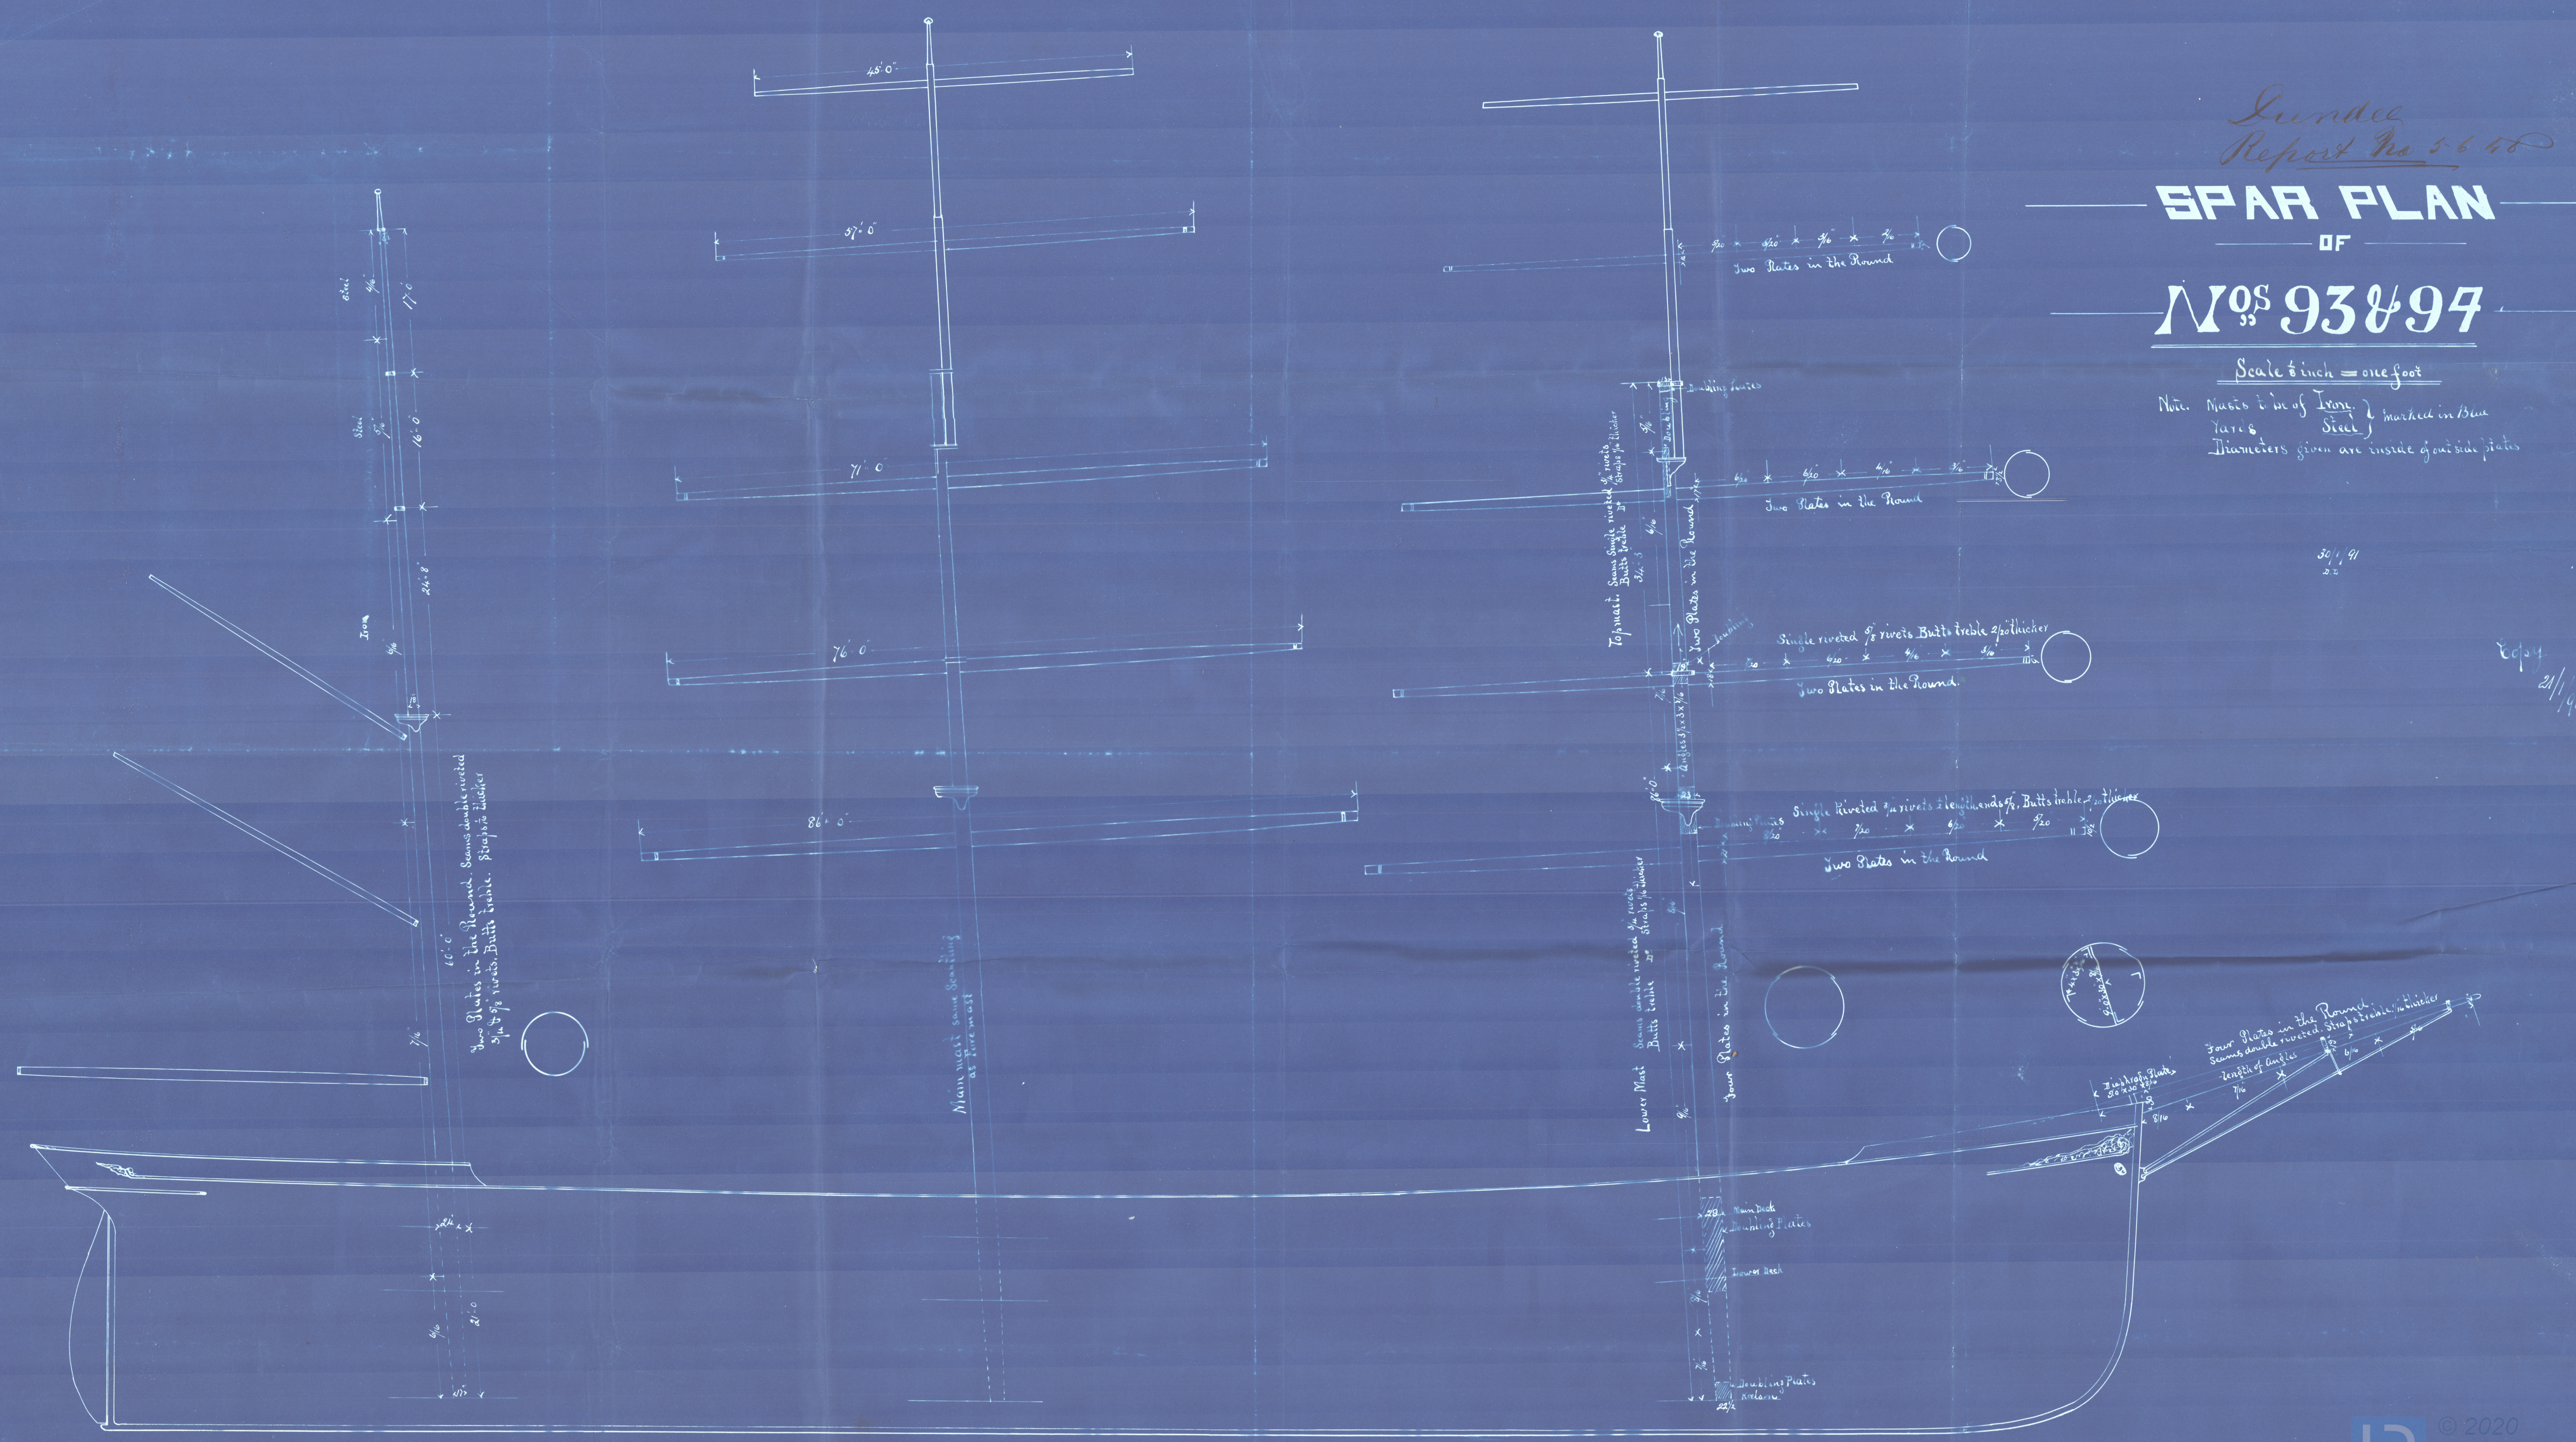

DON118 - 0220

Spar Plan
of
Sailing Ship
No 94.

© 2020
A. Stephen & Son,
Name "Kirkhill"