

— Longitudinal Joint —
— Half Siz —

— Note. Uptake and Tubes of Iron
— all other parts of Boiler of Steel
— Shell plates thick. —

— BOILERS N^o 305-16 — N^o 336.
SCALE 1" = 17'00" 28th Dec: '89 11th JULY

WORKING PRESSURE 80 LBS.
TESTING " 160 LBS.

Steel Donkey

Boiler

No 336

S. S. No 110



W. B. Thompson
& Co. Ltd.

Dundee.

Report No 5715.

S. S. Landa

No 620,
Lloyds test
160 lbs.
H.C. 30/12/91

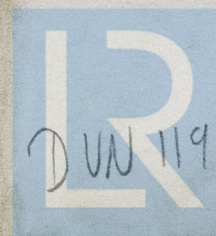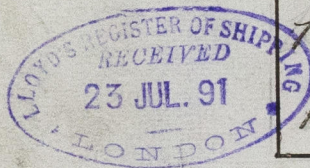

© 2020

DUN 119-0337

Lloyd's Register
Foundation