

21/7/91


S.S. 'Scanda' Tunde Report No 5715.

# Iron S.S. No. 110

243'3" x 33'6" x 16'11" MOULDED

CLASS 100 A.I.

SCALE 1/2" = ONE FOOT

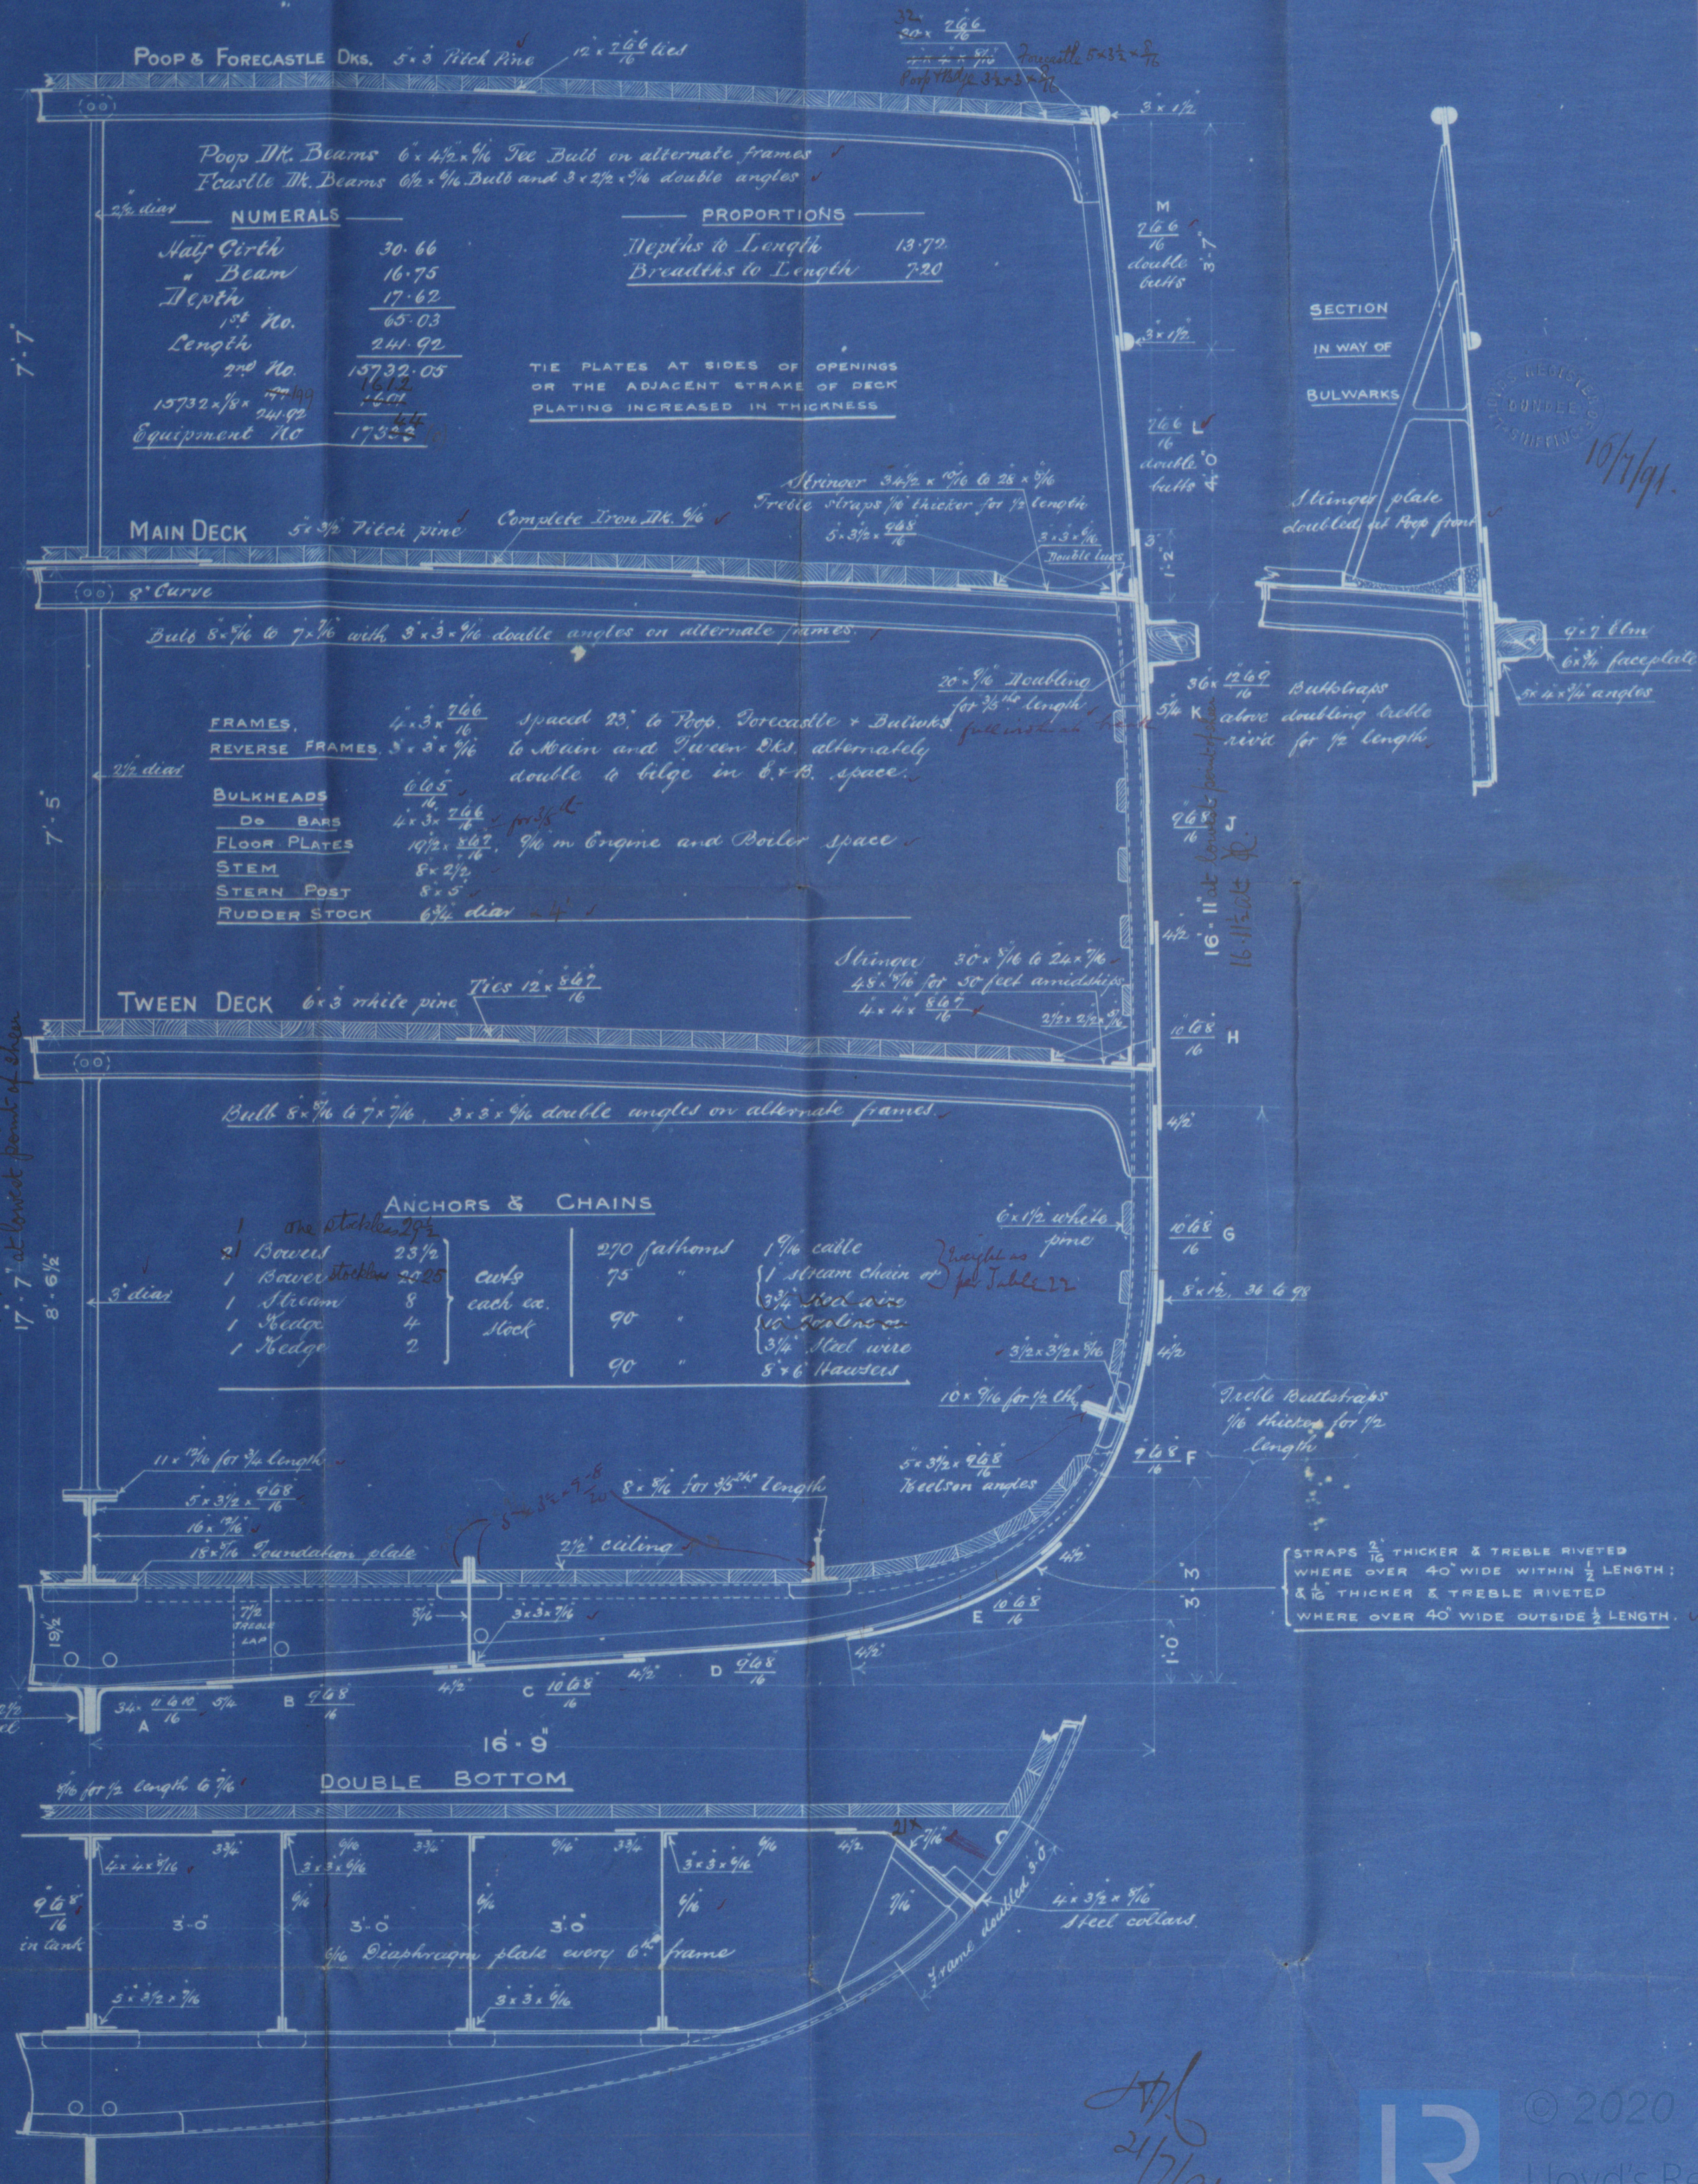



Midship Section  
for

S. S. No 110

W. B. Thompson & Co.  
Ld.

Class. 100 A1.

Owners. Glyde Shipping  
Co

Lundee.

Report No 5715.

S. S. "Sanda"



© 2020

Lloyd's Register

DUN119-0346 Foundation