


ONE BOILER ONLY
 HEATING SURFACE IN TUBES = 2748.7
 OTHER HEATING SURFACES = 687.16
 TOTAL HEATING SURFACE = 3435.86 Sq. FEET.

TOTAL GRATE SURFACE = 124.3 Sq. FEET.
 FIRE BARS = 6'-11" LONG.

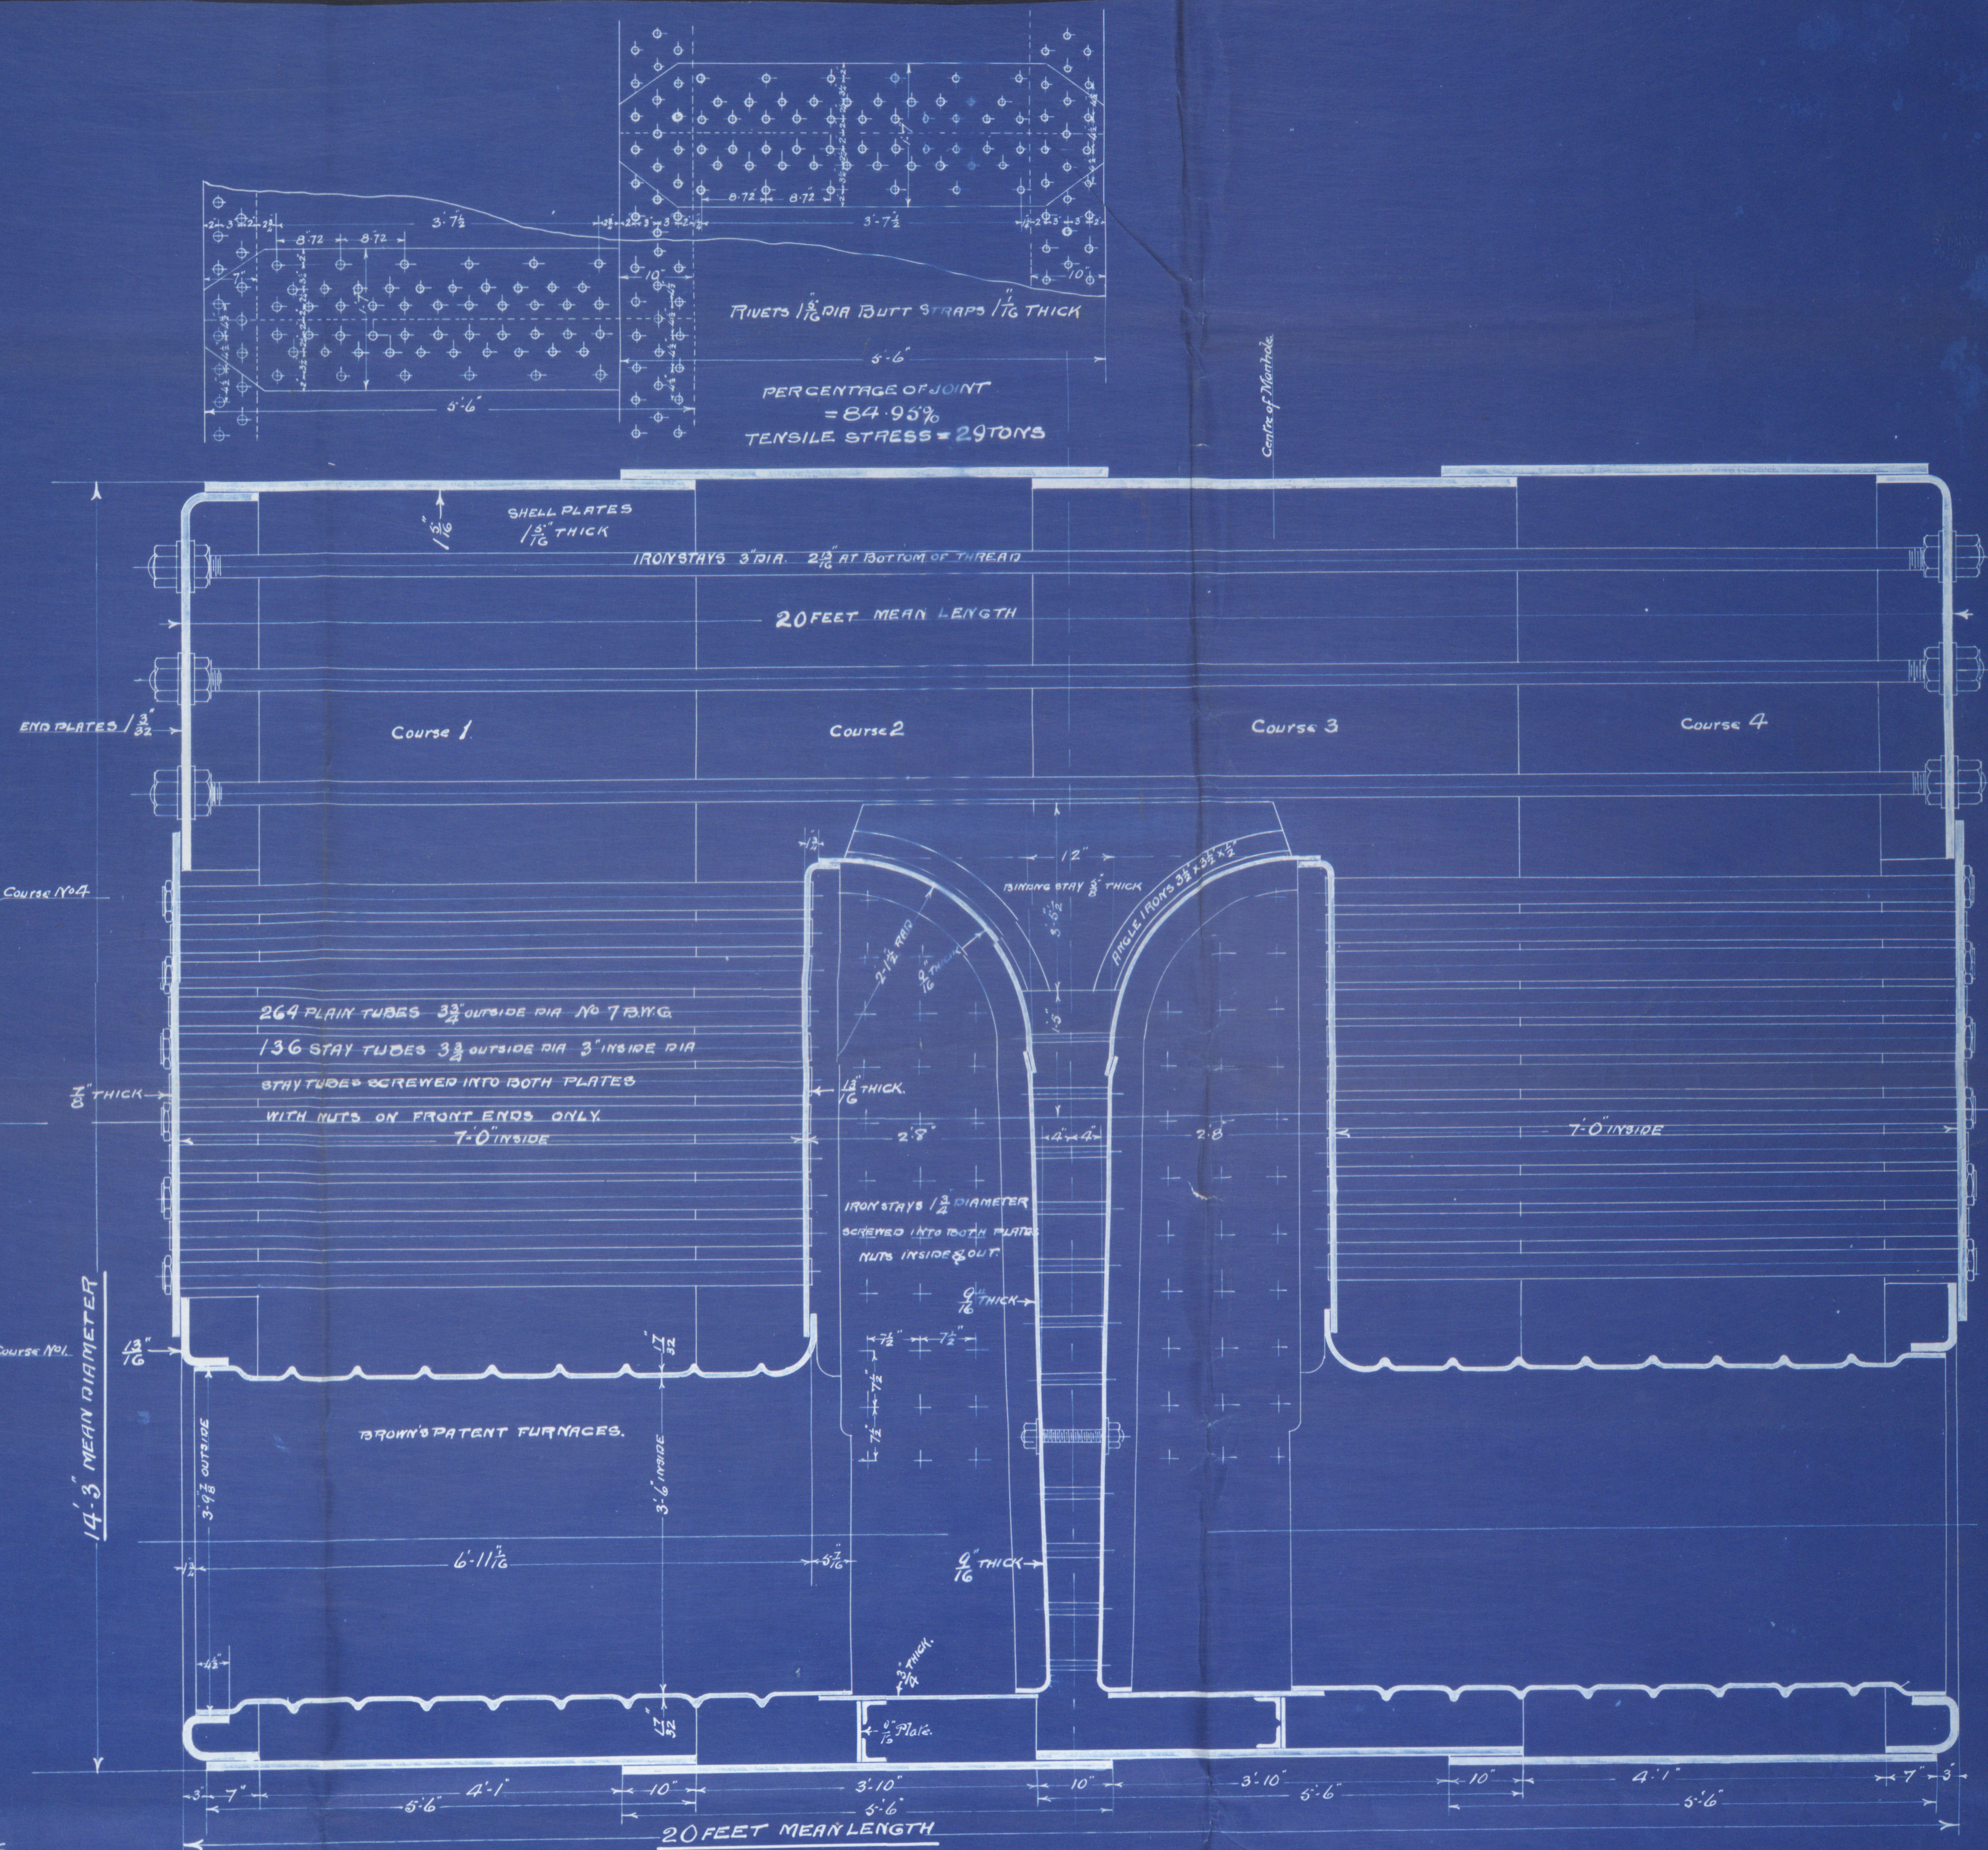

BOILERS NOS 339-40.

WORKING PRESSURE = 165 lbs.
 TESTING DO = 330 lbs.

SCALE 1 INCH = 1 FOOT.

7th SEPTEMBER 1891.

ALL OF STEEL UNLESS
 WHERE NOTED.

REGISTERED
 FOUNDATION

~~Original~~
Steel
Main Boilers

Nos 339 - 340
for
S.S. No 111.

W. B. Thompson & Co. Ltd.
Dundee

Report No. 5763

S.S. "Peregrine"



no 630.
Lloyds Test
330 lbs.
H.C. 11/5/92



© 2020

Lloyd's Register
Foundation