

6-



9.10.91.


— Section at Bank Wing —

— S. S. No 154 —



— Scale 1" = 1 Foot —

S.S. "Dungeness"

Dumdee Report No 5443

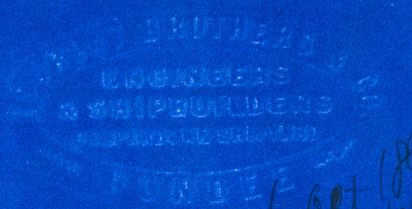

6 Oct 1891
H.C.

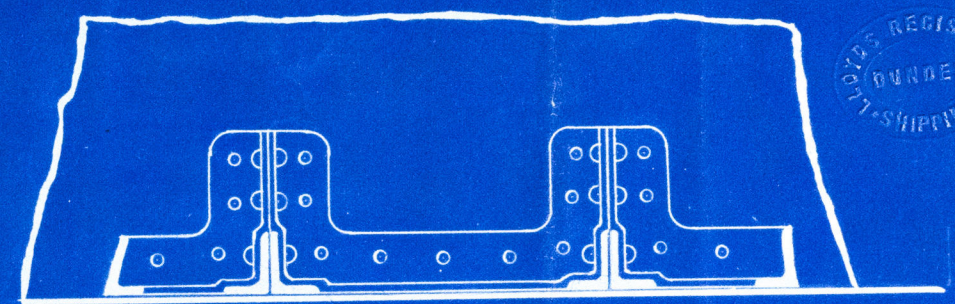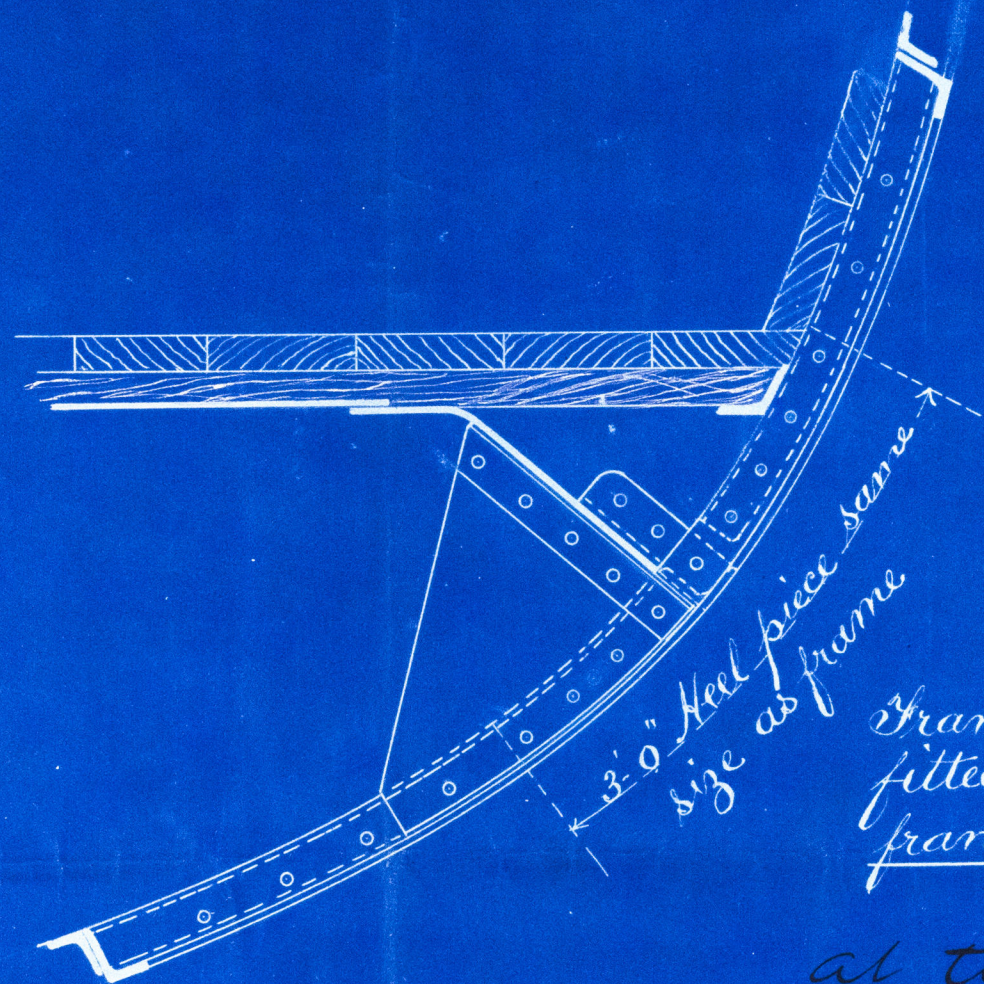


H.C.
8/10/91

Frames kept whole, Steel pieces
fitted to compensate for reverse
frame being cut

at the end of vessel

J.D.H.
9/10/91

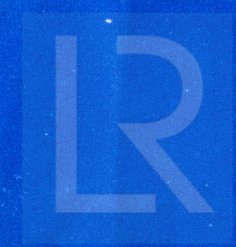

© 2020

Lloyd's Register
Foundation

000135-0116

Lank Wing Section

Iron Sec. Str.

No 154

Gourlay Bros. & Co.

Name. Dungeness.

Dundee

Report No. 5143.



© 2020

Lloyd's Register
Foundation

Dur120-0116