

22/4/92

	DESCRIPTION.	Wagon	Wheeler	Wheeler
1	Barge	8		Call
2	Wry Soc from Art Tank	4	1	
3	" " " "	4	1	Call
4	" " " "	4	1	Call
5	" " " " off	4	1	
6	" " " " Tanks & Sea	4	1	
7	" " " " " & Belges	4	1	
8	Port Barge Pump Soc from Sea	3	1	
9	" " " " " Belges	3	1	
10	Spur	3	1	
11	Wagon from Centre Ring Room	3	1	
12	" " " " Belges	3	1	
13	Port Pipe Room Belges	3	1	
14	Ward " " "	3	1	
15	Port " " "	3	1	
16	Port Belges	3	1	
17	Port Hold " "	3	1	
18	Plan " " "	3	1	
19	Tonnage of 1st Hold Belges	6	1	
20	" " 2nd " "	3	1	
21	Wagon & Boat cargo	3	1	
22	" " " " (Stow)	3	1	
23	Wry Soc from 1st Tank	4	1	Call

Amended
Pumping Plan.

Engines No 318.

For

S. S. No 154.

Gourlay Bros. & Co.

Owners.

Clyde Shipping Co.

Name.


S. S. "Dunferness"

Class


100 A 1"

Dundee

Report No. 5443.

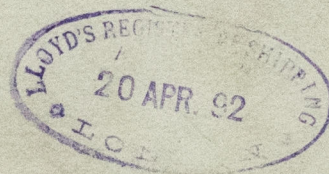

D4N120-0130

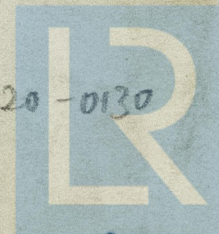

© 2020

Lloyd's Register
Foundation