
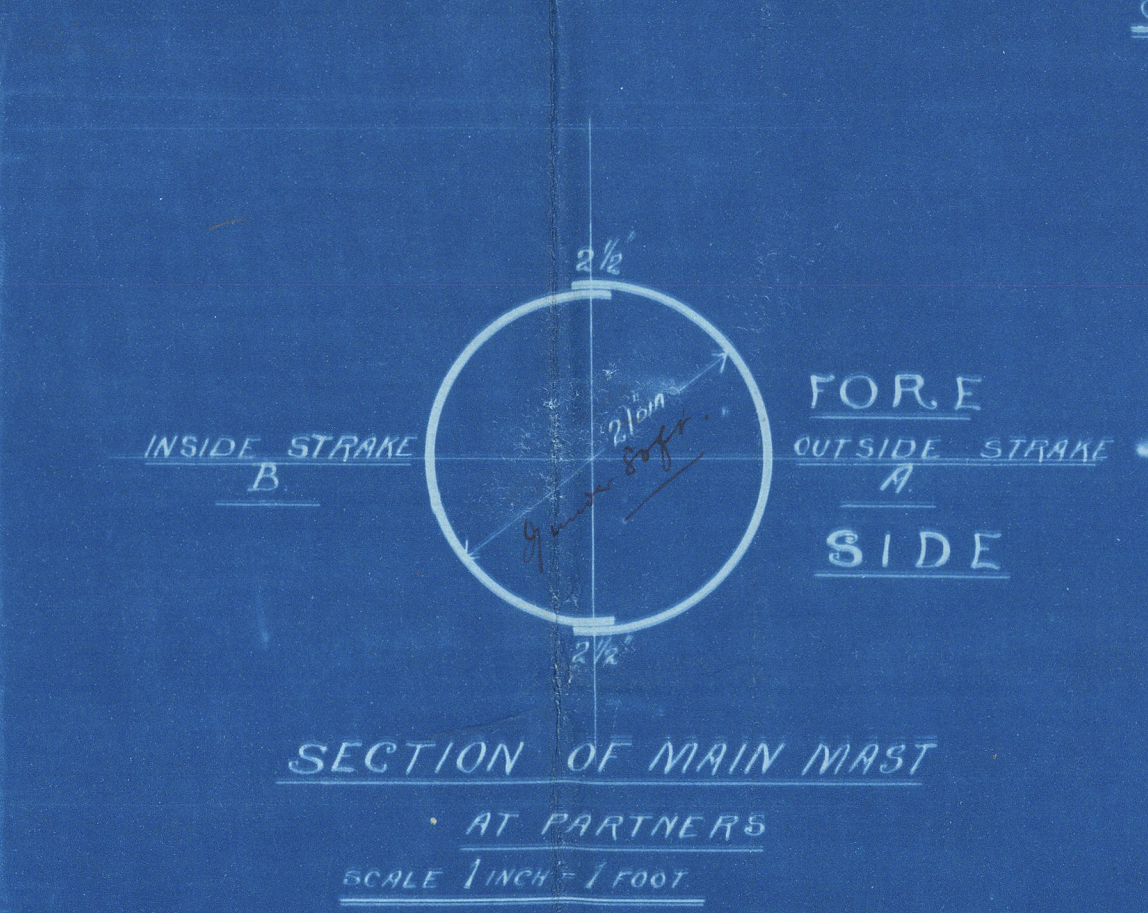
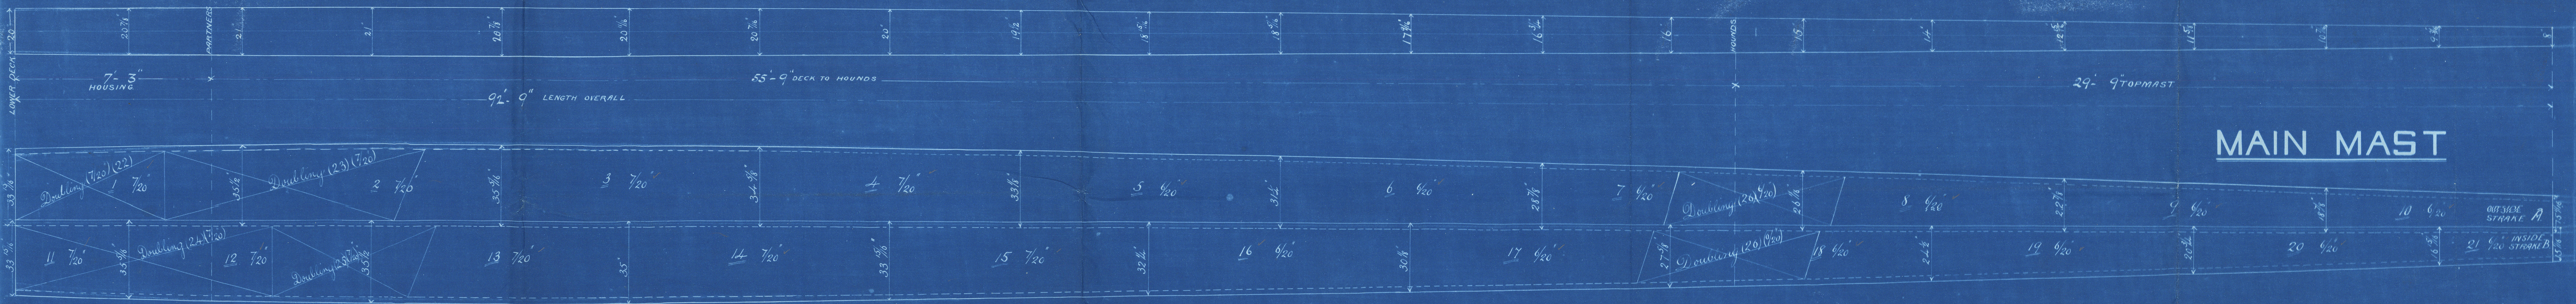


11.2 92-

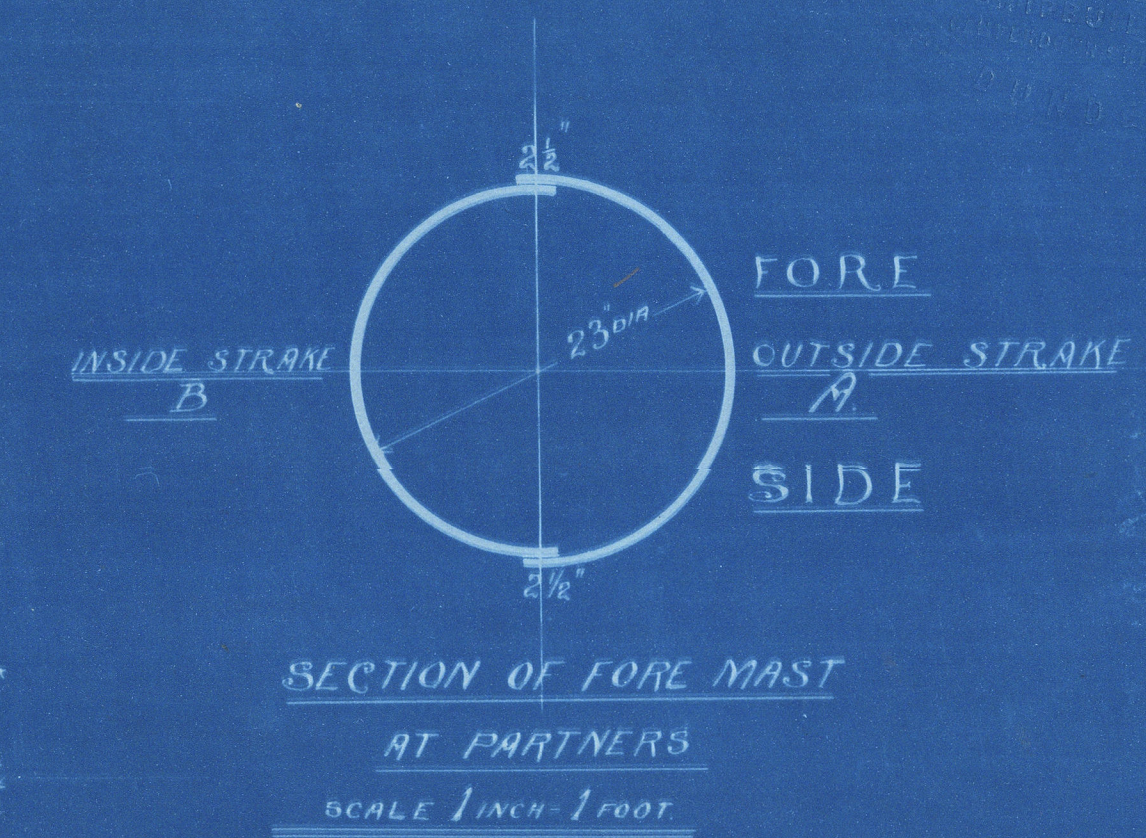

Steel Pole Masts.
S.S. No. 154
Scale 1/2 Inch = 1 Foot

Both masts to have two plates in the round
Seams 2 1/2" broad, single riveted, 3/4" rivets,
Spaced 3 3/4" centre to centre.
Bullstraps treble rivetted throughout.
Bullstraps 1/2" thicker below deck.
" 1/20 " above hounds.
" 2/20 " from deck to hounds.
Rivets in Bullstraps spaced 5 diameters apart.
All Bullstraps fitted inside.
Reels of Masts to be efficiently strengthened.

S.S. Dungeness
Dunlop Report 57.

Mast = Plan.

S. S. = No 154.

Name :- S.S. "Dungeness"

Gourlay Bros. & Co.

Owners.

Clyde Shipping Co.

Class :- "100 A"

Dundee

Report No. 5743.

D4d120-0146



© 2020

Lloyd's Register
Foundation