





Main Deck

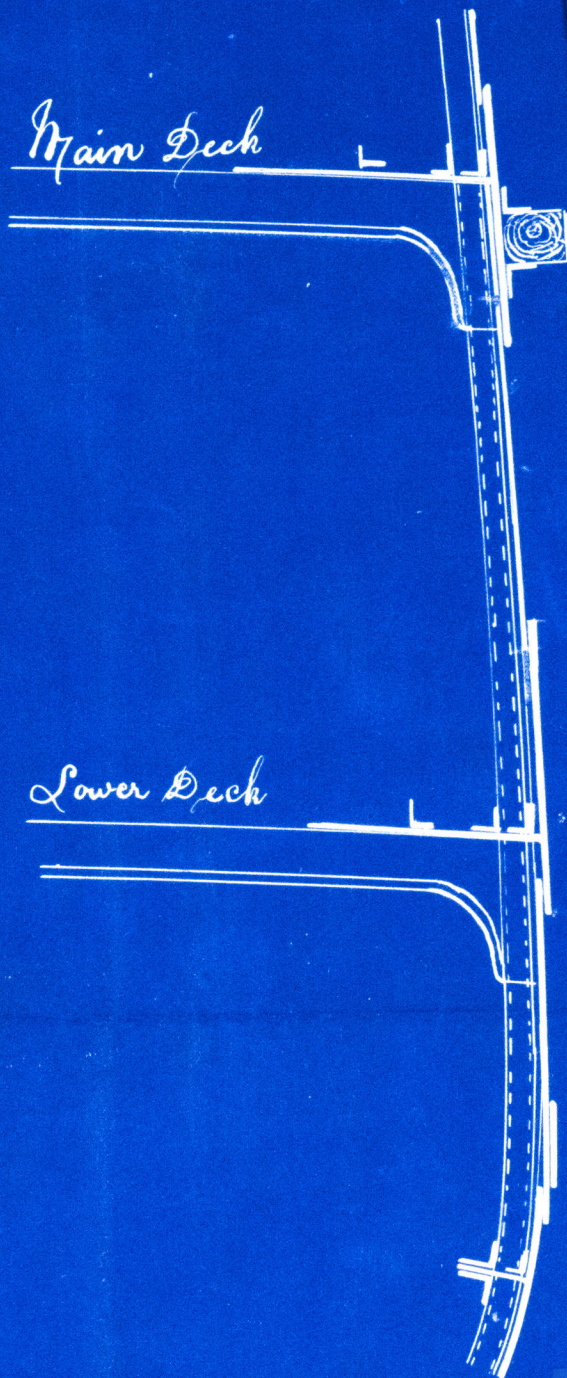

Shearstrake  $36 \times \frac{12.9}{16}$

I  $47\frac{1}{2} \times \frac{9.3}{16}$

Side plating as fitted in ship

H  $39\frac{1}{2} \times \frac{10.8}{16}$

Lower Deck


G  $48 \times \frac{10.8}{16}$

$12 \times 1\frac{1}{4}$  for 130 feet



© 2019

Lloyd's Register  
Foundation

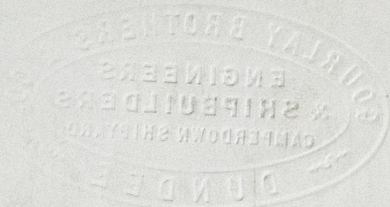

*Run. No 5913.*



© 2019

Lloyd's Register  
Foundation

DW120-0147