

MIDSHIP SECTION


Iron & Steel Sailing Vessel, No Class 100. A.
in Lloyd's Register

No 95

Scale, 1/2 Inch = One Foot

8/6/91

Melita
Dunder
Report No 5498

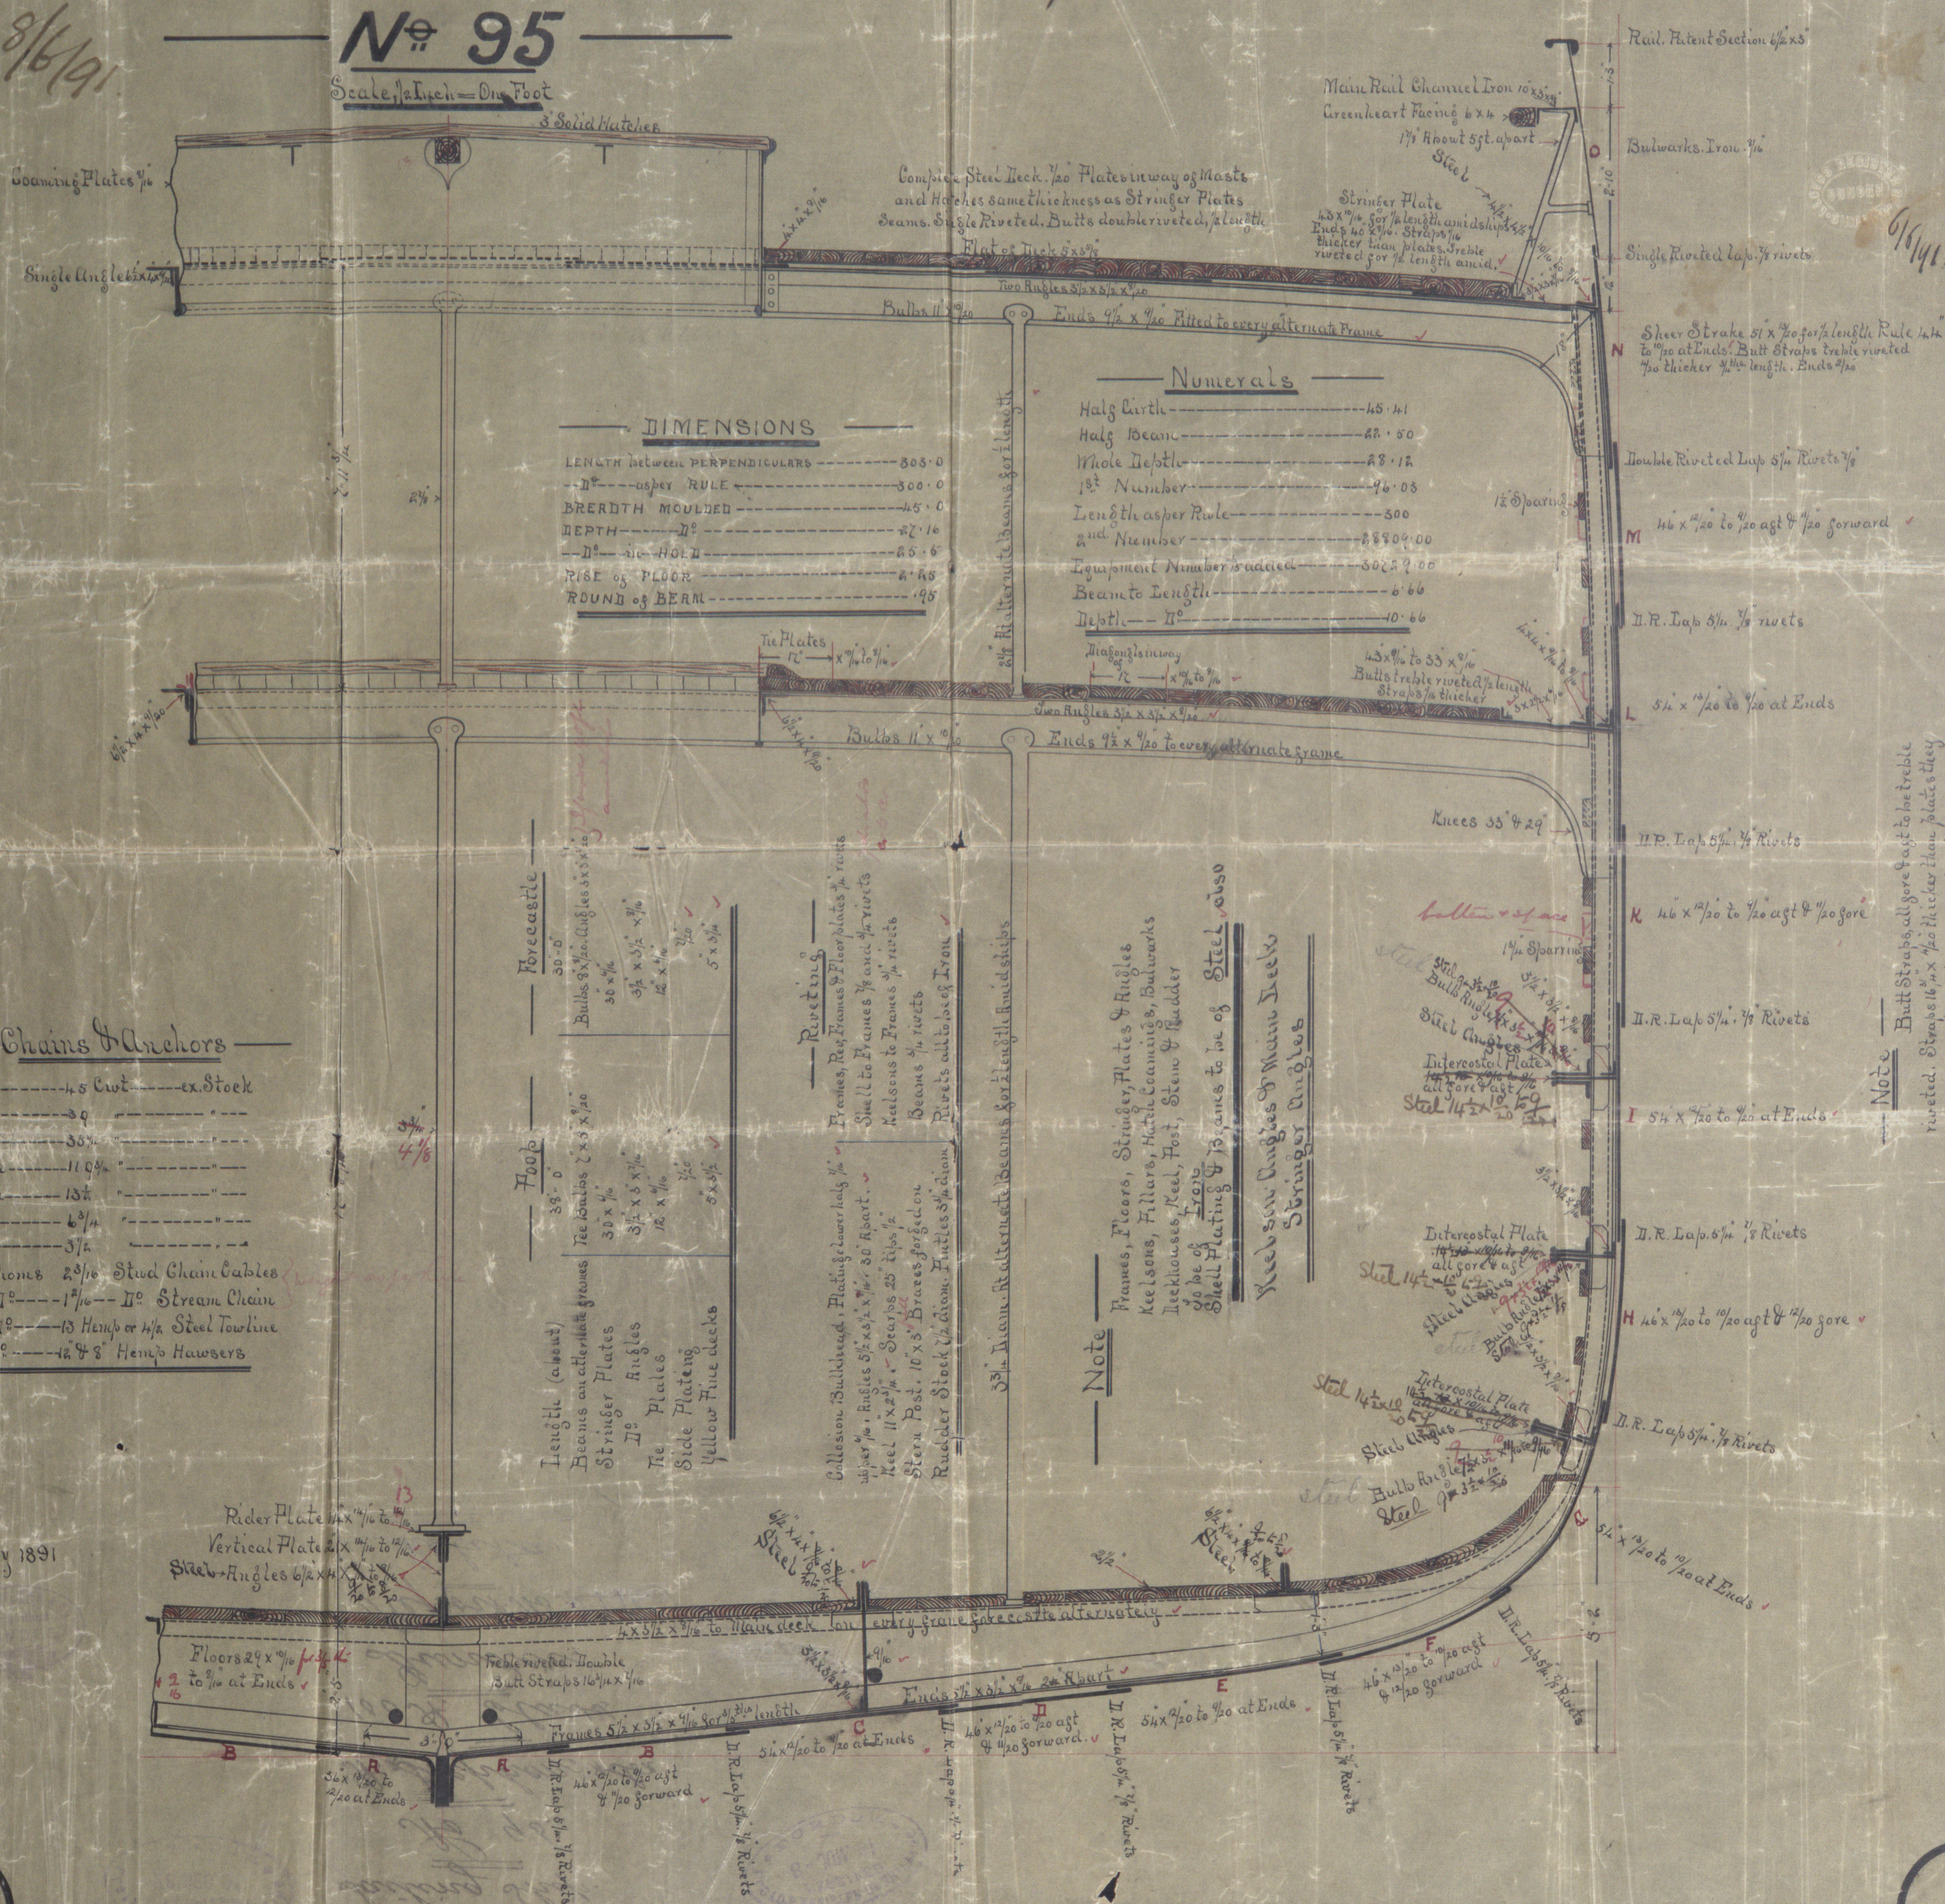

DIMENSIONS

LENGTH BETWEEN PERPENDICULARS	303.0
— — — — —	300.0
BREADTH MOLDED	45.0
DEPTH	27.10
— — — — —	25.5
RISE OF FLOOR	2.45
ROUND OF BEAM	1.95

Numerals

Half Girth	45.41
Half Beam	22.50
Whole Depth	28.12
1st Number	46.03
2nd Number	2890.00
Equipment Number added	50.29.00
Beam to Length	6.66
Depth — — — — —	10.66

Chains & Anchors

1 Bower	45 Cwt	ex Stock
1 1st	39	
1 2nd	35	
Collective	119	
1 Stream	13 1/2	
1 Kedg	6 3/4	
1 1st	3 1/2	
300 Fathoms	2 3/4	Stud Chain Cables
180 — — — — —	1 1/2	Stream Chain
90 — — — — —	1 1/2	Hemp or 1/2" Steel Towline
90 — — — — —	1 1/2	Hemp Hawsers

Note
Frames, Floors, Stringer Plates & Angles
Kee Irons, Fillers, Hatch Coaming, Bulwarks
Intercoastal Keel, Post, Stern & Rudder
30 lb of Iron
Shell Plating & Joins to be of Steel also
Keel son Angles & Main Decks
Stringer Angles

Note
Butt Straps, all gore fast to be treble
riveted. Straps 1 1/2" x 1/2" thicker than plates they
connect for 1/2" the length and end ships
Remainder 1/2" thicker

21st May 1891

Report No. 5498
Melita



D44120-0370

[illegible]


For 6608176

