

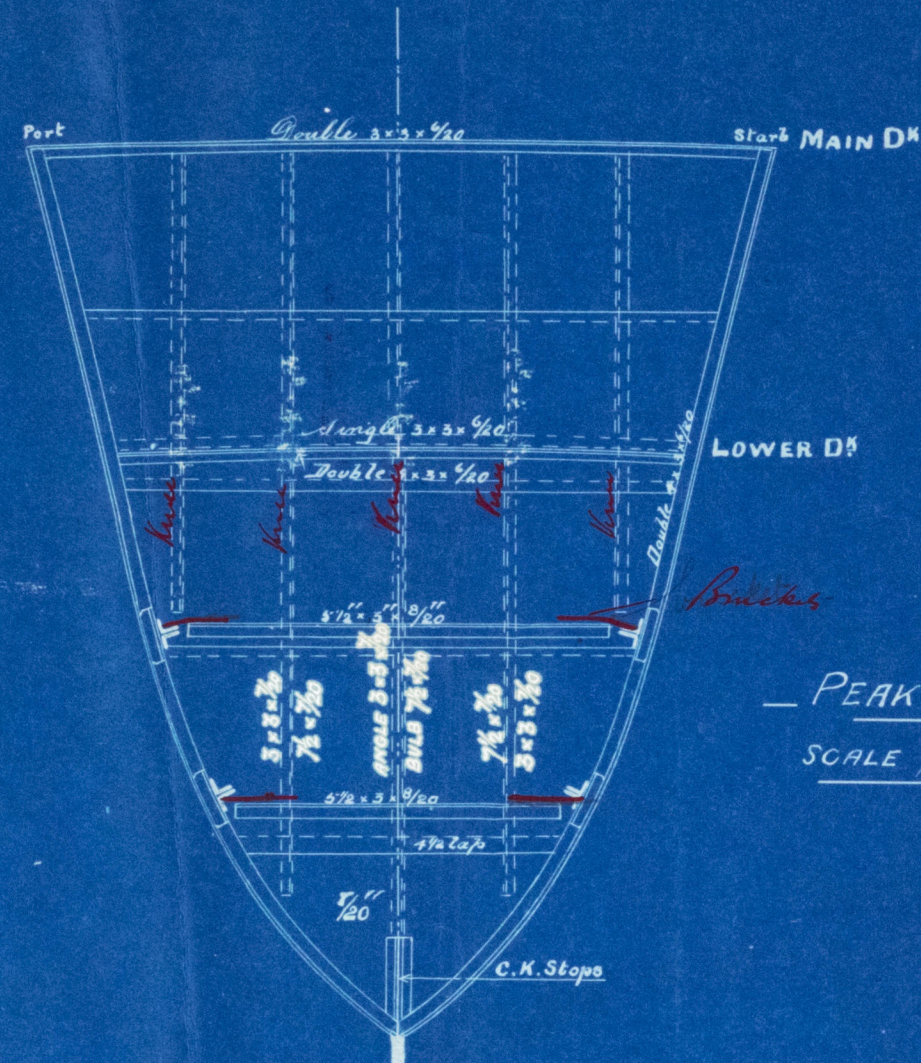


12.6.93

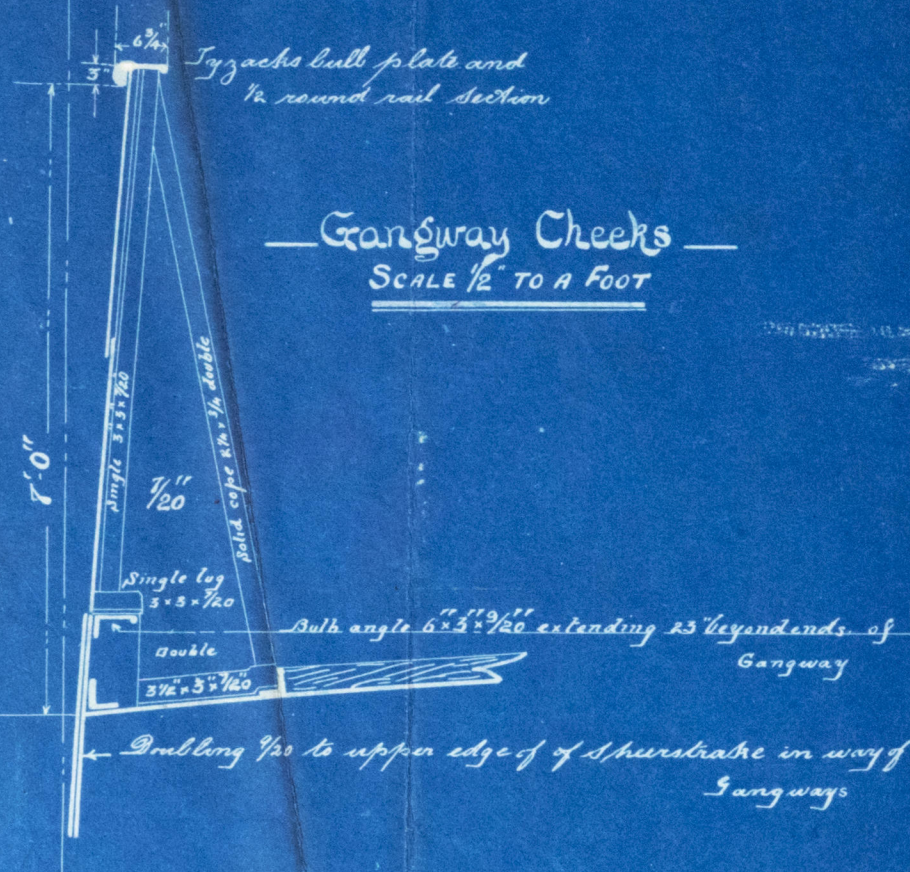


Watertight Bh² 115 afterside
 Horizontal Stiffeners 5 1/2" x 3" x 9/20
 Vertical 4" x 3" x 7/10
 Plating 9/20
 Doublings about 4' 1" long on outside strakes

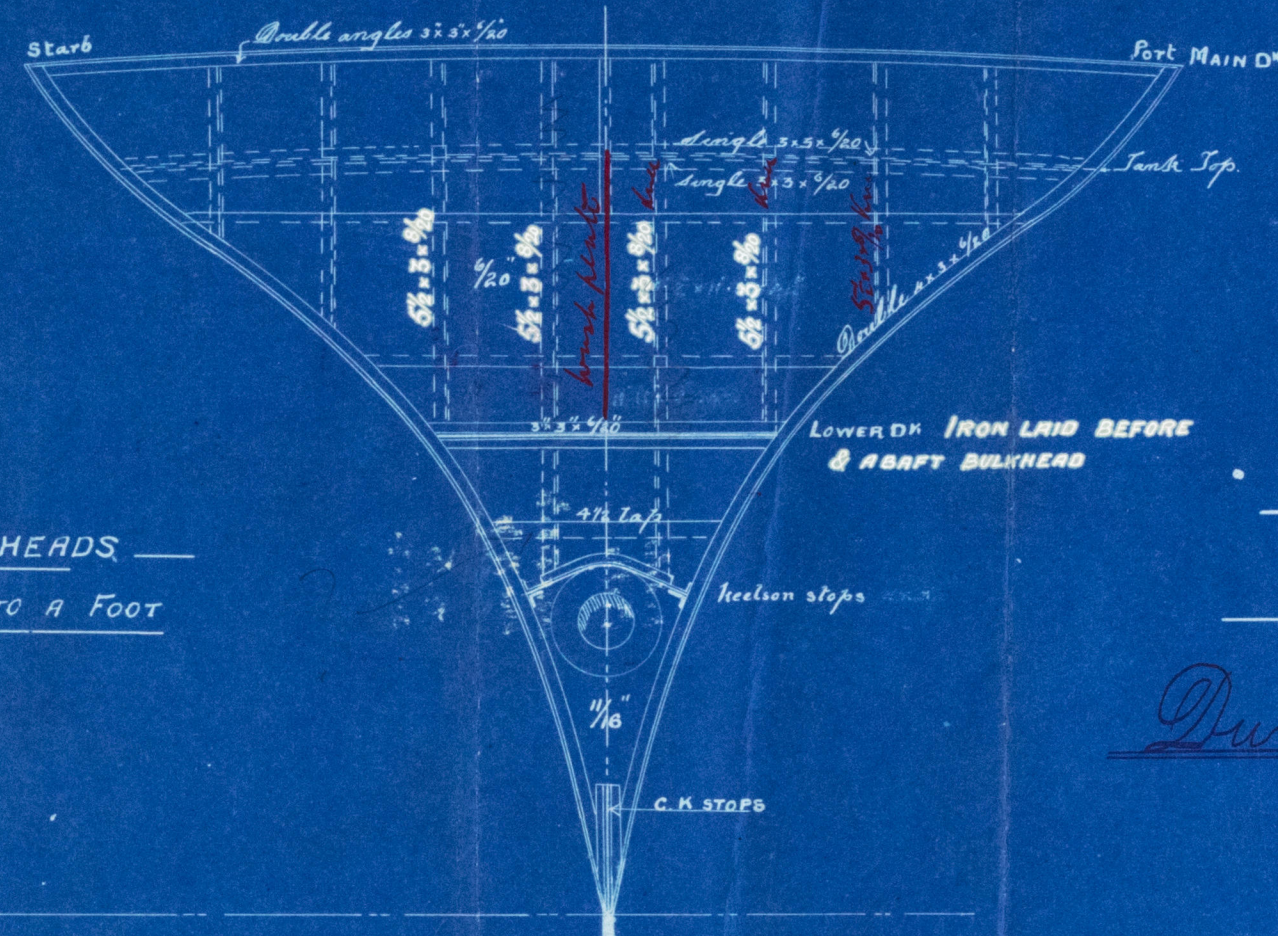

Watertight Bh² 8 Foreside
 Horizontal Stiffeners 3" x 3" x 9/20
 Vertical 5 1/2" x 3" x 9/20
 Plating 9/20
 Doublings about 4' 1" long in way of outside strakes of shell plating

"Glasgow"
 S. S. "STIRLING"
 No 122.

Dundee Report No 5953.

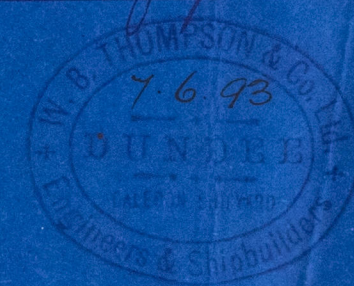

Dundee 122-0173

No 122.

PEAK BULKHEADS
CARGO GANGWAYS.

of
Glasgow
S.S. "STIRLING"

W. B. Thompson & Co.

S. S. No 122

Dundee.

Report No 5953



DUN122-0173



© 2020

Lloyd's Register
Foundation