

## Lloyd's Register of British and Foreign Shipping.

(Report on Vessel No. 5953 Port Dundee)No. 202

## SHIP FORGINGS OR CASTINGS.

The words FORGINGS or CASTINGS, IRON or STEEL, should be struck out as may be required.

I have to report that the undermentioned Iron ~~or Steel~~ Forgings ~~or Castings~~, manufactuerd by  
Messrs James Carmichael & Co. of Dundee,  
 for the Vessel No. 122, being built by Messrs W.B. Thompson & Co. Ltd.  
 of Dundee have been inspected by me as set forth below, and found  
 to be, so far as can be seen, Sound,


Mark on Forgings.

Lloyd's

No. 287HC. 7/93Harry ClarkeDundee

	STERN FRAME.	RUDDER FRAME.	STEM.
Material* - - -	<u>Scrap Iron</u>		
How made - - -	<u>Forged</u>		
Dimensions - - -	<u>8 x 4 <math>\frac{3}{4}</math></u>		
Progress on Inspection -	<u>Finished</u>		
Dates when Inspected	<u>June 14-28. July 6</u>		

SKETCHES OF FRAMES SHEWING POSITION AND DESCRIPTION OF WELDS OF FORGINGS, OR PARTICULARS OF TESTS APPLIED TO CASTINGS.

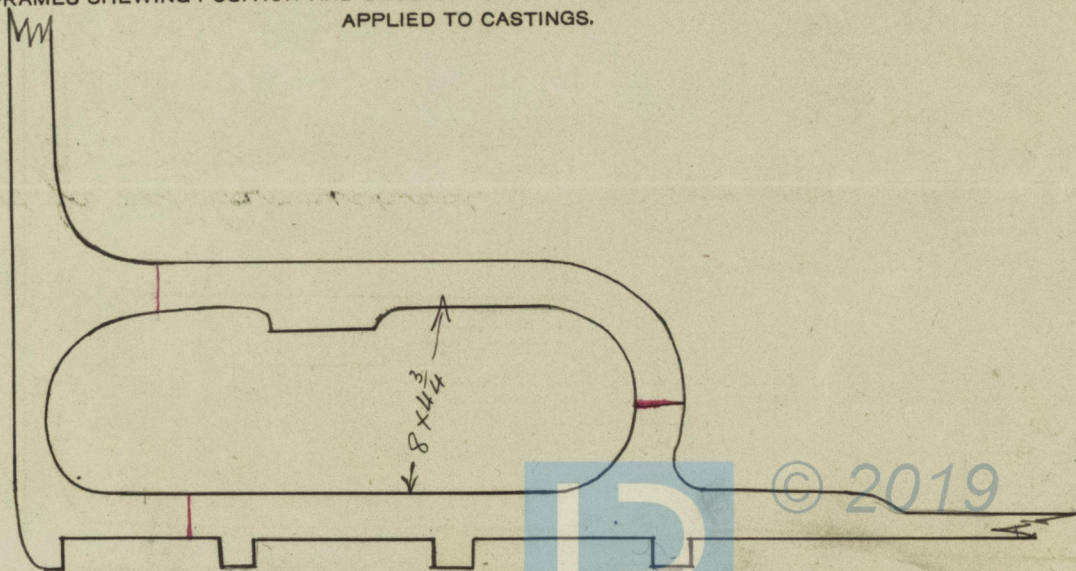

\* If of Iron, state whether scrap or puddled Iron.



Report on Stern Frame  
153/ "Glasgow"  
Dundee Report N° 5953



© 2019

Lloyd's Register  
Foundation