

S. S. Glasgow. Dundee
Steel Screw Steamer Report No. 5953

29.5.93

No 122



240' x 31'-10" x 16'-11" MOULDED

Scale 1/2" to a foot

Class 100 K steel

30.5.93.

Main Deck

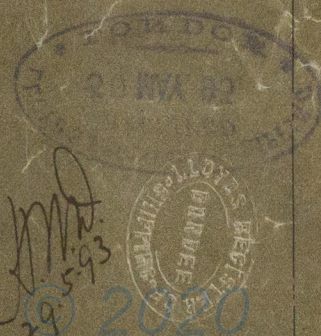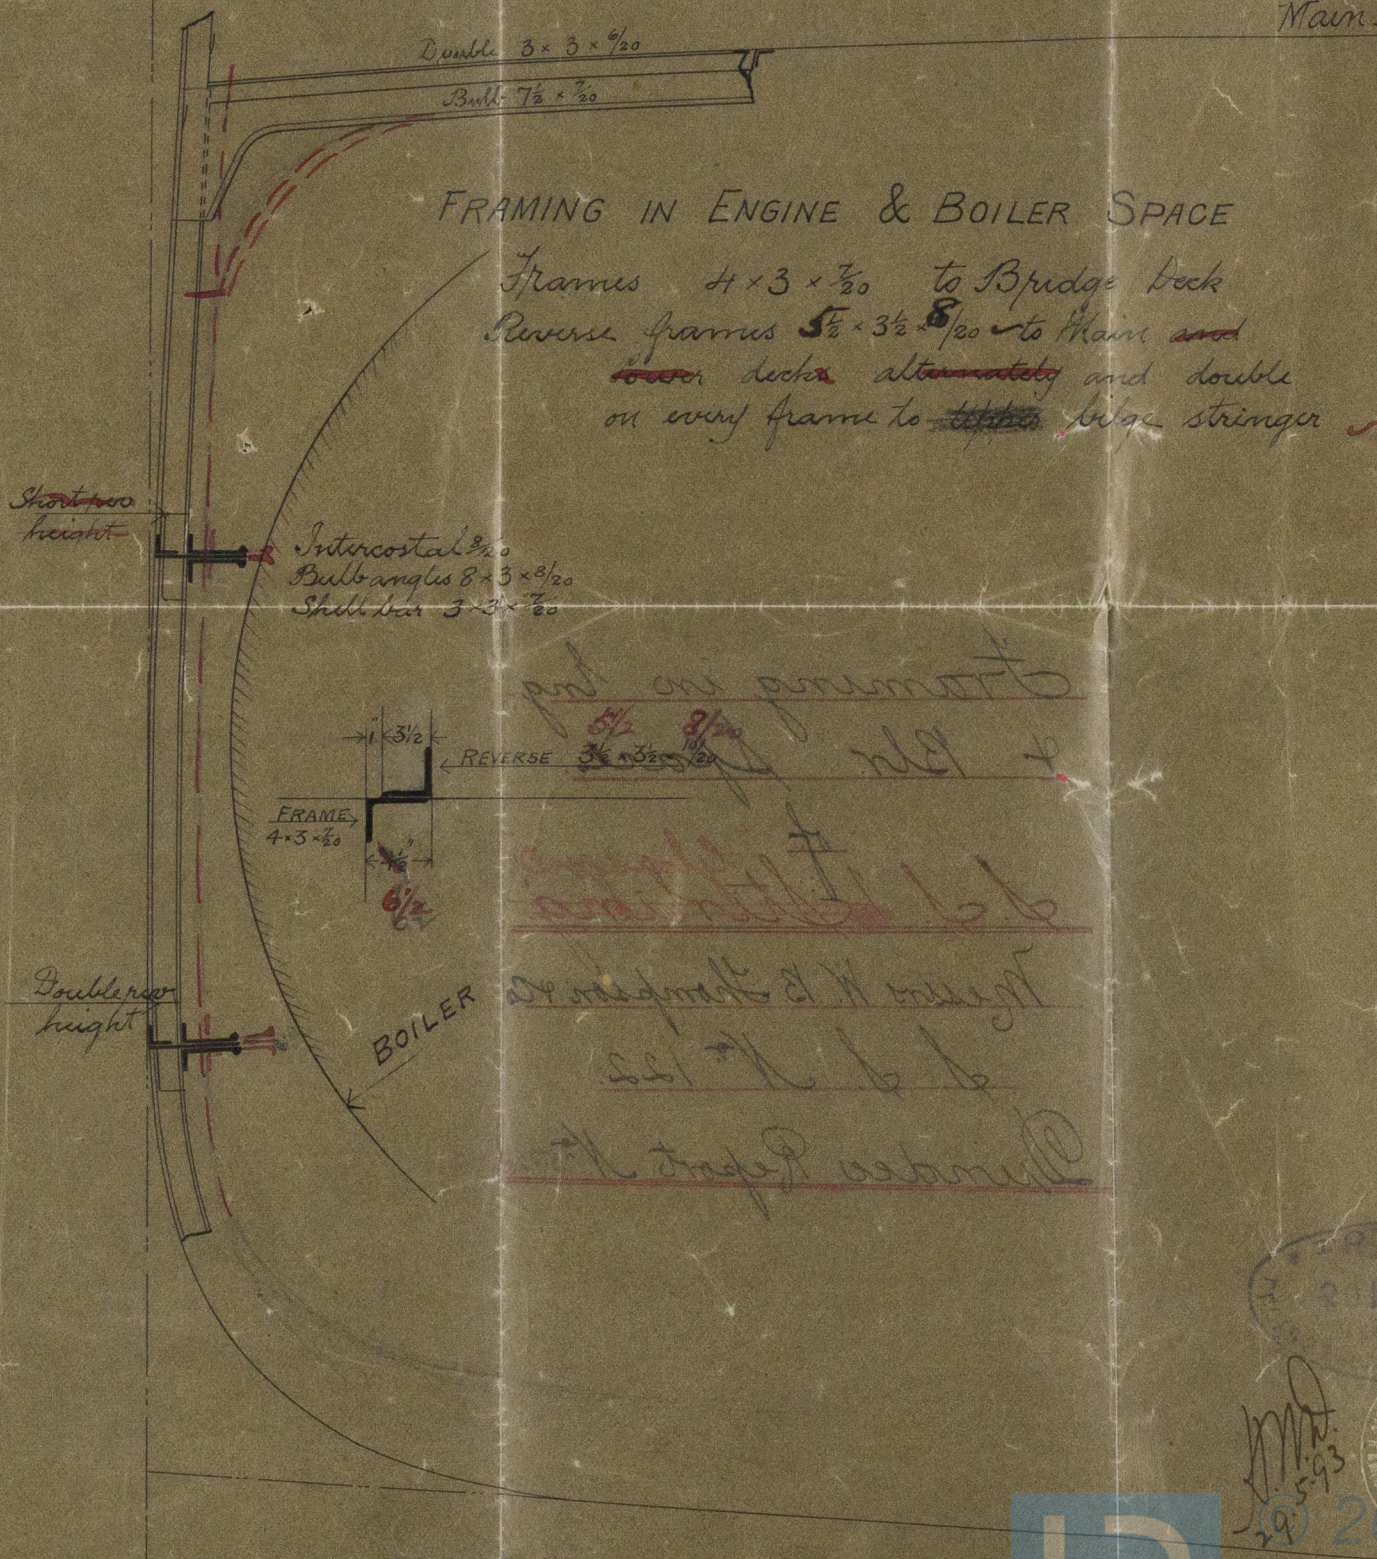

Lloyd's Register
 Foundation

DUN122-0259

Framing in Eng.
& Blr. Space.

S. S. ^{of Glasgow} Stirling.

Messrs W. B. Thompson & Co

S. S. N^o 122.

Dundee Report N^o 375.

© 2020

Lloyd's Register
Foundation