
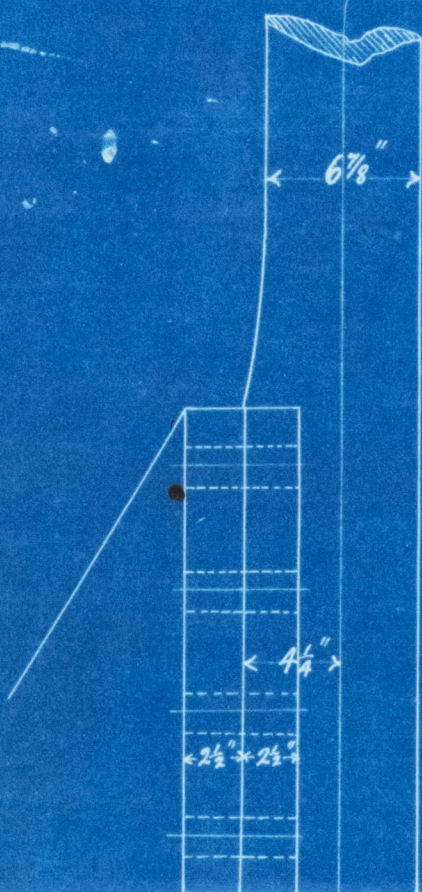



LOYS REGISTER
NEW YORK

6.6.95

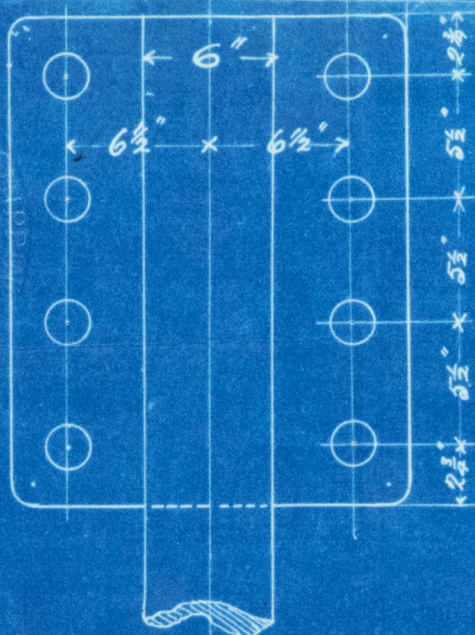

3/5/95

W. M. W.

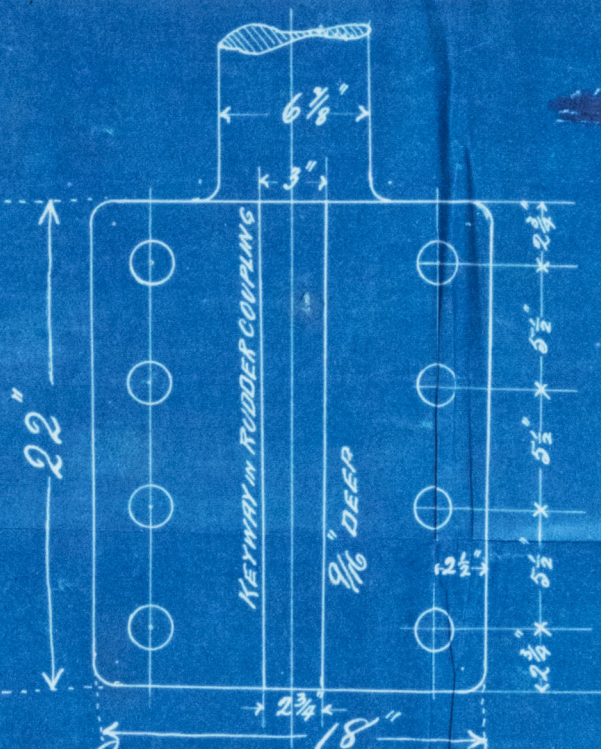


J. L. L.

5/6/95

COUPLING ON RUDDER STOCK

SCALE 1 1/2" = 1 FOOT

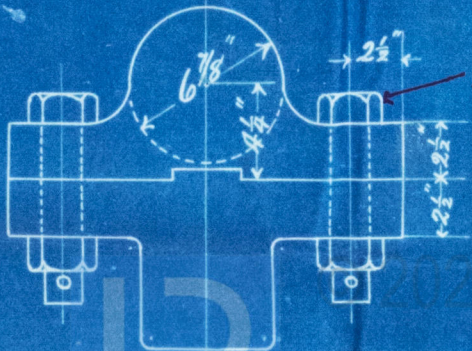

Bolts
2" Dia.

LOYS REGISTER
NEW YORK
J. L. L.
31.5.95

PLAN OF COUPLING ON RUDDER STOCK

SCALE 1 1/2" = 1 FOOT

DUN 123-0326

PL



DUN123-0326



© 2021

Lloyd's Register
Foundation