



25. 1. 95

230'-0" x 32'-0" x 14'-4" moulded dimensions  
To Class 100A Lloyds. (steel)

- ✓ Frames <sup>Note</sup> ~~not~~ <sup>in</sup> ~~essential~~ in double
- ✓ bottom steel  $\frac{1}{2}$  to  $\frac{3}{4}$  above Lloyd's requirements
- ✓ also tank top iron  $\frac{1}{2}$  above Lloyd's
- ✓ requirements

18m J.V.L.  
24/1/95



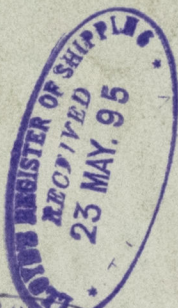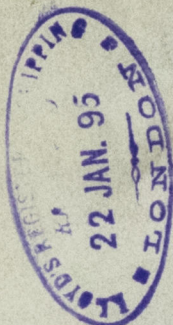

Midship Section

Goulay Bros & Co. No 3

of Sardinia

Dundee Report No 115

DUN23-0336



© 2021

Lloyd's Register  
Foundation