

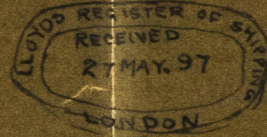
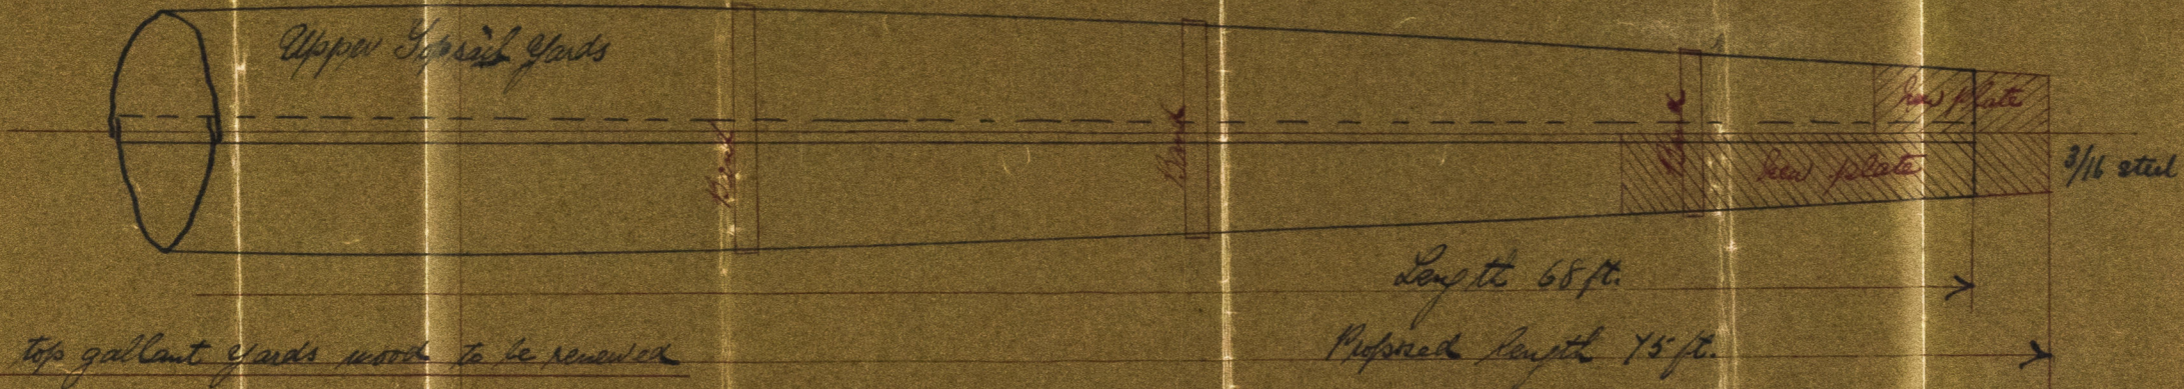


1.6.97

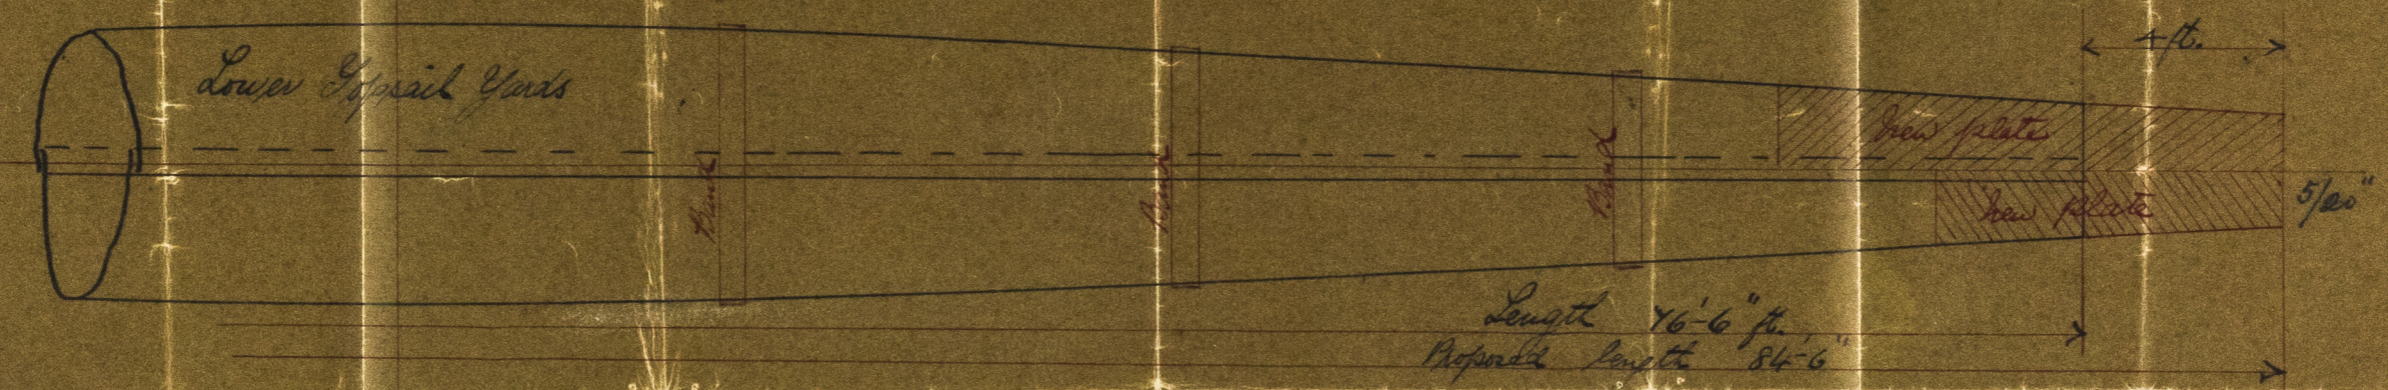

(Copy)

Proposed lengthening of Girders Ship Alster or California

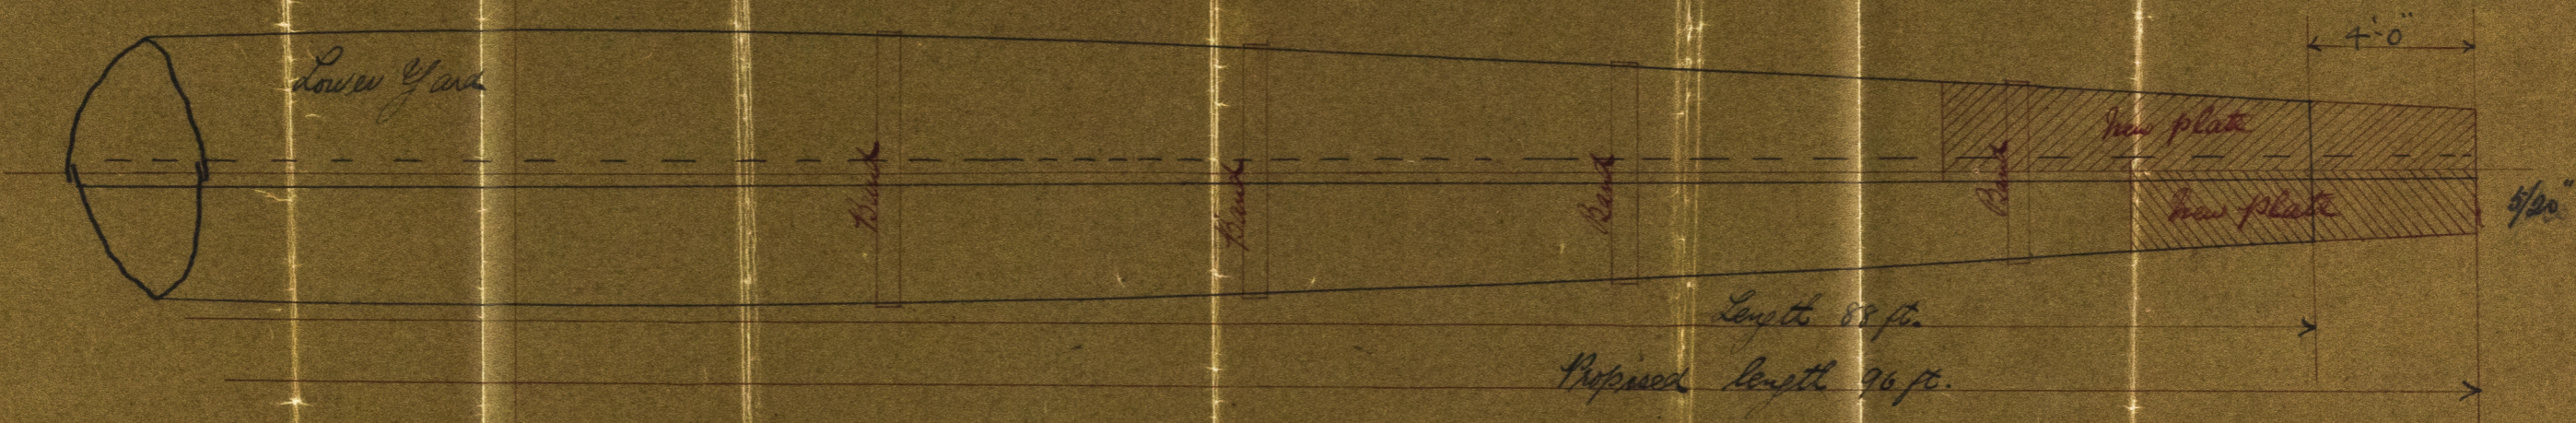

Main & fore lower & upper top gallant yards woods to be renewed & lengthened as follows:-

Main & fore lower top gallant yards	from 60' to 65'
Upper " " "	51'6" to 54'
Royal yards	41' to 44'

Initialled

H.K.

1/6/97



© 2021

Lloyd's Register Foundation