

Lloyd's Register of British and Foreign Shipping.

(Report on Vessel No. 6413 Port Dundee.)

No. 4091 SHIP FORGINGS ~~OR CASTINGS~~.

I have to report that the undermentioned Iron or Steel Forgings ~~or Castings~~,
 manufactured by Messrs Emerson Walker & Thompson
 of Dunston for the Vessel No. 117, being built
 by The Dundee S & Co of Dundee
 have been inspected by me as set forth below, and found to be, so far as can be seen,
sound


Mark on Forgings.

Lloyd's
No. 7623

John Craig
Newcastle

	STERN FRAME.	RUDDER FRAME.	STEM.
Material* ...	<u>Scrap</u>	/	
How made ...	<u>Forged</u>		
Dimensions ...	<u>5 1/2 - 2 1/2</u>		
Progress on Inspection	<u>Forged & Smoothed</u>		
Date when Inspected	<u>January 27 to February 24/28</u>		

SKETCHES OF FRAMES SHOWING POSITION AND DESCRIPTION OF WELDS OF FORGINGS, OR PARTICULARS OF TESTS APPLIED TO CASTINGS.

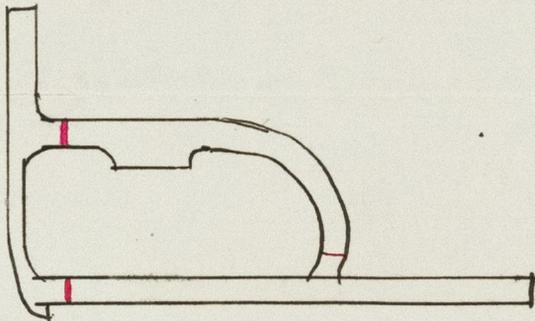

Fee (if any chargeable) £ : :

To be paid at _____



© 2019

Lloyd's Register
Foundation

The words FORGINGS or CASTINGS, IRON or STEEL, should be struck out as may be required.

